IREDELL COUNTY HEALTH DEPARTMENT

STATESVILLE 704-878-5305 MOORESVILL...

IMPROVEMENT PERMIT / AUTHORIZATION TO CONSTRUCT / OPERATION PERMIT / EXISTING SY... ...N

PERMIT# 109584 PIN# ~~4624-27-5705 #1154~~ Const. 4624489812 DA... Jan 29, 03

OWNER OR CONTRACTOR Crescent Konomax (Lot 11 The Point on Norman) K. M. Helvig PHONE: Business ____ Home ____

ADDRESS 2214 Brawley School Rd. Mooresville N.C. 28117

LOCATION Brawley School Rd. TL Torrence Chapel TL Shelburne TL Cape Cod on left just past Hyannis Ct.

SUBDIVISION The Point BLOCK / SECTION 11 LOT 1154 LOT AREA 39,273 sf SITE CLASS PS DESIGN FLOW 480 gpd L.T.A.R. .25

Septic Tank: 1000 Gallons; STB 338 Date 8-23-04

Pump Tank: ____ Gallons; PT ____ Date ____

Pump Make: ____ Model ____ Serial No. ____

Nitrification Field: No Fields 2 Square Feet 1470 Linear Feet 480

No Lines 4@120' Trench Width 36" Max Trench Bottom Depth 36"

☑ New System ☐ Repair System Type: I, II, III, IV, V, VI

System Description: Gravity 25% Reduction LPPPBPS

Repair System Description: ____

Maintenance Agreement Required: ☐ Yes ☑ No initially

Gravel Depth NA

☑ House/Mod. Home ☐ Mobile Home ☐ Business ☐ Other

No. Bedrooms 4 No. Bathrooms 4 No. Employees ____


☐ Slab ☑ Crawl Space ☐ Basement w/plumbing ☐ Basement wo/plumbing

Water Supply: ☐ Individual ☑ ~~Public~~ ☐ Community


Comments:/Conditions:

Comments:/Conditions: 10/11/04 Okayed use of just 1-Dist box Checked Tanks Lines 10/11/04 D-box checked 10/18/04

1"=50' INITIAL SITE SKETCH

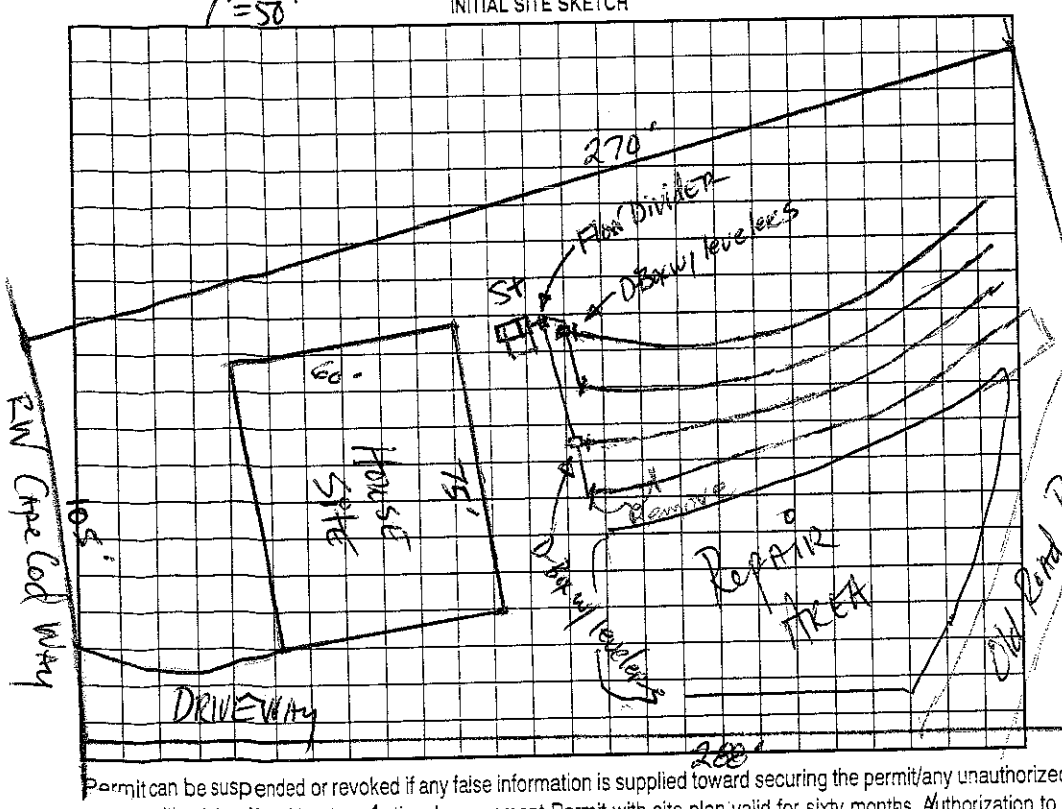

AS BUILT SKETCH

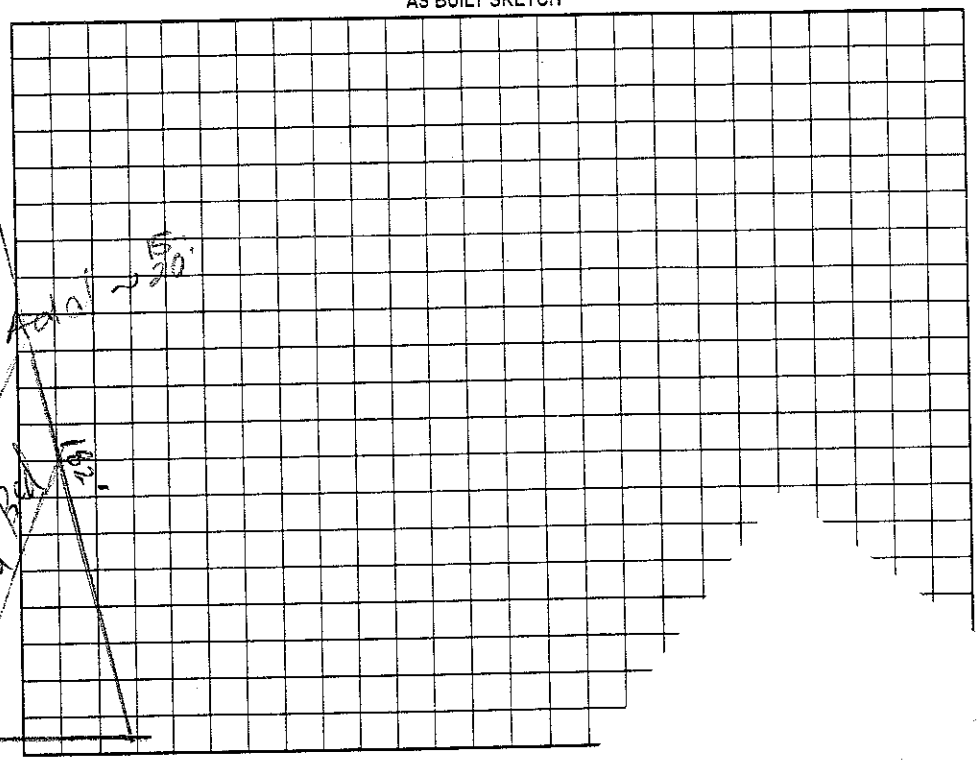

Permit can be suspended or revoked if any false information is supplied toward securing the permit/any unauthorized changes are made to the site/any unauthorized changes are made with plat valid without expiration. Improvement Permit with site plan valid for sixty months. Authorization to Construct is valid for a period equal to that of Improvement Perm...

by: ____ date 1/6/03 Installed by: R & L

by: ____ date Jan 29, 03 Operation Permit by: ____

by: ____ date 6/15/04 Existing System Inspection by: ____

HEALTH DEPT. COPY: WHITE OWNER COPY (FINAL): YELLOW OWNER COPY (INITIAL): PINK