# IREDELL COUNTY HEALTH DEPARTMENT

STATESVILLE 704-878-5305 500.00 Paid MOORESVILLE 704-664-5201

## IMPROVEMENT PERMIT / AUTHORIZATION TO CONSTRUCT / OPERATION PERMIT / EXISTING SYSTEM INSPECTION

PERMIT# 109542 PIN# 4624 27 5705.11 53 4624489938 DATE 7/9/04

OWNER OR CONTRACTOR Life Style Custom Homes PHONE: Business 704-795-1733 Home

ADDRESS 65 McCurdy St. Concord NC. 28027

LOCATION 1100 TL Torrence Chapel TL Shelburne TL Cape Cod on (L) 161 Cape Cod Way

SUBDIVISION Point BLOCK / SECTION 11 LOT 153 LOT AREA 55516 SITE CLASS. PS DESIGN FLOW 600 L.T.A.R. .25 (3)

Septic Tank: 1500 Gallons; STB 338 Date 12/21/04
Pump Tank: 1500 Gallons; PT 477 Date 12/13/04
Pump Make: Goulds Model WE0 3127MA Serial No. #04165-130
Nitrification Field: No Fields 1 Square Feet 1500 Linear Feet 500
No Lines 4@125' Trench Width 3' Max Trench Bottom Depth 3'

☒ New System ☐ Repair System Type: I, II, (III) IV, V, VI
System Description: PresMan — Type 3
Repair System Description: Same Type
Maintenance Agreement Required: ☐ Yes ☒ No
Gravel Depth No ☐ Slab ☒ Crawl Space ☐ Basement w/plumbing ☐ Basement wo/plumbing

☒ House/Mod. Home No. Bedrooms 5
☐ Mobile Home No. Bathrooms 4
☐ Business No. Employees
☐ Other


Water Supply: ☐ Individual ☐ Public ☒ Community

Comments/Conditions:


Comments/Conditions:

(1" = 40')

INITIAL SITE SKETCH

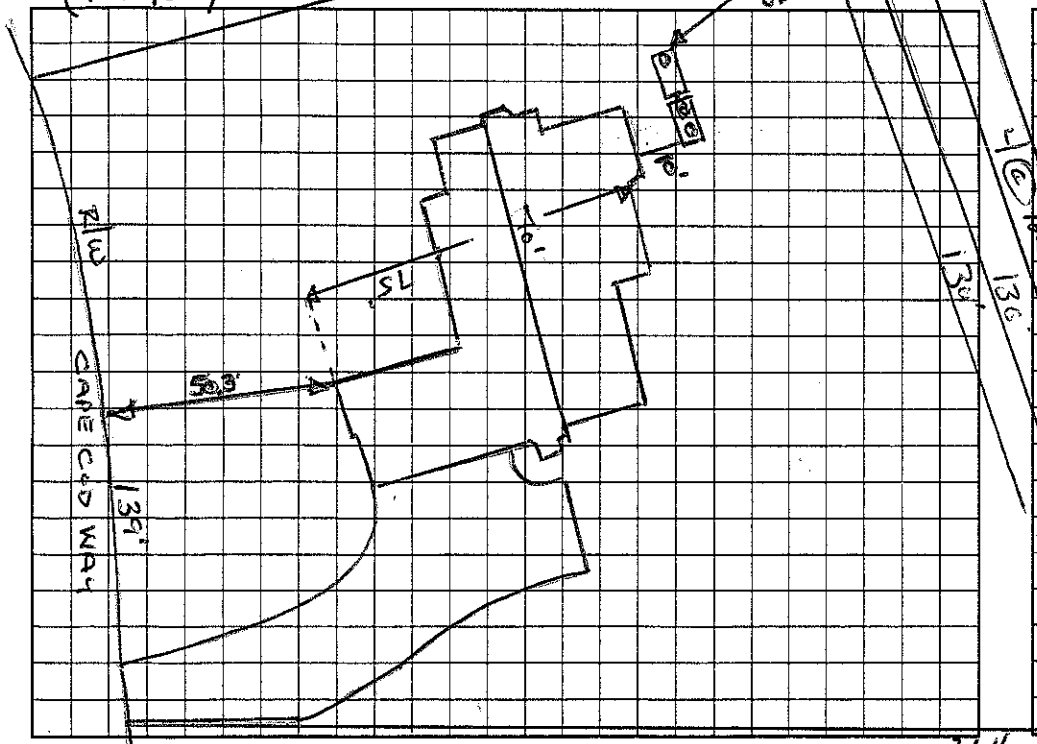


AS BUILT SKETCH

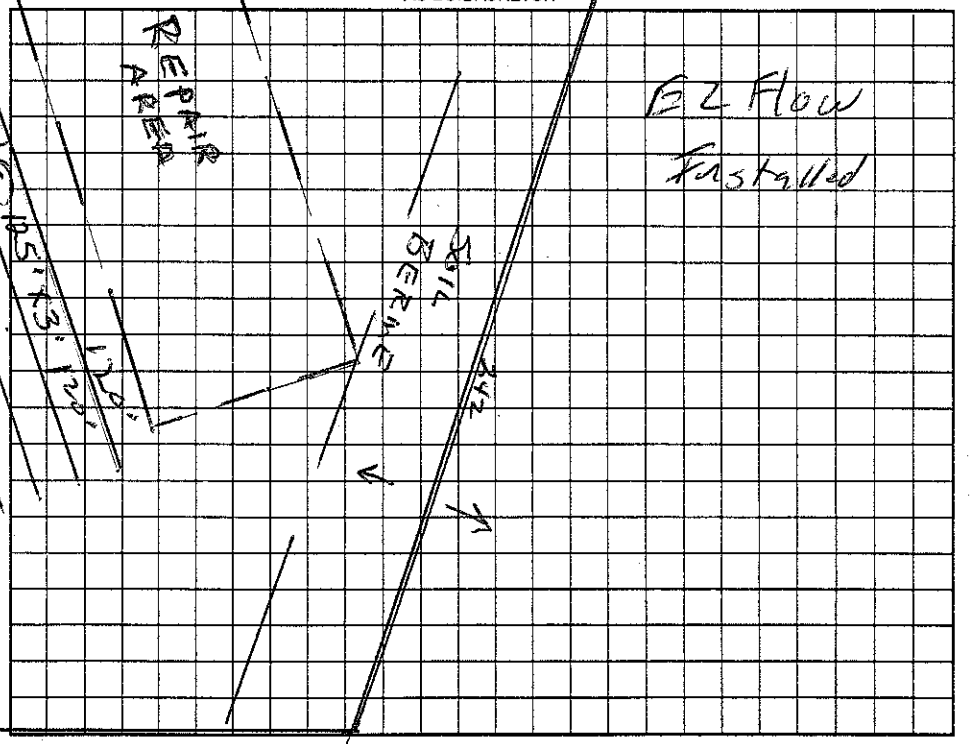


Permit can be suspended or revoked if any false information is supplied toward securing the permit/any unauthorized changes are made to the site/any unauthorized changes are made in the installation of the system. Improvement Permit with plat valid without expiration. Improvement Permit with site plan valid for sixty months. Authorization to Construct is valid for a period equal to that of Improvement Permit – not to exceed sixty months.

Signed: * date 7-12-04 Installed by: Hallman Const

Improvement Permit by: Wesley Sparks RS. date 7/9/04 Operation Permit by: RS date 3/30/05

Authorization to Construct by: Wesley Sparks RS. date 7/9/04 Existing System Inspection by: date

HEALTH DEPT. COPY: WHITE OWNER COPY (FINAL): YELLOW OWNER COPY (INITIAL): PINK