IREDELL COUNTY HEALTH DEPARTMENT

STATESVILLE 704-878-5305 50.00 Paid MOORESVILLE 704-664-5281

IMPROVEMENT PERMIT / AUTHORIZATION TO CONSTRUCT / OPERATION PERMIT / EXISTING SYSTEM INSPECTION

PERMIT# 101247 PIN# 4625-94-1654.841 4624-49-3326 DATE

OWNER OR CONTRACTOR Simmonini Blds. PHONE: Business 704-309-3253 Home

ADDRESS 817 E. Morehead St. Charlotte NC

LOCATION SR, TR Broadsound, TL Grey Lady Ct end

SUBDIVISION The Point BLOCK / SECTION 8 LOT 841 LOT AREA 1.39 AC SITE CLASS. PS DESIGN FLOW 600 L.T.A.R. 0.3

Septic Tank: 1500 Gallons: STB 337 Date 1-26-04

Pump Tank: 1500 Gallons; PT 4XX Date 1-10-04

Pump Make: Myers Model ME50S-21 Serial No.

Nitrification Field: No Fields 1 Square Feet 900 Linear Feet 330

No Lines 4 Trench Width 24"-36" Max Trench Bottom Depth 36" Gravel Depth —

☒ New System ☐ Repair System Type: I, II, III, IV, V, VI

System Description: LP Panel Block

Repair System Description: LP Panel Block

Maintenance Agreement Required: ☒ Yes ☐ No

☒ House/Mod. Home ☐ Mobile Home ☐ Business ☐ Other

No. Bedrooms 3 No. Bathrooms 6 No. Employees

☐ Slab ☐ Crawl Space ☒ Basement w/plumbing ☐ Basement wo/plumbing


Water Supply: ☐ Individual ☐ Public ☒ Community

Comments:/Conditions:


Comments:/Conditions: Lines checked by GM

Tanks, pressure, elect & Alarm checked by MD

INITIAL SITE SKETCH

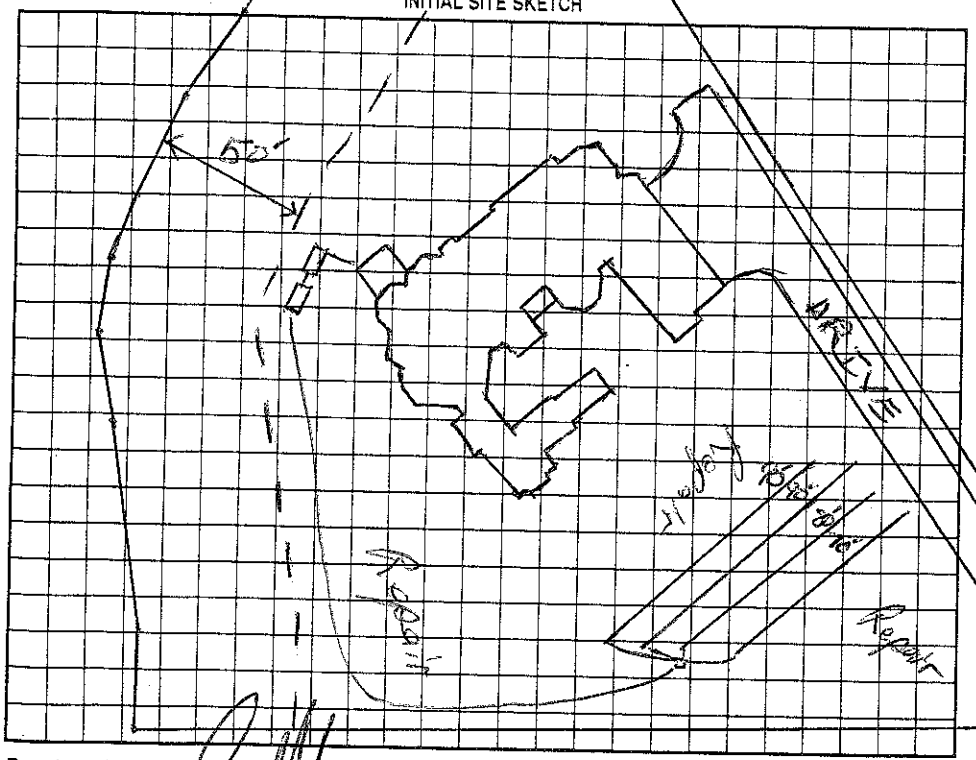

AS BUILT SKETCH

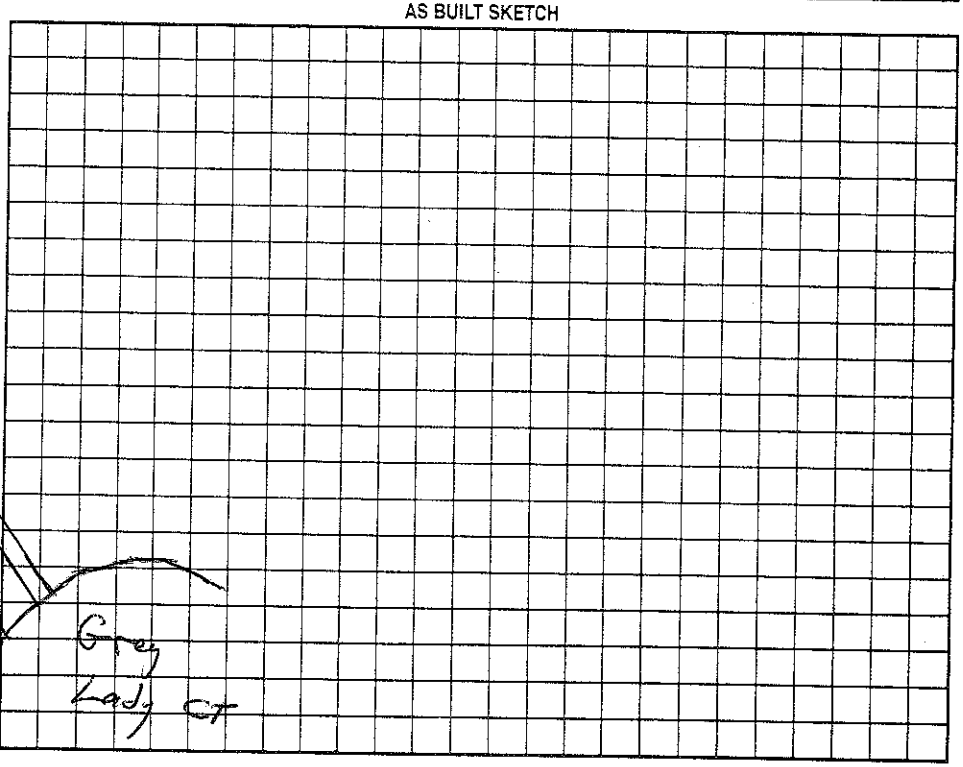

Permit can be suspended or revoked if any false information is supplied toward securing the permit/any unauthorized changes are made to the site/any unauthorized changes are made in the installation of the system. Improvement Permit with plat valid without expiration. Improvement Permit with site plan valid for sixty months. Authorization to Construct is valid for a period equal to that of Improvement Permit – not to exceed sixty months.

Signed: date 5/11/04 Installed by: R+H

Improvement Permit by: RS date 5/10/04 Operation Permit by: RS date 5/21/04

Authorization to Construct by: RS date 5/10/04 Existing System Inspection by: date

HEALTH DEPT. COPY: WHITE OWNER COPY (FINAL): YELLOW OWNER COPY (INITIAL): PINK