IREDELL COUNTY HEALTH DEPARTMENT

STATESVILLE 704-878-5305 MOORESVILLE 704-634-5287

IMPROVEMENT PERMIT / AUTHORIZATION TO CONSTRUCT / OPERATION PERMIT / EXISTING SYSTEM INSPECTION

PERMIT# 101239 PIN# 4675-94-1684.000 4624494854 DATE Oct. 3, 01

OWNER OR CONTRACTOR Crescent Resources, LLC // Brookshire Const. PHONE: Business Home

ADDRESS P.O. Box 1003, Charlotte 28201

LOCATION Brawley Sch Rd. TR Broad Sound Ct. on Right

SUBDIVISION The Point BLOCK / SECTION 8 LOT 833 LOT AREA 40,343 ft² SITE CLASS. RS DESIGN FLOW 460 gpd L.T.A.R. .3

Septic Tank: ~~1000~~ 1500 Gallons; STB 338 Date 6-30-04

Pump Tank: 1000 Gallons; PT 283 Date 7-19-04

Pump Make: Model Serial No.

Nitrification Field: No Fields 1 Square Feet 1200 Linear Feet 400

No Lines 5 @ 80' Trench Width 36" Max Trench Bottom Depth 36" Gravel Depth NA

☑ New System ☐ Repair System Type: I, II, III, IV, V, VI

System Description: PM LP Innovative PBBS

Repair System Description:

Maintenance Agreement Required: ☐ Yes ☑ No initially

☐ Slab ☐ Crawl Space ☑ Basement w/plumbing ☐ Basement wo/plumbing

☑ House/Mod. Home No. Bedrooms 4/4

☐ Mobile Home No. Bathrooms 4/4

☐ Business No. Employees


☐ Other

Water Supply: ☐ Individual ☑ Public ☑ Community

Comments:/Conditions:

INITIAL SITE SKETCH

1" = 50'

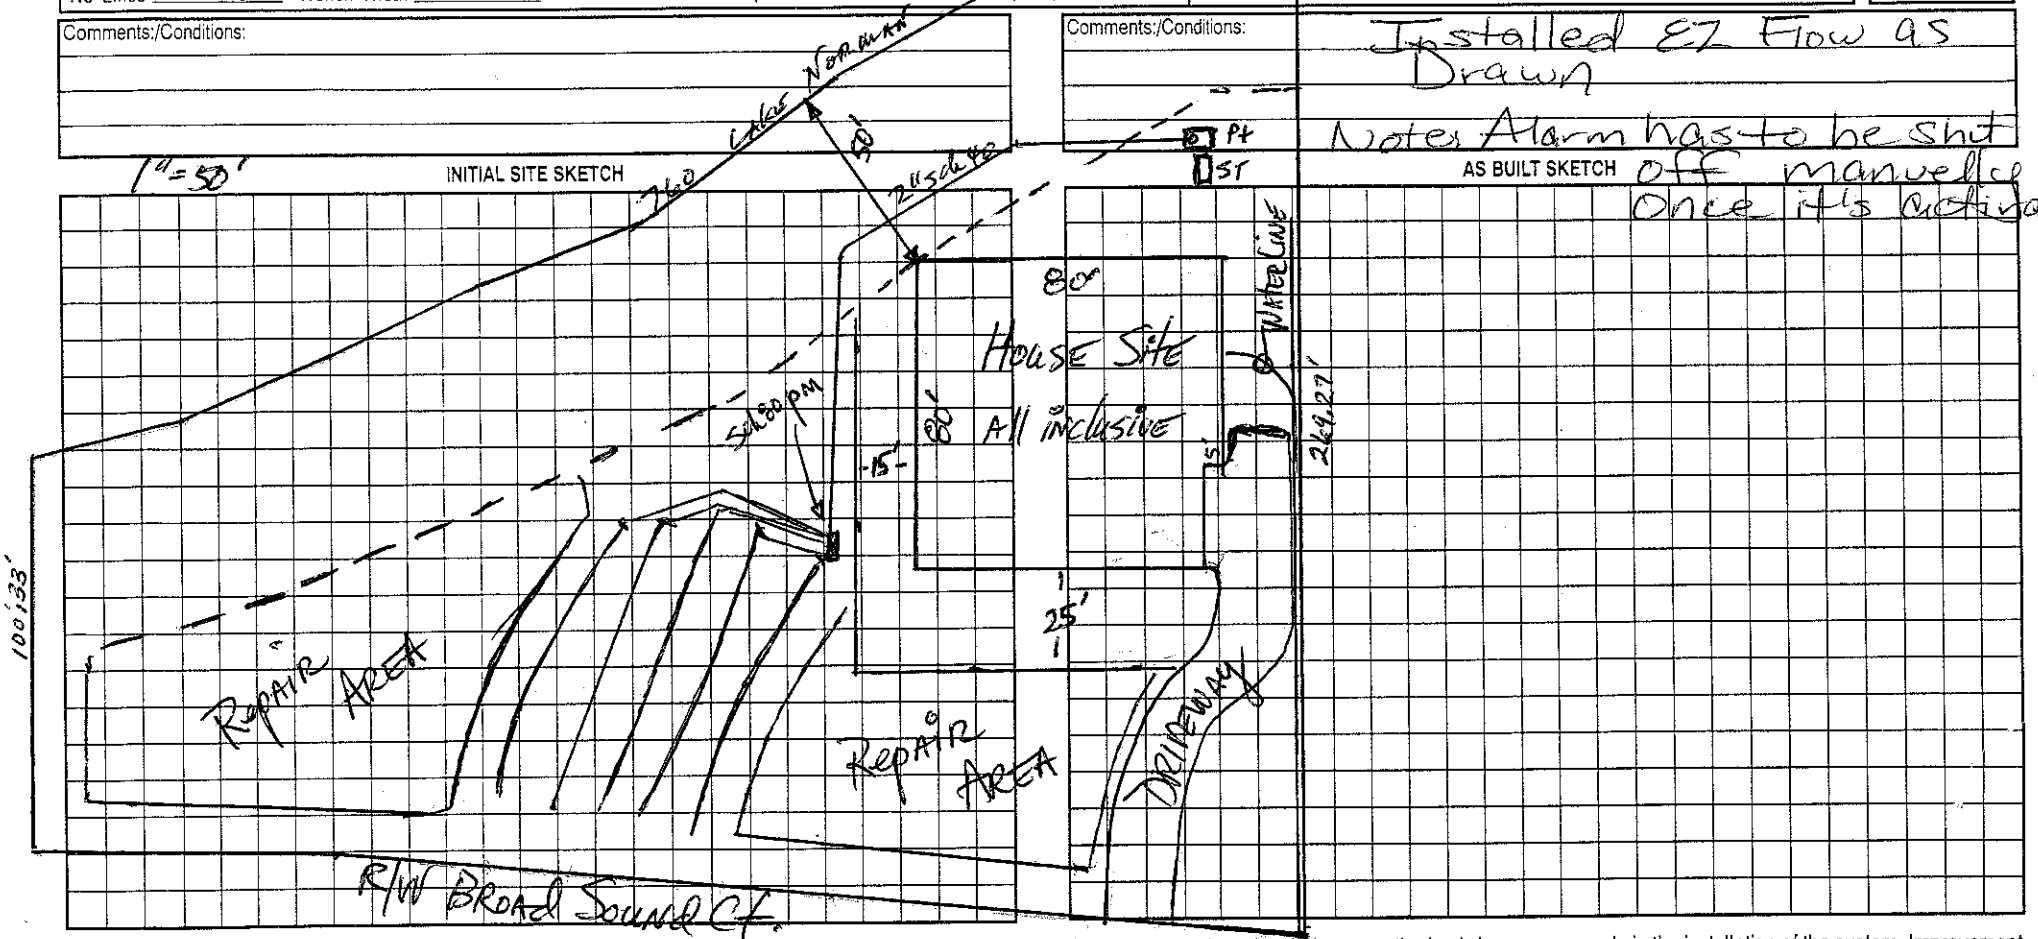

Comments:/Conditions:

Installed EZ Flow as Drawn

Notes Alarm has to be shut off manually once it is activated

AS BUILT SKETCH

Permit can be suspended or revoked if any false information is supplied toward securing the permit/any unauthorized changes are made to the site/any unauthorized changes are made in the installation of the system. Improvement Permit with plat valid without expiration. Improvement Permit with site plan valid for sixty months. Authorization to Construct is valid for a period equal to that of Improvement Permit – not to exceed sixty months.

Signed: date 10/10/01

Improvement Permit by: date 10-3-01

Authorization to Construct by: date 11-5-02

Installed by: RS

Operation Permit by: date 11/9/01

Existing System Inspection by: date

HEALTH DEPT. COPY: WHITE OWNER COPY (FINAL): YELLOW OWNER COPY (INITIAL): PINK