IREDELL COUNTY HEALTH DEPARTMENT

STATESVILLE 704-878-5305 MOORESVILLE 704-664-5281

IMPROVEMENT PERMIT / AUTHORIZATION TO CONSTRUCT / OPERATION PERMIT / EXISTING SYSTEM INSPECTION

2100

PERMIT# 101248 PIN# 4625941684.842 4624-49-5352 DATE 2-3-06

OWNER OR CONTRACTOR Arcadia Homes PHONE: Business 662-6631 Home 201-7181

ADDRESS P.O. Box 471941 Charlotte, NC 28247

LOCATION Brawley School Rd TR Broad Sound Ct TL Grey Lady Ct at end

SUBDIVISION The Point BLOCK / SECTION 8 LOT 842 LOT AREA 57455ft² SITE CLASS PS DESIGN FLOW 600gpd T.A.R. .3

Septic Tank 1500 Gallons; STB ~~3000~~ 444 Date 6-7-06

Pump Tank 1500 Gallons; PT 477 Date 6-18-06

Pump Make: Myers Model ME50 Serial No.

Nitrification Field: No Fields 1 Square Feet 1008 Linear Feet 336'

No Lines 4 @ 84' Trench Width See note Max Trench Bottom Depth 36" Gravel Depth N/A

☒ New System ☐ Repair System Type: I, II, III, IV, V, VI

System Description: Pump-LP- Panel Block

Repair System Description: Same

Maintenance Agreement Required: ☒ Yes ☐ No

☒ House/Mod. Home No. Bedrooms 5

☐ Mobile Home No. Bathrooms

☐ Business No. Employees

☐ Other

☐ Slab ☐ Crawl Space ☒ Basement w/plumbing ☐ Basement wo/plumbing

Water Supply: ☐ Individual ☒ Public ☒ Community


Comments:/Conditions:

* Use trench width Specified in Crescent Communities Handbook PL 269.24'

Comments:/Conditions:

* Must keep pool at least 15ft from Septic System. Keep DrainField at least 25ft from basement.

INITIAL SITE SKETCH

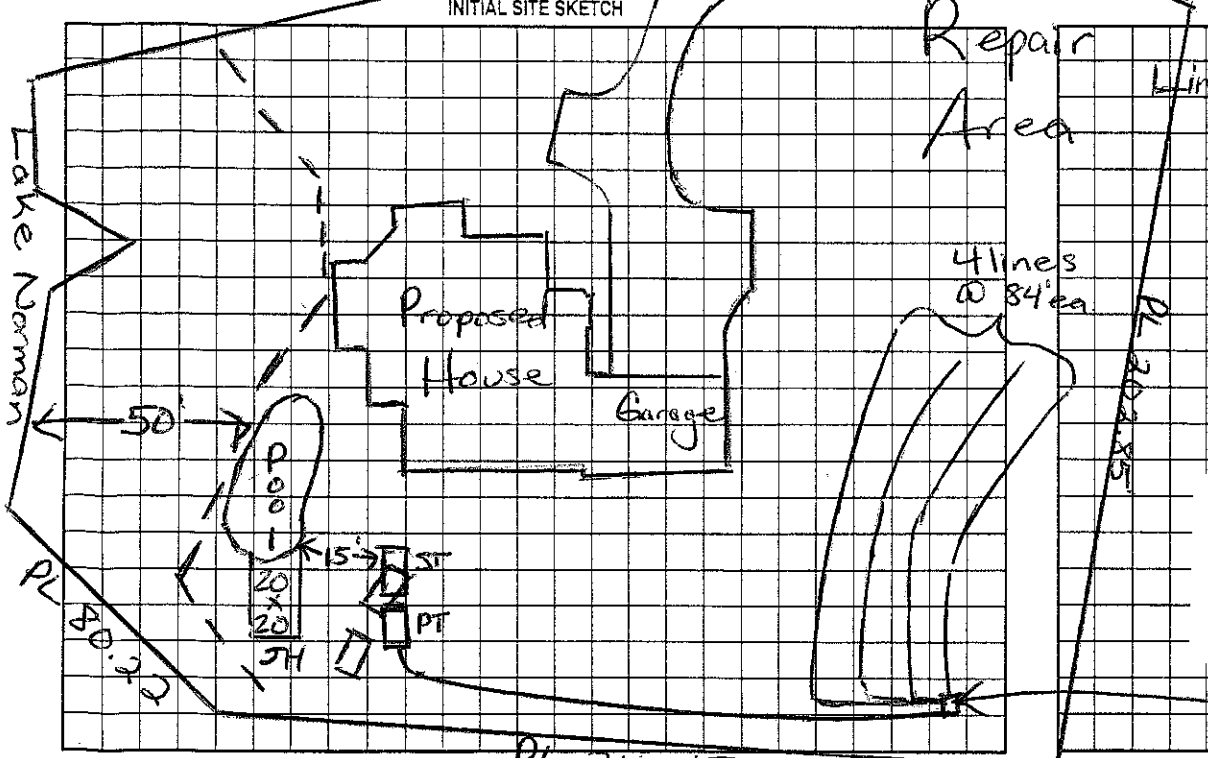

AS BUILT SKETCH

Checked tanks 8/23/06

Lines Installed essentially as Drawn 8/25/0

Central Gate Valve Box

ICHD-Environmental Health Division

The proposed / existing POOL CABANA addition does not appear to impact the existing septic system.

**NOTE:

R.S.

Date: 8-31-09

ICHD-Environmental Health Division

The proposed existing Pool addition does not appear to impact the existing septic system.

**NOTE: Pool was on original Septic permit

Maria H. Dotson R.S.

Date: 9/15/09

ICHD-Environmental Health Division

Permit can be suspended or revoked if any false information is supplied toward securing the permit/any unauthorized changes are made to the site/any unauthorized changes are made in the installation of the system. Improvement Permit with plat valid without expiration. Improvement Permit with site plan valid for sixty months. Authorization to Construct is valid for a period equal to that of Improvement Permit – not to exceed sixty months.

Signed: Jerica D. Thomas date 2/7/06

Improvement Permit by: Maria H. Dotson RS date 2/3/06

Authorization to Construct by: Maria H. Dotson RS date 2/3/06

Installed by: R & H RS

Operation Permit by: Maria H. Dotson date 1/26/07

Existing System Inspection by: date

HEALTH DEPT. COPY: WHITE OWNER COPY (FINAL): YELLOW OWNER COPY (INITIAL): PINK

Pd $ 100.00 1/18/06