3:00

IREDELL COUNTY HEALTH DEPARTMENT

STATESVILLE 704-878-5305 MOORESVILLE 704-664-5281

IMPROVEMENT PERMIT / AUTHORIZATION TO CONSTRUCT / OPERATION PERMIT / EXISTING SYSTEM INSPECTION

PERMIT# 82894 PIN# 4624564552 / 4624546533 DATE 9/8/99

OWNER OR CONTRACTOR EDWARD COLLINS PHONE: Business Home 664-2439

ADDRESS 258 TORRENCE CHAPEL RD.

LOCATION BRAWLEY SCHOOL - TL TORRENCE CHAPEL - AT ENO (COLD MECK MELK)

SUBDIVISION BLOCK / SECTION LOT 1 LOT AREA 1.44AC SITE CLASS. 2S DESIGN FLOW 450 L.T.A.R. .3

Septic Tank: 1000 Gallons; STB 1012 Date 2/19/00

Pump Tank: Gallons; PT Date

Pump Make: Model Serial No.

Nitrification Field: No Fields 1 Square Feet 1000 Linear Feet 400

No Lines 3@133' Trench Width 36" Max Trench Bottom Depth 36" Gravel Depth N/A

☑ New System ☐ Repair System Type: I, II, III, IV, V, VI

System Description: GRAVITY 25% REDUCTION

Repair System Description: PUMP SAME

Maintenance Agreement Required: ☐ Yes ☑ No

☑ House/Mod. Home No. Bedrooms 4

☐ Mobile Home No. Bathrooms 4

☐ Business No. Employees

☐ Other


☐ Slab ☑ Crawl Space ☐ Basement w/plumbing ☐ Basement wo/plumbing

Water Supply: ☑ Individual ☐ Public ☐ Community

Comments:/Conditions:

Comments:/Conditions:

INITIAL SITE SKETCH

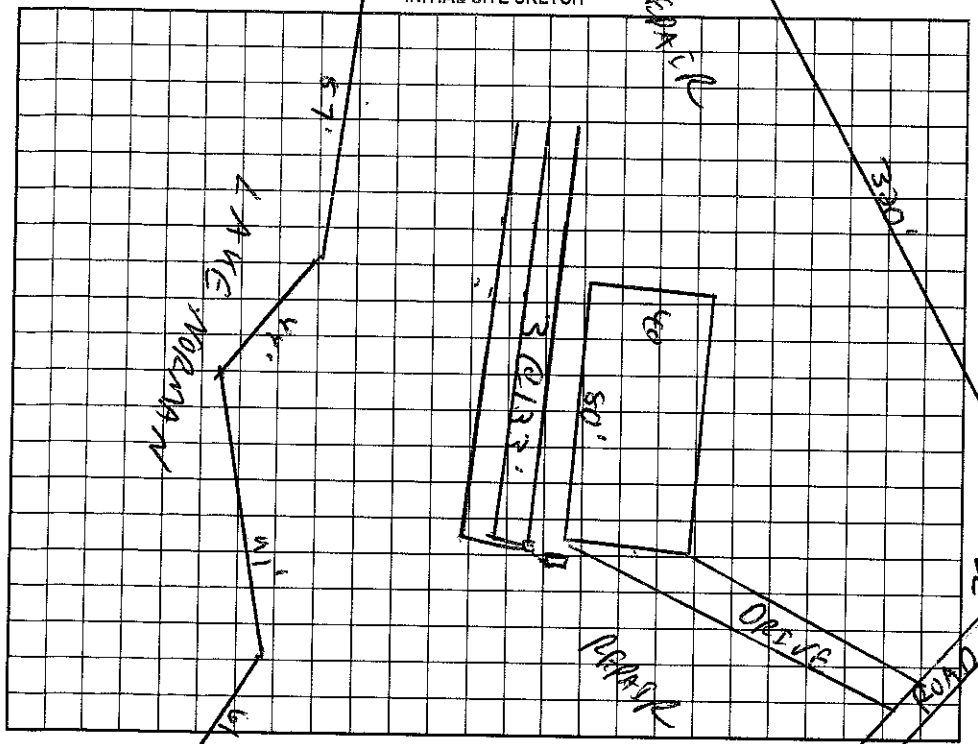

AS BUILT SKETCH

Permit can be suspended or revoked if any false information is supplied toward securing the permit/any unauthorized changes are made to the site/any unauthorized changes are made in the installation of the system. Improvement Permit with plat valid without expiration. Improvement Permit with site plan valid for sixty months. Authorization to Construct is valid for a period equal to that of Improvement Permit – not to exceed sixty months.

Signed: Dave R Collins date 9-10-99 Installed by: Richard Abernathy

Improvement Permit by: [signature] RS date 9/8/99 Operation Permit by: Wesley Sparks RS date 6/23/00

Authorization to Construct by: [signature] RS date 9/8/99 Existing System Inspection by: date

HEALTH DEPT. COPY: WHITE OWNER COPY (FINAL): YELLOW OWNER COPY (INITIAL): PINK