IREDELL COUNTY HEALTH DEPARTMENT

STATESVILLE 704-878-5305 MOORESVILLE 704-664-5281

IMPROVEMENT PERMIT / AUTHORIZATION TO CONSTRUCT / OPERATION PERMIT / EXISTING SYSTEM INSPECT

PERMIT# 109605 PIN# 4624-27-5705 4624570848 DATE March 5, 03

OWNER OR CONTRACTOR Crescent Resources/The Point on Norman PHONE: Business 1442 Home

ADDRESS 2214 Brawley Sch Rd. Mooresville N.C. 28117

LOCATION Brawley Sch Rd. TL Torrence Chapel SFE on Right; Lt on left 161 Torrence Chapel Rd

SUBDIVISION The Point BLOCK / SECTION 11 LOT 1160/1160A LOT AREA 45106 ft² + 22465 ft² SITE CLASS PS SFE DESIGN FLOW 480gpd L.T.A.R. .3 SFE 1180A

Septic Tank: 1000 Gallons; STB 338 Date 12-28-04

Pump Tank: 1000 Gallons; PT 2 Date 12-31-04

Pump Make: Goulds Model WE0712HD Serial No.

Nitrification Field: No Fields 1 Square Feet 1200 Linear Feet 400

No Lines 3 Trench Width 36" Max Trench Bottom Depth 36" Gravel Depth N/A

☑ New System ☐ Repair System Type: I, II, III, IV, V, VI

System Description: On- 25% Reduction on SFE 1180A

Repair System Description: On Lt 25% Reduction on 1180A

Maintenance Agreement Required: ☐ Yes ☑ No

☑ House/Mod. Home No. Bedrooms 4

☐ Mobile Home No. Bathrooms 4

☐ Business No. Employees

☐ Other

☐ Slab ☑ Crawl Space ☐ Basement w/plumbing ☐ Basement wo/plumbing


Water Supply: ☐ Individual ☑ Public ☑ Community

Comments:/Conditions: Reviewed Building plans & site plans; in Compliance with permit.

Comments:/Conditions:

1"=100'

INITIAL SITE SKETCH

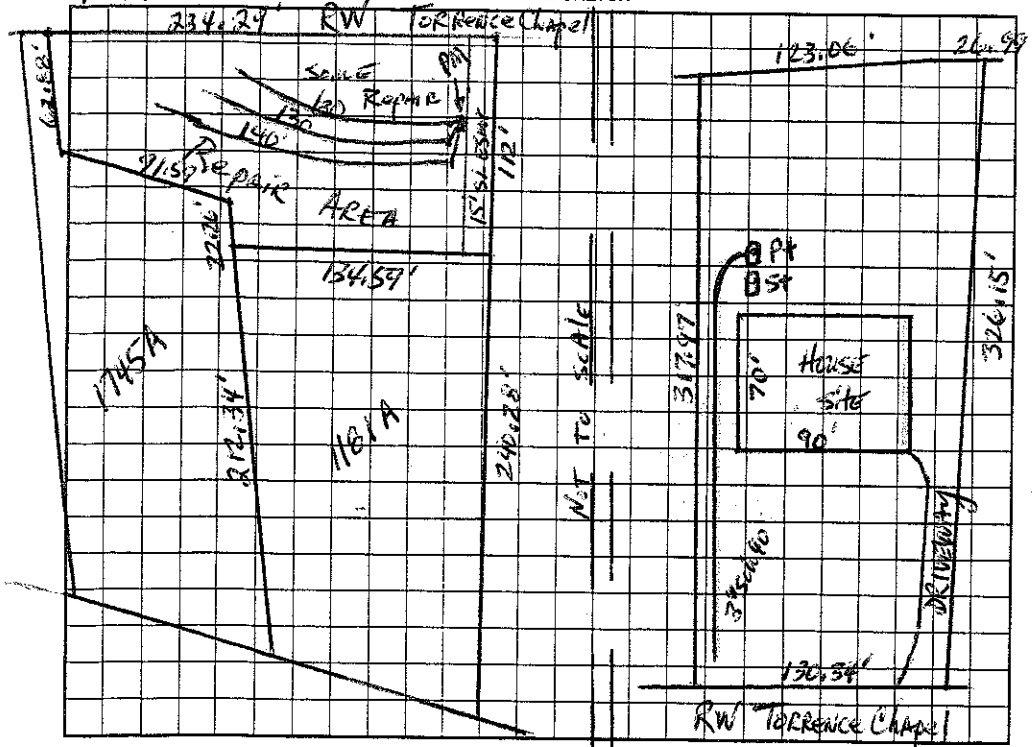

AS BUILT SKETCH

Installed EL Flow For Drainfield

Permit can be suspended or revoked if any false information is supplied toward securing the permit/any unauthorized changes are made to the site/any unauthorized changes are made in the installation of the system. Improvement Permit with plat valid without expiration. Improvement Permit with site plan valid for sixty months. Authorization to Construct is valid for a period equal to that of Improvement Permit – not to exceed sixty months.

Signed: date 3/5/03 Installed by: Bobby Mayhew RS

Improvement Permit by: Randy Lyons RS date 3-5-03 Operation Permit by: Maina H. Dotson RS date 3/18/05

Authorization to Construct by: Maina H. Dotson RS date 10 Existing System Inspection by: date

HEALTH DEPT. COPY: WHITE OWNER COPY (FINAL): YELLOW OWNER COPY (INITIAL): PINK