2:00

IREDELL COUNTY HEALTH DEPARTMENT

STATESVILLE 704-878-5305 MOORESVILLE 704-664-5281

IMPROVEMENT PERMIT / AUTHORIZATION TO CONSTRUCT / OPERATION PERMIT / EXISTING SYSTEM INSPECTION

PERMIT# 109614 PIN# ~~4624-27-5705~~ 4624-57-1890 DATE Feb 6, 03

OWNER OR CONTRACTOR Crescent Resources Inc // The Point on Norman / Beazer Homes PHONE: Business _____ Home _____

ADDRESS 7214 Brawley Sch Rd. Mooresville, N.C. 28117

LOCATION Brawley Sch Rd. TL Torrence Chapel on left just before int. w/ Shelburne

SUBDIVISION The Point BLOCK / SECTION II LOT 1174 LOT AREA 61,736 ~~72~~ SITE CLASS. RS DESIGN FLOW 480gpd L.T.A.R. .3

Septic Tank: 1000 Gallons; STB 338 Date 10-29-04

Pump Tank: 1000 Gallons; PT 283 Date 10-30-04

Pump Make: Myers Model ME 50 Serial No 2532500

Nitrification Field: No Fields 1 Square Feet 540/810 Linear Feet 270

No Lines 5 Trench Width 24" min 8'oc Max Trench Bottom Depth 36" Gravel Depth NA

☑ New System ☐ Repair System Type: I. II. III. IV. V. VI

System Description: LPPBPS

Repair System Description: LPPBPS

Maintenance Agreement Required: ☑ Yes ☐ No

☑ House/Mod. Home No. Bedrooms 4

☐ Mobile Home No. Bathrooms 4

☐ Business No. Employees _____

☐ Other _____


☐ Slab ☑ Crawl Space ☐ Basement w/plumbing ☐ Basement wo/plumbing

Water Supply: ☐ Individual ~~☐ Public~~ ☑ Community


Comments:/Conditions: OR 36" max 9'oc

Comments:/Conditions: 4-55' lines
1-50' Upper
Checked tanks & lines 12/3/04

INITIAL SITE SKETCH 326' 1"=50'

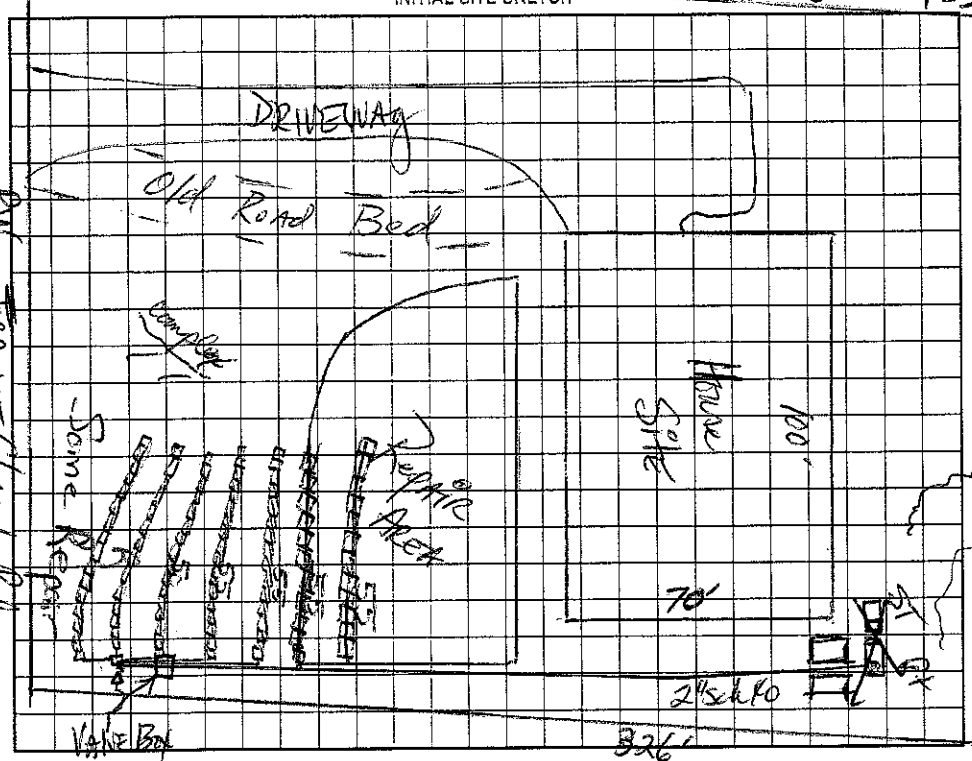

AS BUILT SKETCH

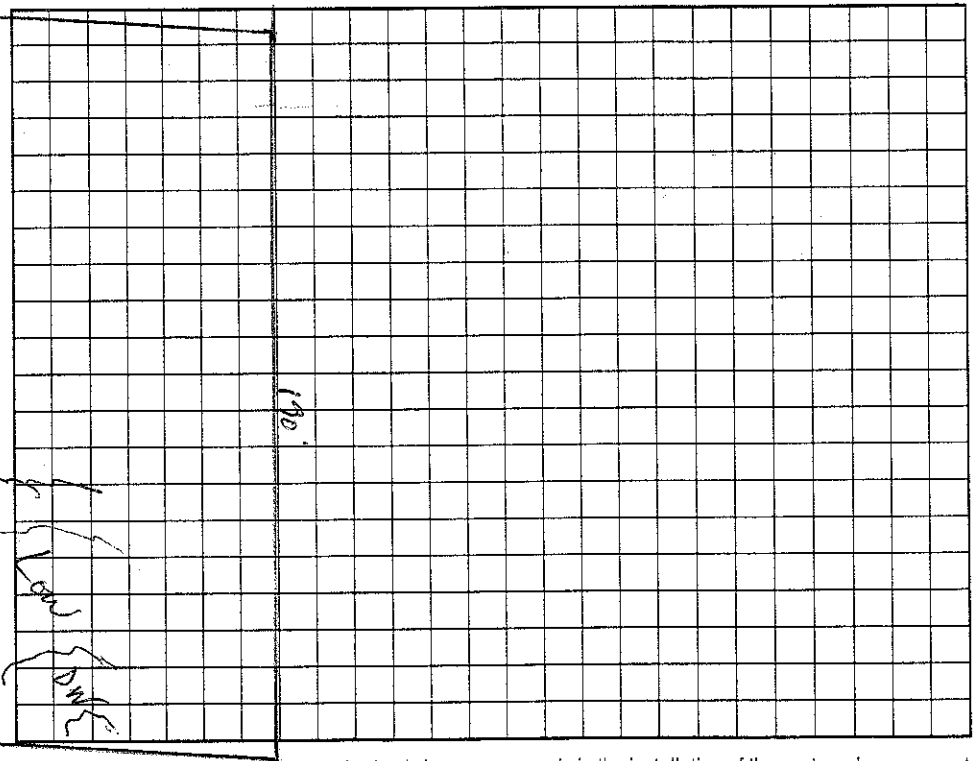

Permit can be suspended or revoked if any false information is supplied toward securing the permit/any unauthorized changes are made to the site/any unauthorized changes are made in the installation of the system. Improvement Permit with plat valid without expiration. Improvement Permit with site plan valid for sixty months. Authorization to Construct is valid for a period equal to that of Improvement Permit – not to exceed sixty months.

Signed: _____ date 2/18/03 Installed by: R & H RS

Improvement Permit by: _____ RS date 2-6-03 Operation Permit by: Marvin H Dotson date 2/10/05

Authorization to Construct by: Wendy Sparks RS date 4/27/04 Existing System Inspection by: _____ date _____

HEALTH DEPT. COPY: WHITE OWNER COPY (FINAL): YELLOW OWNER COPY (INITIAL): PINK