4624573753 300

IREDELL COUNTY HEALTH DEPARTMENT

STATESVILLE 704-878-5305 MOORESVILLE 704-664-5281

IMPROVEMENT PERMIT / AUTHORIZATION TO CONSTRUCT / OPERATION PERMIT / EXISTING SYSTEM INSPECTION

PERMIT# 109603 PIN# 4624275705.1178 Mike Lynn DATE 7-2-07

OWNER OR APPLICANT Kenneth Bealer Homes PHONE: Business 363-1 6183 Home 662-6402

ADDRESS P.O. Box 3398, Mooresville, NC

LOCATION Brawley School Rd TL Torrence Chapel TL Shelburne 1st lot on left 179

SUBDIVISION The Point BLOCK / SECTION 11 LOT 1178 LOT AREA 52,963 SITE CLASS. PS DESIGN FLOW 480gpd L.T.A.R. .3

Septic Tank: 1000+ Gallons: STB 444 Date 6-9-07

Pump Tank: 1000 Gallons: PT 6411-07 Date 2-7

Pump Make Goulds Model WE0327M10 No.

Nitrification Field: No Fields 1 Square Feet 1200 Linear Feet 400

No Lines 4 @ 100' Trench Width 36" Max Trench Bottom Depth 36 Gravel Depth N/A ☐ Gravity ☐ Pressure ☐ Slab ☒ Crawl Space ☐ Basement w/plumbing ☐ Basement wo/plumbing

☒ New System ☐ Repair ☐ Expansion System Type: I II III IV V VI

System Description: Pump-PM-25% Reduction

Repair System Description: Pump-LP-50% Reduction

Maintenance Agreement Required: ☐ Yes ☐ No

☒ House/Mod. ~~Home~~ ☐ Mobile Home ☐ Business ☐ Other


No. Bedrooms 4 No. Persons ___ No. Employees ___

Water Supply: ☐ Individual ☐ Public ☒ Community


Comments:/Conditions:

Comments:/Conditions: 7/17/07 Checked tanks & lines 8/24/07 Elect, alarm & pressure

Scale 1:50 INITIAL SITE SKETCH

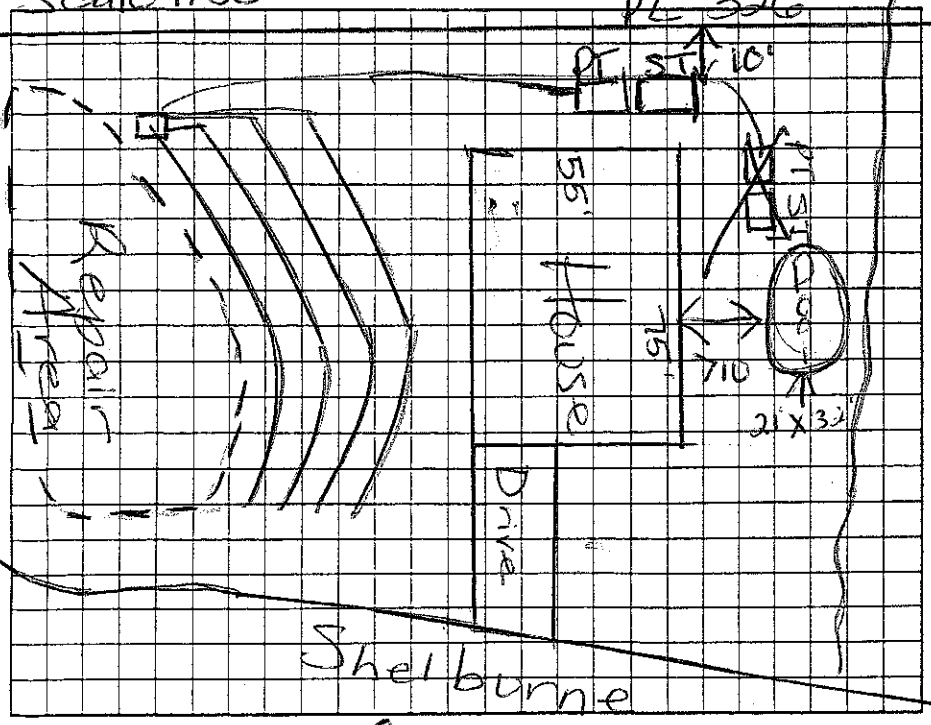

AS BUILT SKETCH

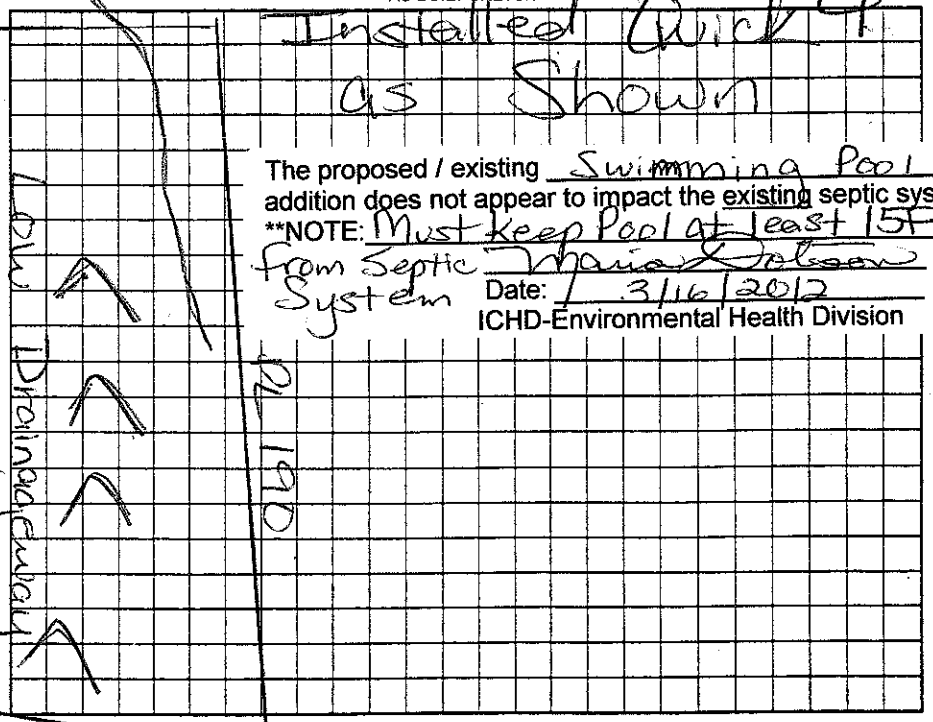

The proposed / existing Swimming Pool addition does not appear to impact the existing septic system.

**NOTE: Must keep Pool at least 15ft from Septic System

Maria H. Dolson R.S.

Date: 3/16/2012

ICHD-Environmental Health Division

Permit can be suspended or revoked if any false information is supplied toward securing the permit/any unauthorized changes are made to the site/any unauthorized changes are made in the installation of the system. Improvement Permit with plat valid without expiration ☐ Improvement Permit with site plan valid for sixty months ☐ Authorization to Construct is valid for a period equal to that of Improvement Permit – not to exceed sixty months.

Signed: Mike Lynn date 7/9/07 Installed by: R & H Dolson RS date

Improvement Permit by: Maria H. Dolson RS date 7/5/07 Operation Permit by: Maria H. Dolson RS date 8/24/07

Authorization to Construct by: Maria H. Dolson RS date 7/5/07 Existing System Inspection by: ___ date ___

HEALTH DEPT. COPY: WHITE OWNER COPY (FINAL): YELLOW OWNER COPY (INITIAL): PINK