IREDELL COUNTY HEALTH DEPARTMENT

Statesville Office (704) 878-5305 Mooresville Office (704) 660-3625 PERMIT # 206133

IMPROVEMENT PERMIT / AUTHORIZATION TO CONSTRUCT / OPERATION PERMIT / EXISTING SYSTEM

PIN # 4624575968

APPLICANT: Passarelli Homes APPLICANT ADDRESS: PO Box 2190 Cornelius NC 28081

SITE ADDRESS: 111 Cape Cod Way - Mooresville, NC PHONE: 7047285641 ALT. PHONE:

SITE DIRECTIONS: Brawley School Rd TL Torrence Chapel TL Shelburne TL Cape Cod lot lot on left

SUBDIVISION: The Point on Norman SECTION: 11 LOT # 1140 LOT AREA: DESIGN FLOW: 600 gpd L.T.A.R.: .3

Septic Tank	1500 (gal)	STB	338	Date	12-26-14	☒ New System ☐ Repair ☐ Expansion	System Type: I II III IV V VI	☒ Residence	No. Bedrooms 5
Pump Tank	(gal)	PT		Date		System Description:	Gravity - 25% Reduction	☐ Business	No. Persons 10
Pump Make		Model		Serial #		Repair System Description:	Same	☐ Other	No. Employees
# Nitrification Fields	1	# Lines	5	Linear Ft:	500Ft	Maintenance Agreement Required:	☐ YES ☒ NO	☐ Slab	☒ Crawl Space
Trench Width	36"	Max. Trench Bottom Depth	36"	Gravel Depth	N/A		☒ GRAVITY ☐ PRESSURE	☐ Basement w/ plumbing	☐ Basement w/o plumbing


Water Supply: ☐ Private ☒ Public ☒ Community

Comments / Conditions:


Scale 1:50

Stub out plumbing high to maintain gravity flow to Septic tank (ST) Drainfield 40' from House

INITIAL SITE SKETCH

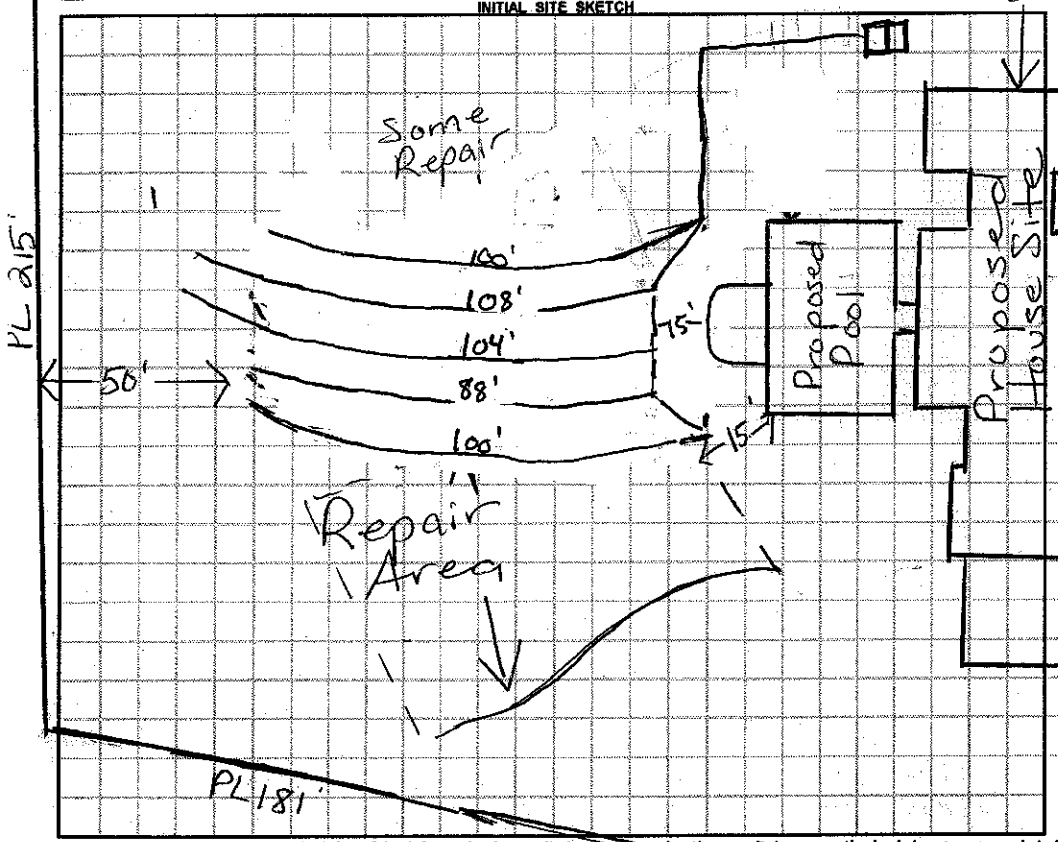

AS BUILT SKETCH

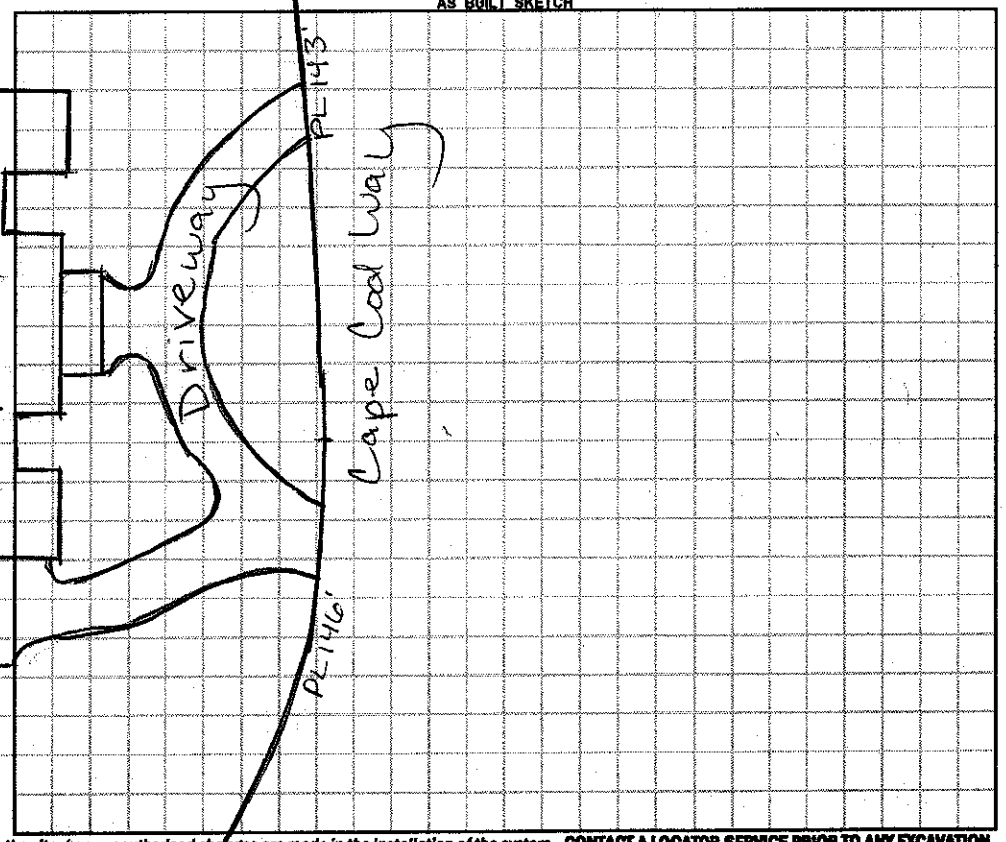

Permit can be suspended or revoked if any false information is supplied toward securing the permit / any unauthorized changes are made to the site / any unauthorized changes are made in the installation of the system. **CONTACT A LOCATOR SERVICE PRIOR TO ANY EXCAVATION**

☐ **IMPROVEMENT PERMIT** *with plot valid without expiration.* ☒ **IMPROVEMENT PERMIT** *with site plan valid for 60 mos.* ☒ **AUTHORIZATION TO CONSTRUCT** *valid for period equal to IMPROVEMENT PERMIT--not to exceed 60 mo.*

Owner / Applicant Signature: Date: 1/9/15 Installed by:

IMPROVEMENT PERMIT by: RS Date: 11/17/14 OPERATION PERMIT by: APPROVED MAR 26 2015 Date:

AUTHORIZATION TO CONSTRUCT by: RS Date: 11/17/14 Existing System Inspected by: Date:

Health Dept. Copy - WHITE Applicant (Final Approval) - YELLOW Applicant (Conditional Approval) - PINK