IREDELL COUNTY HEALTH DEPARTMENT

STATESVILLE 704-878-5305 MOORESVILLE 704-664-5281

IMPROVEMENT PERMIT / AUTHORIZATION TO CONSTRUCT / OPERATION PERMIT / EXISTING SYSTEM INSPECTION

1130

PERMIT# 109512 PIN# ~~4624-27-5905~~ 4624-57-6656 DATE Feb 12, 03

OWNER OR CONTRACTOR Crescent Resources, LLC / The Point Partnership PHONE: Business 7442 Home

ADDRESS 2214 Brawley Sch Rd. Mooresville N.C. 28117

LOCATION Brawley Sch Rd. TL Torrence Chapel TL Shelburne Place 2nd lot on Right

SUBDIVISION The Point BLOCK / SECTION II LOT 1114 LOT AREA 1.56 ac SITE CLASS. PS DESIGN FLOW 460gpd L.T.A.R. 0.25

Septic Tank: 1000 Gallons; STB 335 Date 5-14-05

Pump Tank: 1000 Gallons; P.T 27 Date 6-2-05

Pump Make: Goulds Model 512H Serial No. F0563917

Nitrification Field: No. Fields 1 Square Feet 640/960 Linear Feet 320

No Lines 4 Trench Width 24" min @ 6" or 36" max 6" Max Trench Bottom Depth 36" Gravel Depth NA

☑ New System ☐ Repair System Type: I. II. III. IV. V. VI

System Description: LPP BPS

Repair System Description: LPP BPS

Maintenance Agreement Required: ☑ Yes ☐ No

☑ House/Mod. Home No. Bedrooms 4

☐ Mobile Home No. Bathrooms 4

☐ Business No. Employees

☐ Other

☐ Slab ☑ Crawl Space ☐ Basement w/plumbing ☐ Basement wo/plumbing


Water Supply: ☐ Individual ☑ Public ☑ Community

Comments/Conditions: RW Shelburne Place 317.83'


Comments/Conditions: Reviewed plans & site plan; essentially in Compliance with I.P. Checked lines 7/8/05 MD

Checked pressure, elect & alarm

INITIAL SITE SKETCH

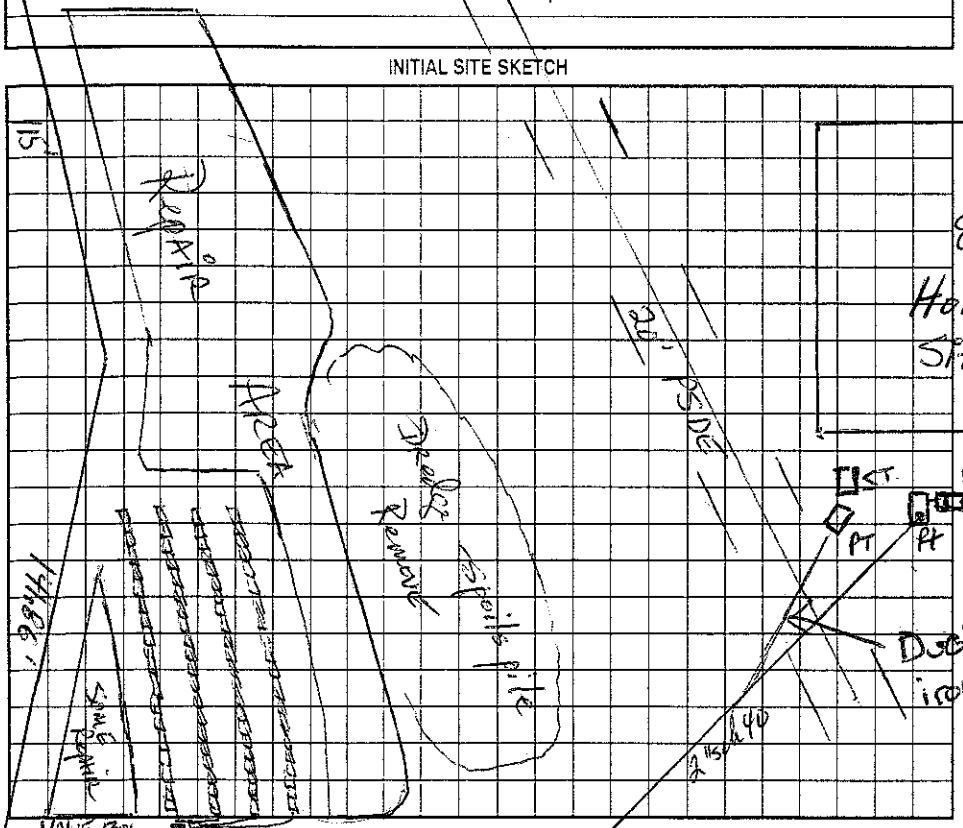

AS BUILT SKETCH

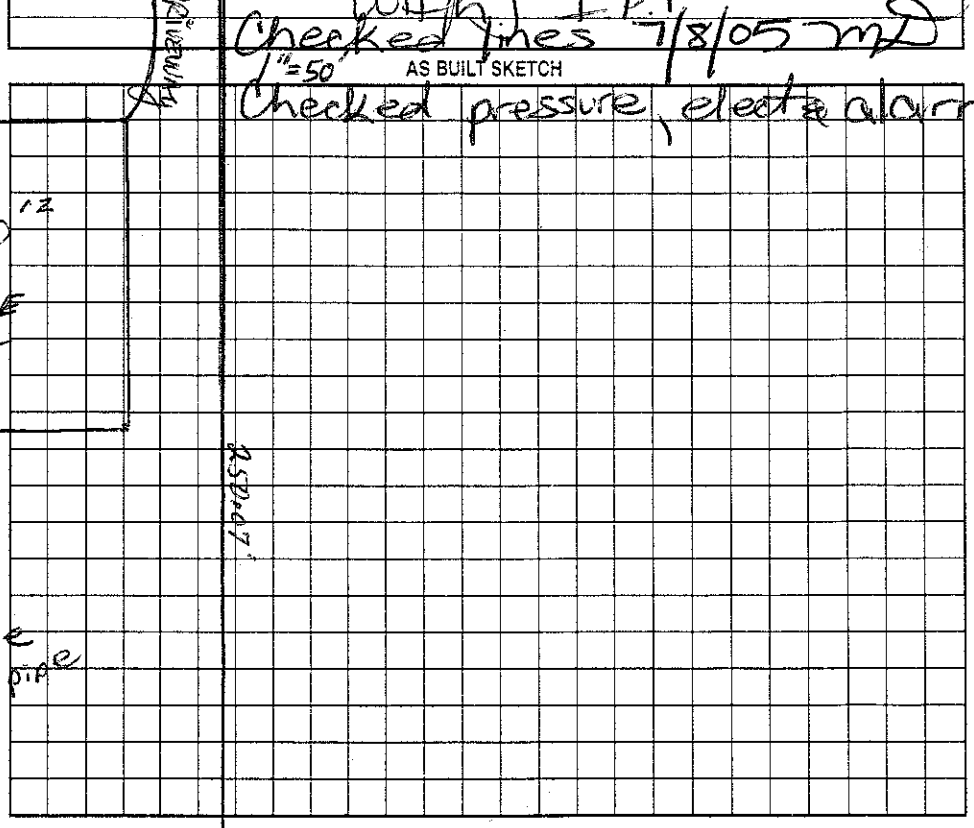

Permit can be suspended or revoked if any false information is supplied toward securing the permit/any unauthorized changes are made to the site/any unauthorized changes are made in the installation of the system. Improvement Permit with plat valid without expiration. Improvement Permit with site plan valid for sixty months. Authorization to Construct is valid for a period equal to that of Improvement Permit – not to exceed sixty months.

Signed: RW Courtney date 2/18/03 Installed by: Bobby Mayhew

Improvement Permit by: date 2-10-03 Operation Permit by: Maria H. Dotson RS date 9/20/05

Authorization to Construct by: Maria H. Dotson RS date 11/17/04 Existing System Inspection by: date

HEALTH DEPT. COPY: WHITE OWNER COPY (FINAL): YELLOW OWNER COPY (INITIAL): PINK