IREDELL COUNTY HEALTH DEPARTMENT

STATESVILLE 704-878-5305 MOORESVILLE 704-664-5281

IMPROVEMENT PERMIT / AUTHORIZATION TO CONSTRUCT / OPERATION PERMIT / EXISTING SYSTEM INSPECTION

1130

PERMIT# 10951Z PIN# 4624-27-5905.1114 4624-57-6656 DATE Feb 12, 03

OWNER OR CONTRACTOR Crescent Resources, LLC / The Houston Agency 1117 PHONE: Business _____ Home _____

ADDRESS 2214 Brawley Sch Rd. Mooresville, N.C. 28117

LOCATION Brawley Sch Rd. TL Torrence Chapel TL Shelburne Place 2nd Lot on Right

SUBDIVISION The Point BLOCK / SECTION II LOT 1114 LOT AREA 1.56 ac SITE CLASS. P5 DESIGN FLOW 480gpd L.T.A.R. .25

Septic Tank: 1000 Gallons; STB 338 Date 5-14-05
Pump Tank: 1000 Gallons; PT 27 Date 6-2-05
Pump Make: Goulds Model 512H Serial No. F0563917
Nitrification Field: No. Fields 1 Square Feet 640/960 Linear Feet 320
No Lines 4 Trench Width 24" min @ 0c or 36" min @ oc Max Trench Bottom Depth 36" Gravel Depth N/A

☑ New System ☐ Repair System Type: I. II. III. IV. V. VI
System Description: LPPPBPS
Repair System Description: LPPPBPS
Maintenance Agreement Required: ☑ Yes ☐ No


☑ House/Mod. Home No. Bedrooms 4
☐ Mobile Home No. Bathrooms 4
☐ Business No. Employees _____
☐ Other _____

☐ Slab ☑ Crawl Space ☐ Basement w/plumbing ☐ Basement wo/plumbing

Water Supply: ☐ Individual ☑ Public ☐ Community

Comments/Conditions: RW Shelburne Place 317.83'


INITIAL SITE SKETCH

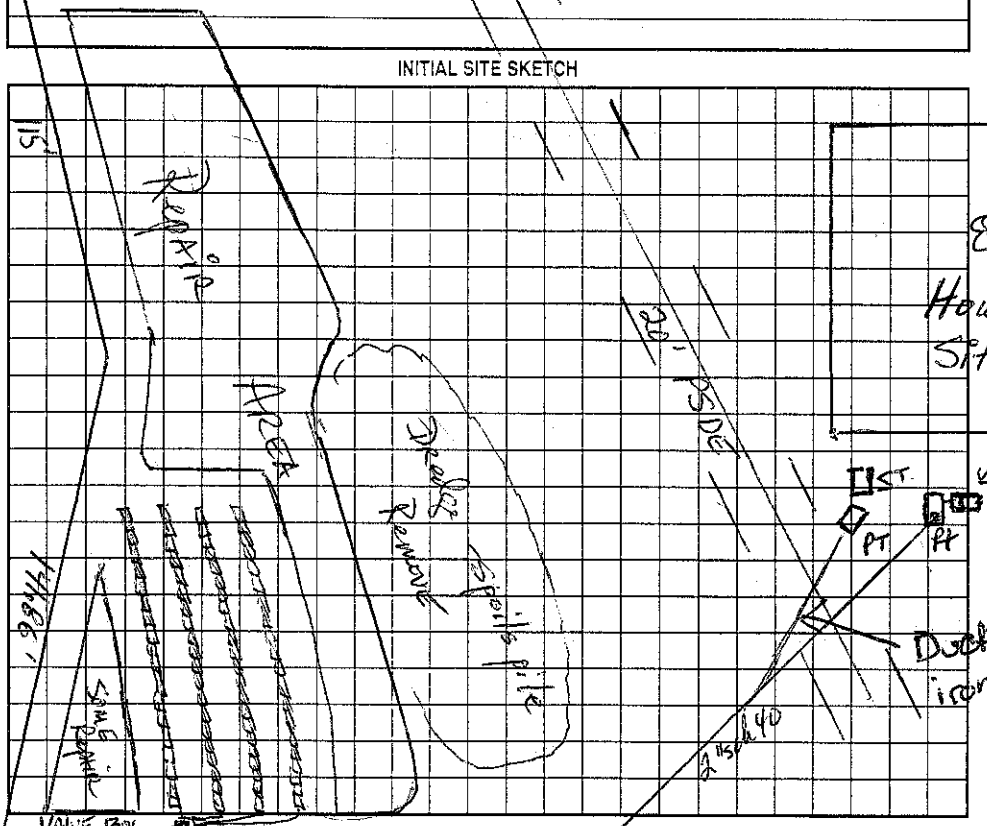

Comments/Conditions: Reviewed plans & site plan; essentially in Compliance with I.P. Checked lines 7/8/05 MD

AS BUILT SKETCH

1"=50'

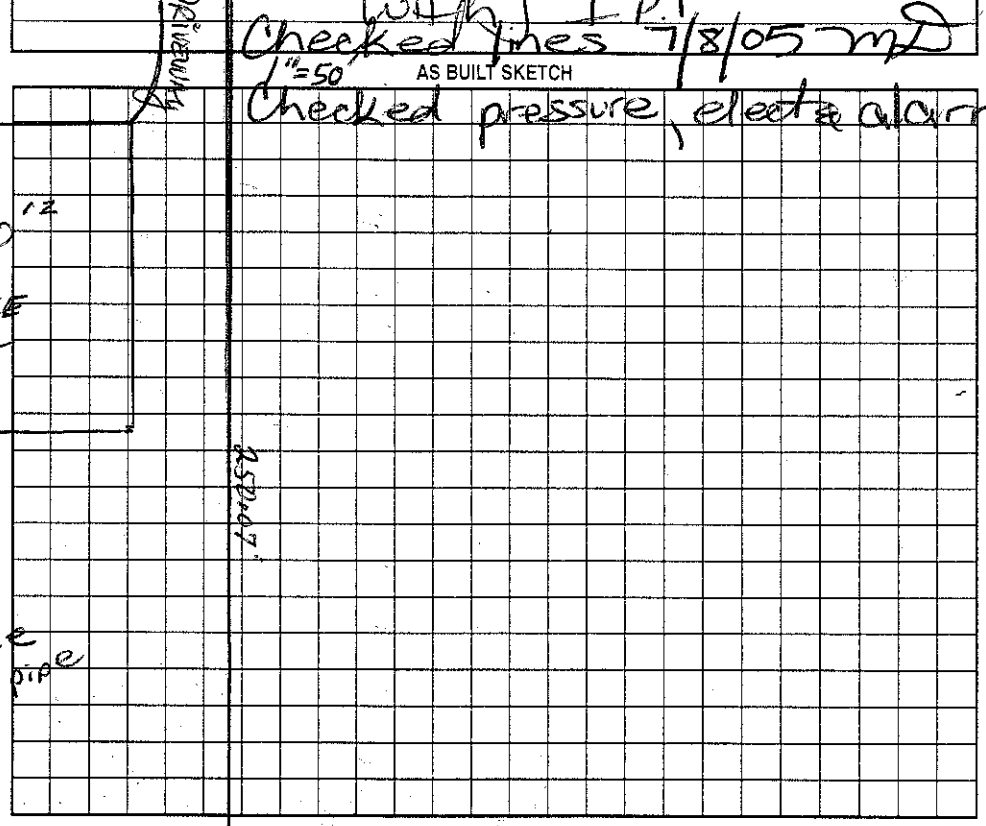

Permit can be suspended or revoked if any false information is supplied toward securing the permit/any unauthorized changes are made to the site/any unauthorized changes are made in the installation of the system. Improvement Permit with plat valid without expiration. Improvement Permit with site plan valid for sixty months. Authorization to Construct is valid for a period equal to that of Improvement Permit – not to exceed sixty months.

Signed: _____ 322.56 RW Greyrock date 2/10/03 Installed by: Bobby Mayhew LS

Improvement Permit by: _____ date 2-10-03 Operation Permit by: _____ date 9/20/05

Authorization to Construct by: _____ date 4/7/05

Existing System Inspection by: _____ date _____