IREDELL COUNTY HEALTH DEPARTMENT

STATESVILLE 704-878-5305 MOORESVILLE 704-664-5281

IMPROVEMENT PERMIT / AUTHORIZATION TO CONSTRUCT / OPERATION PERMIT / EXISTING SYSTEM INSPECTION

PERMIT# 108682/125452 PIN# 4624275905 DATE 9-19-05

OWNER OR CONTRACTOR Whitley & Co. PHONE: Business _____ Home _____

ADDRESS _____

LOCATION Brawley School Rd TL Torrence Chapel TL Shellbarge TL Cape Cod on right

SUBDIVISION The Point BLOCK / SECTION 11 LOT 1137 LOT AREA 42,284 sf SITE CLASS. PS DESIGN FLOW 480 gpd L.T.A.R. .53

Septic Tank: 1500 Gallons; STB 338 Date 8-12-05
Pump Tank: 1000 Gallons; PT 283 Date 8-12-05
Pump Make: Myers Model _____ Serial No. _____
Nitrification Field: No Fields 1 Square Feet 1200 Linear Feet 400
No Lines 6 Trench Width 36" Max Trench Bottom Depth 36" Gravel Depth N/A

☒ New System ☐ Repair System Type: I, II, III, IV, V, VI
System Description: Pump - PM - 25% Reduction
Repair System Description: LP - Panel Block
Maintenance Agreement Required: ☐ Yes ☐ No


☒ House/Mod. Home ☐ Mobile Home ☐ Business ☐ Other
No. Bedrooms 4 No. Bathrooms 4 No. Employees _____
☒ Slab ☐ Crawl Space ☒ Basement w/plumbing ☐ Basement wo/plumbing

Water Supply: ☐ Individual ☒ Public ☒ Community


Comments:/Conditions:

Comments:/Conditions: Installed EZ Flow Tanks & lines Checked 9/15/05

Scale 1:50 INITIAL SITE SKETCH

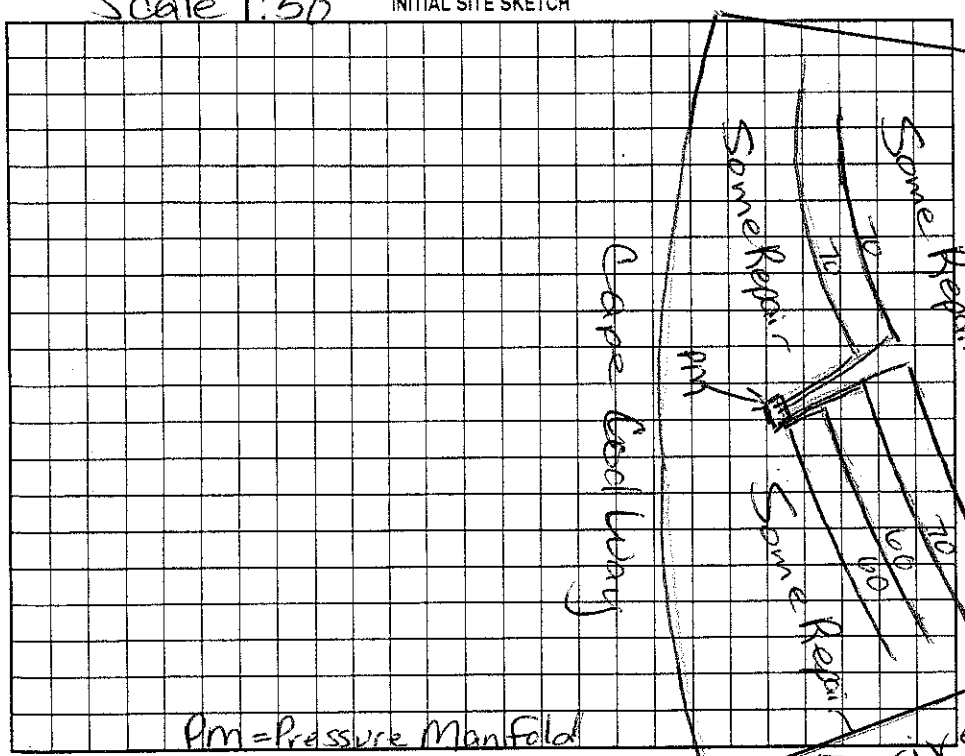

AS BUILT SKETCH

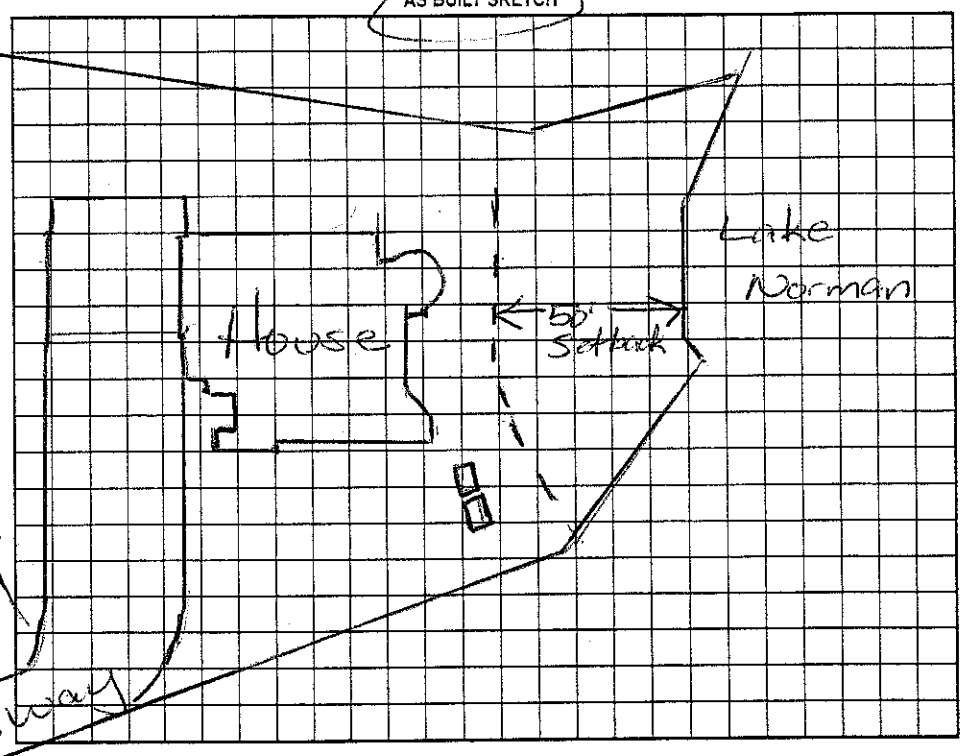

Permit can be suspended or revoked if any false information is supplied toward securing the permit/any unauthorized changes are made to the site/any unauthorized changes are made in the installation of the system. Improvement Permit with plat valid without expiration. Improvement Permit with site plan valid for sixty months. Authorization to Construct is valid for a period equal to that of Improvement Permit – not to exceed sixty months.

Signed: _____ date _____

Improvement Permit by: _____ date _____

Authorization to Construct by: _____ date _____

Installed by: R & H

Operation Permit by: [signature] date 9/26/05

Existing System Inspection by: _____ date _____

HEALTH DEPT. COPY: WHITE OWNER COPY (FINAL): YELLOW OWNER COPY (INITIAL): PINK