IREDELL COUNTY HEALTH DEPARTMENT

STATESVILLE 704-878-5305 MOORESVILLE 704-664-5281

IMPROVEMENT PERMIT / AUTHORIZATION TO CONSTRUCT / OPERATION PERMIT / EXISTING SYSTEM INSPECT

PERMIT# 108682 ~~123462~~ PIN# 4624-27-5905 . 1137 4624582645 DATE Nov 12, 02

OWNER OR CONTRACTOR The Point/Norman / Crescent Resources Inc. / ~~Brookshire~~ PHONE Business Whitley Home

ADDRESS 2219 Brawley Sch Rd. Mooresville, N.C.

LOCATION Brawley Sch Rd. TL Torrence Chapel TL Shelburne TL Cape Cod on Right

SUBDIVISION The Point BLOCK / SECTION 11 LOT 1137 LOT AREA 42,287 ft² SITE CLASS. PS DESIGN FLOW 480 gpd L.T.A.R. .3 initial / .25 upper Repair Area

Septic Tank: 1000 Gallons; STB 338 Date 8-12-05
Pump Tank: 1000 Gallons; PT 283 Date 8-12-05
Pump Make: Myers Model ME505-21 Serial No. 25327
Nitrification Field: No Fields 1 Square Feet 1200 Linear Feet 400
No Lines 6 Trench Width 36" Max Trench Bottom Depth 36" Gravel Depth NA

☑ New System ☐ Repair System Type: I, II, (III), IV, V, VI
System Description: PM- Centerfed 25% Reduction
Repair System Description: LPPPBPS
Maintenance Agreement Required: ☐ Yes ☑ No initially

☑ House/Mod. Home No. Bedrooms 4
☐ Mobile Home No. Bathrooms 4
☐ Business No. Employees
☐ Other


☑ Slab ☑ Crawl Space ☑ Basement w/plumbing ☐ Basement wo/plumbing

Water Supply:
☐ Individual
☑ Public
☑ Community

Comments:/Conditions:

Comments:/Conditions: Installed (partial) tanks & lines, Checked 9/15/05
Used EZ Flow

INITIAL SITE SKETCH 1"=50'

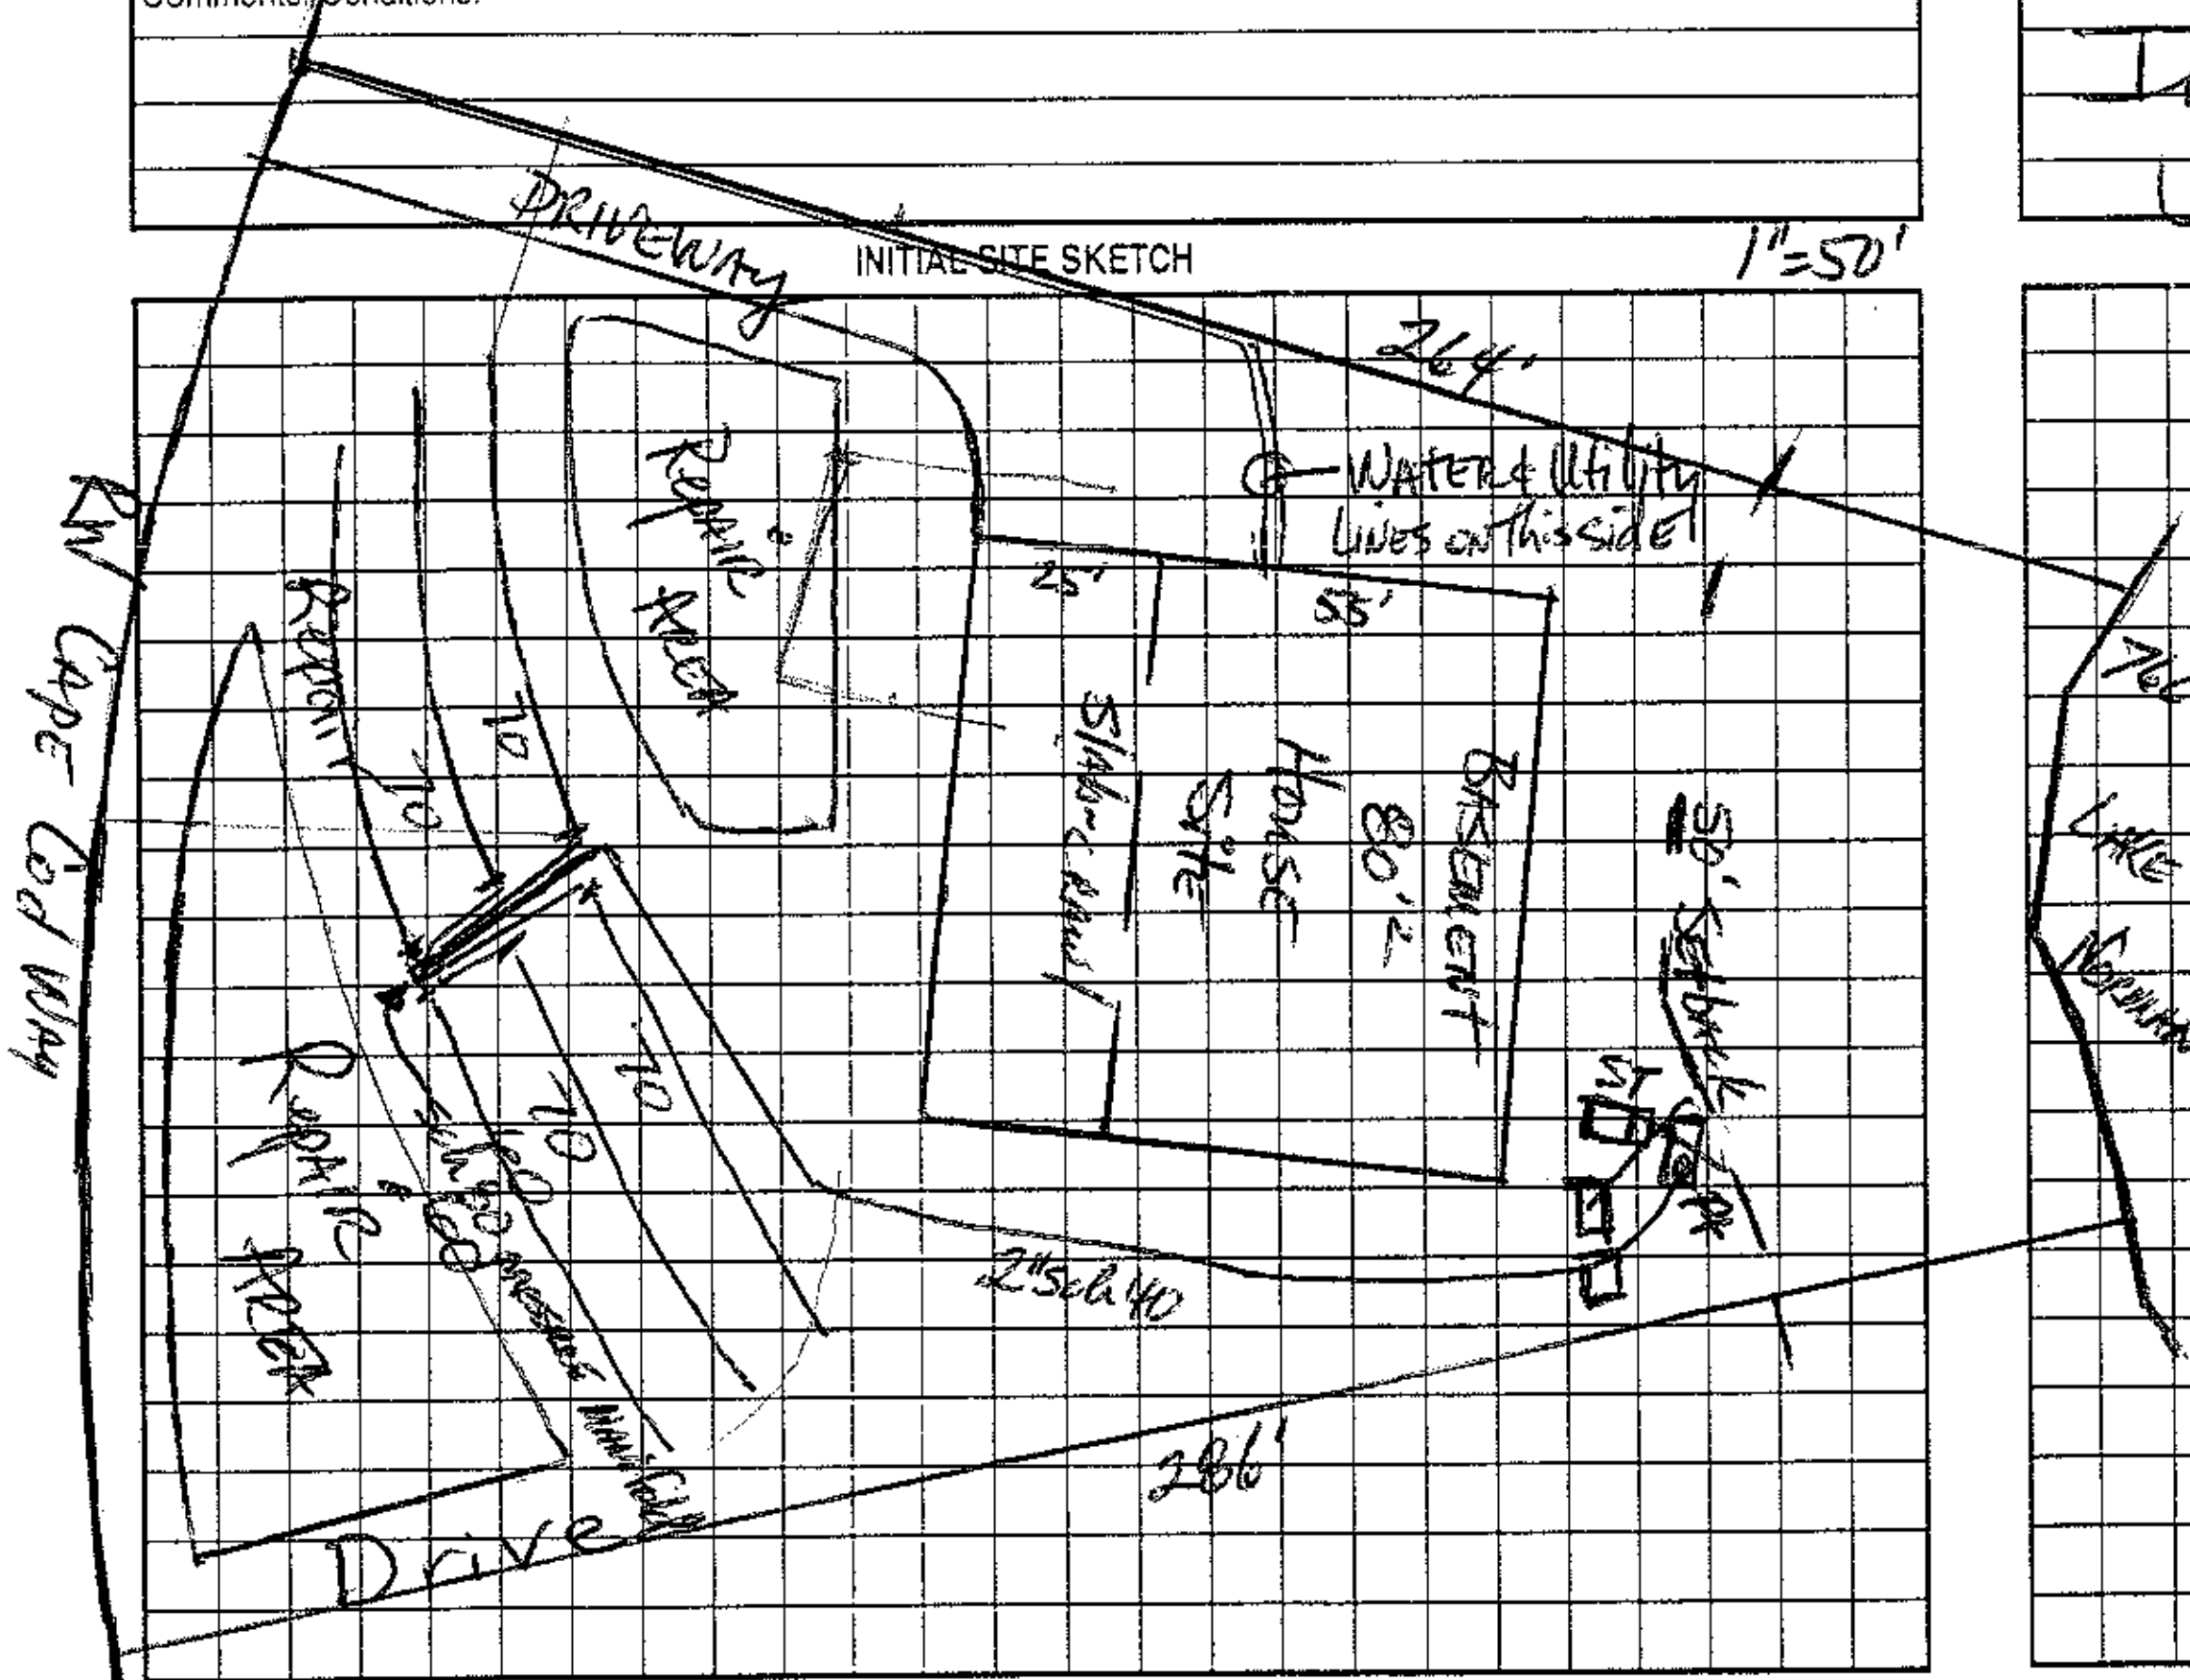

AS BUILT SKETCH

See "As Built" Sketch attached

Permit can be suspended or revoked if any false information is supplied toward securing the permit/any unauthorized changes are made to the site/any unauthorized changes are made in the installation of the system. Improvement Permit with plat valid without expiration. Improvement Permit with site plan valid for sixty months. Authorization to Construct is valid for a period equal to that of Improvement Permit – not to exceed sixty months.

Signed: [signature] RS date 11/17/02
Improvement Permit by: [signature] RS date 11-12-02
Authorization to Construct by: [signature] RS date 6/3/03

Installed by: R & H
Operation Permit by: [signature] RS date 9/26/05
Existing System Inspection by: date

HEALTH DEPT. COPY: WHITE OWNER COPY (FINAL): YELLOW OWNER COPY (INITIAL): PINK