IREDELL COUNTY HEALTH DEPARTMENT

STATESVILLE 878-5305 MOORESVILLE 704-664-5281

IMPROVEMENT PERMIT / AUTHORIZATION TO CONSTRUCT / OPERATION PERMIT / EXISTING SYSTEM INSPECTION

PERMIT # 157112 PIN # 4624-58-2984 DATE 9-28-09

OWNER or APPLICANT BRIAN WEST PHONE: Business 704-6666-6630 Home:

OWNER or APPLICANT ADDRESS 570 WILLIAMSON RD SUITE E MVILLE 28117

LOCATION / DIRECTIONS BSR, TL TORRENCE CHAPEL, TL SHELBORNE, TL CAPE COD ON R

SUBDIVISION THE POINT BLOCK / SECTION 11 LOT # 1139 LOT AREA DESIGN FLOW 600 L.T.A.R. .25-.3

Septic Tank 1500 EXT Gallons: STB 338 Date 10-3-03
Pump Tank 1500 Gallons: PT 477 Date 2-5-09
Pump Make Myers Model ME75 Serial #
Nitrification Field No. Fields 1 No. Lines 7 Linear Feet 400'
Trench Width 24-36" Max. Trench Bottom Depth 36" Gravel Depth SAND

☐ New System ☐ Repair ☒ Expansion System Type I II III (IV) V VI
System Description: LP- PANEL BLOCK
Repair System Description: SAME
Maintenance Agreement Required ☒ YES ☐ NO
☐ GRAVITY ☒ PRESSURE


☒ Residence No. Bedrooms 5
☐ Business No. Persons
☐ Other No. Employees
☒ Slab ☒ Crawl Space
☒ Basement w/plumbing ☐ Basement w/o plumbing

Water Supply: ☐ Private ☐ Public ☒ Community


Comments / Conditions 1) INSTALL 2 NEW LINES (48' + 32') AS SHOWN
2) INSTALL 1500 GAL PT
3) MAINTAIN ALL SET BACKS

Comments / Conditions 9/30/09 Checked additional lines
1/26/2010 Ext Pressure Sat.

INITIAL SITE SKETCH

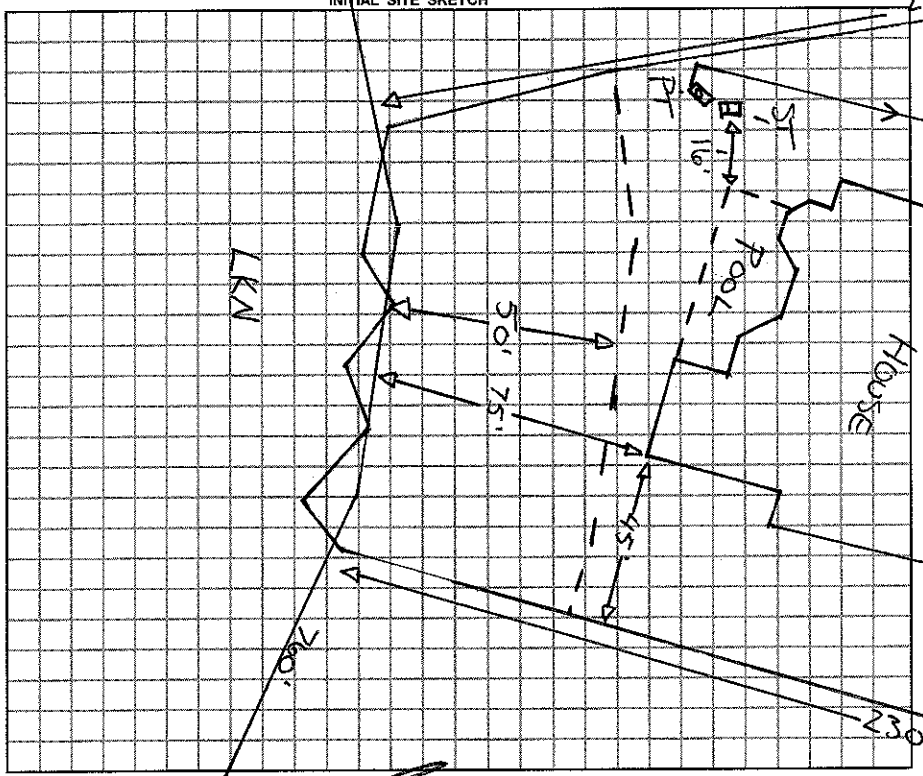

AS BUILT SKETCH

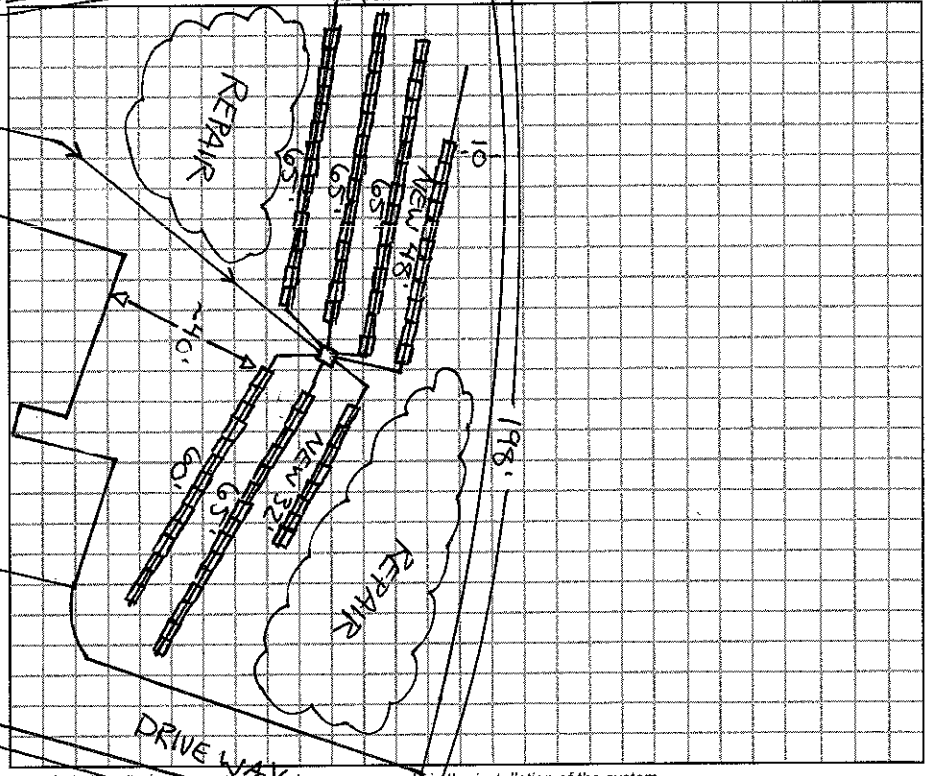

Permit can be suspended or revoked if any false information is supplied toward securing the permit / any unauthorized changes are made to the site / any unauthorized changes are made in the installation of the system.

☐ *IMPROVEMENT PERMIT w / plot plan valid without expiration.* ☐ *IMPROVEMENT PERMIT w / site plan valid for 60 mos.* ☒ *AUTHORIZATION TO CONSTRUCT valid for period equal to IMPROVEMENT PERMIT-not to exceed 60 mo.*

Owner / Applicant Signature: Date 9.29.09

Improvement Permit by: J. A. Ellis RS Date 9-28-09

Authorization to Construct by: J. A. Ellis RS Date 9-28-09

YOU SHOULD CONTACT A LOCATOR SERVICE PRIOR TO ANY EXCAVATION.

Installed by: R+H RS

Operation Permit by: Date: 1/26/10

Existing System Inspected by: Date:

WHITE COPY Environmental Health YELLOW COPY (Final) Owner / Applicant PINK COPY (Initial) Owner / Applicant