3:30

IREDELL COUNTY HEALTH DEPARTMENT

STATESVILLE 704-878-5305 MOORESVILLE 704-664-5281

IMPROVEMENT PERMIT / AUTHORIZATION TO CONSTRUCT / OPERATION PERMIT / EXISTING SYSTEM INSPECTION

PERMIT # 157112 PIN # 4624582984 DATE 6/24/09

OWNER or APPLICANT Brian West PHONE: Business 704.666.6638 Home: —

OWNER or APPLICANT ADDRESS 570 Williamson Rd. Suite E Mooresville, NC 28117

LOCATION / DIRECTIONS Brawley School Rd. TL Torrence Chapel, TL Shelbourne, TL Cape Cod on Rt

SUBDIVISION The Point BLOCK / SECTION 11 LOT # 1139 LOT AREA 34,037 ft² DESIGN FLOW 600 gal/d L.T.A.R. 0.25-0.3

Septic Tank 1500 exist Gallons: STB 338 Date 10/3/03
Pump Tank 1500 Gallons: PT 477 Date 2-5-09
Pump Make Model Serial #
Nitrification Field No Fields 1 No Lines Field to vary Linear Feet 400- adding 80
Trench Width 24" Max. Trench Bottom Depth 36" Gravel Depth —

☐ New System ☐ Repair ☑ Expansion System Type I II III ⓘⓥ V VI
System Description: LP PPBPS
Repair System Description: LP PPBPS
Maintenance Agreement Required ☑ YES ☐ NO
☐ GRAVITY ☑ PRESSURE


☑ Residence No. Bedrooms 5
☐ Business No. Persons
☐ Other No. Employees
☑ Slab ☑ Crawl Space
☑ Basement w/plumbing ☐ Basement w/o plumbing

Water Supply
☐ Private
☑ Public
☑ Community

Comments / Conditions * Installing 2 new lines (48', 32') & 1500 gallon pumptank
* Install on contour / maintain all setbacks

Comments / Conditions 7/15/09 Checked PT

INITIAL SITE SKETCH

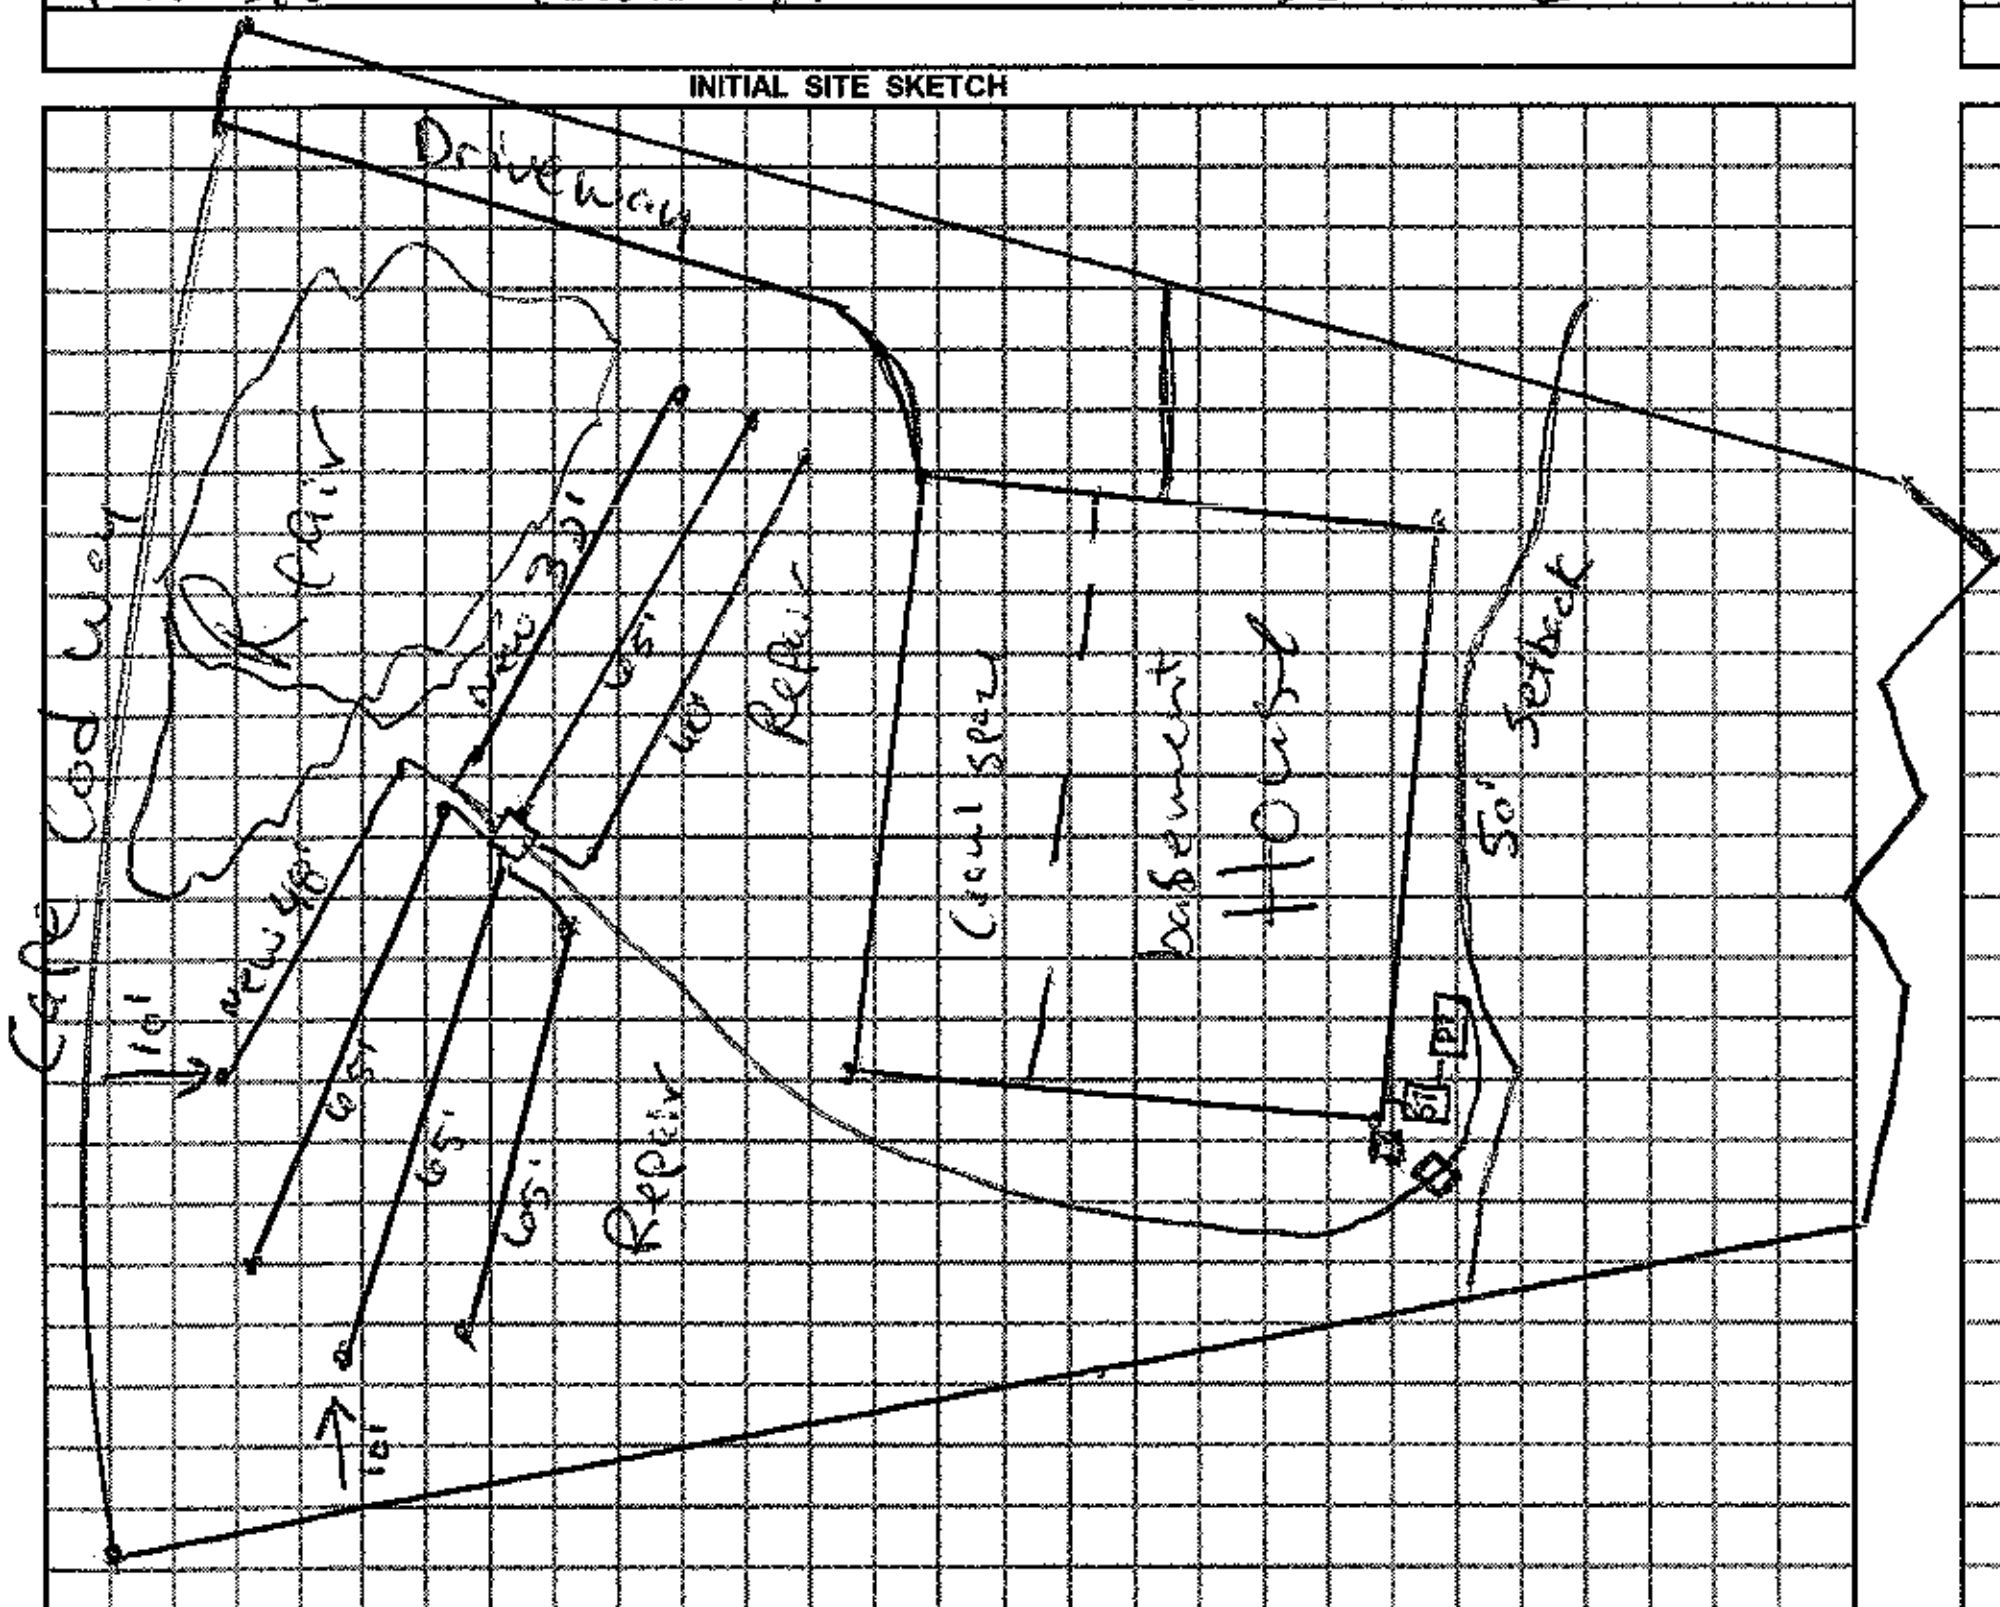

AS BUILT SKETCH

10' FROM POOL TO TANKS

Permit can be suspended or revoked if any false information is supplied toward securing the permit / any unauthorized changes are made to the site / any unauthorized changes are made in the installation of the system.

☐ IMPROVEMENT PERMIT w / plat valid without expiration. ☑ IMPROVEMENT PERMIT w / site plan valid for 60 mos. ☑ AUTHORIZATION TO CONSTRUCT valid for period equal to IMPROVEMENT PERMIT-not to exceed 60 mo.

Owner / Applicant Signature: [signature] Date 6/25/09
Improvement Permit by: [signature] Date 6/24/09
Authorzation to Construct by: [signature] Date 6/24/09

Installed by: R&H
Operation Permit by: Date:
Existing System Inspected by: Date:

YOU SHOULD CONTACT A LOCATOR SERVICE PRIOR TO ANY EXCAVATION.

WHITE COPY Environmental Health YELLOW COPY (Final) Owner / Applicant PINK COPY (Initial) Owner / Applicant