IREDELL COUNTY HEALTH DEPARTMENT

STATESVILLE 704-878-5305 52.00 Paid MOORESVILLE 704-664-5281

IMPROVEMENT PERMIT / AUTHORIZATION TO CONSTRUCT / OPERATION PERMIT / EXISTING SYSTEM INSPECTION

PERMIT# 109594 PIN# ~~4624-27-5705.1160~~ 4624583160 DATE 11/12/04

OWNER OR CONTRACTOR Simonize Bldrs PHONE: Business 704-358-9940 Home

ADDRESS 1910 South Blvd Charlotte NC

LOCATION BSR, TL Torrence Chapel, TL Shellburne, TL Cape Cod on Lt

SUBDIVISION Point BLOCK / SECTION 11 LOT 1160 LOT AREA 65,125 Ft² SITE CLASS. PS DESIGN FLOW 600 L.T.A.R. 0.3

Septic Tank: 1500 Gallons; STB 358 Date 4/16/05

Pump Tank: Gallons; PT Date

Pump Make: Model Serial No.

Nitrification Field: No Fields 1 Square Feet 1500 Linear Feet 500

No Lines 5 @ 100' Trench Width 36" Max Trench Bottom Depth 36" Gravel Depth —

☒ New System ☐ Repair System Type: I, II, III, IV, V, VI

System Description: Gravity 25% Reduct.

Repair System Description: LP/Panel Block

Maintenance Agreement Required: ☐ Yes ☒ No

☒ House/Mod. Home ☐ Mobile Home ☐ Business ☐ Other

No. Bedrooms 5 No. Bathrooms No. Employees


Water Supply: ☐ Individual ☐ Public ☒ Community

☐ Slab ☒ Crawl Space ☐ Basement w/plumbing ☐ Basement wo/plumbing


Comments/Conditions: 1" = 50'

Comments/Conditions: EZ Flow Installed

INITIAL SITE SKETCH

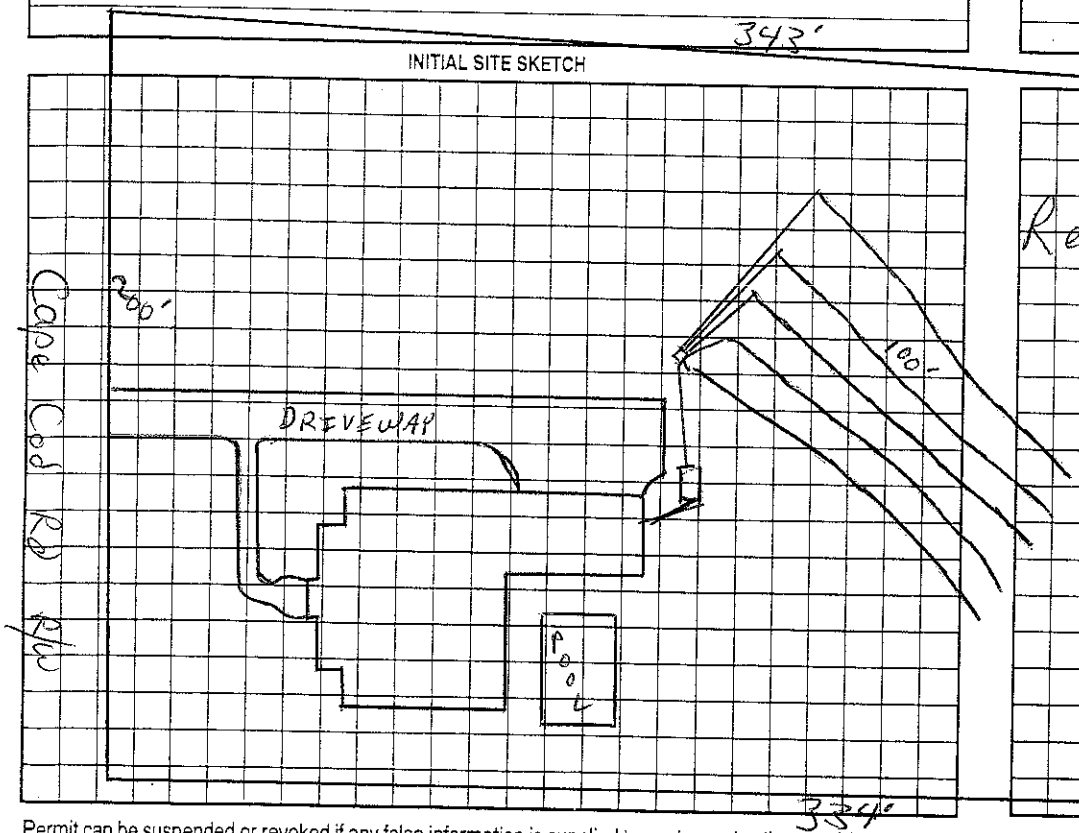

AS BUILT SKETCH

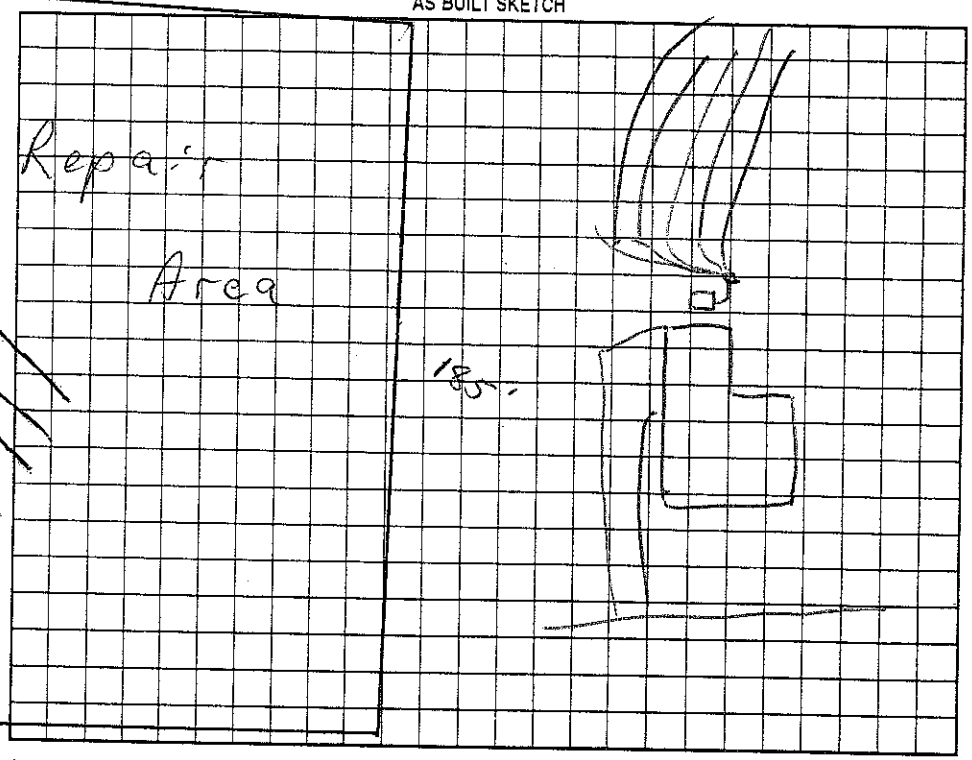

Permit can be suspended or revoked if any false information is supplied toward securing the permit/any unauthorized changes are made to the site/any unauthorized changes are made in the installation of the system. Improvement Permit with plat valid without expiration. Improvement Permit with site plan valid for sixty months. Authorization to Construct is valid for a period equal to that of Improvement Permit – not to exceed sixty months.

Signed: date 3/15/05 Installed by: RS + TT

Improvement Permit by: RS date 11/12/04 Operation Permit by: RS date 5/26/05

Authorization to Construct by: RS date 11/12/04 Existing System Inspection by: date

HEALTH DEPT. COPY: WHITE OWNER COPY (FINAL): YELLOW OWNER COPY (INITIAL): PINK