12/1458

IREDELL COUNTY HEALTH DEPARTMENT

STATESVILLE 704-878-5305 MOORESVILLE 704-664-5281

IMPROVEMENT PERMIT / AUTHORIZATION TO CONSTRUCT / OPERATION PERMIT / EXISTING SYSTEM INSPECTION

PERMIT# 102464 PIN# 4625-94-1684.848 4624-59-1786 DATE 10/27/04

OWNER OR CONTRACTOR Simonini Bldrs. PHONE: Business 704 358-9940 Home

ADDRESS 817 E Morehead Charlotte NC 28202

LOCATION BSR, TR Lightship, TL Swayne on Lt

SUBDIVISION The Point BLOCK / SECTION 8 LOT 848 LOT AREA 54,856 SITE CLASS PS DESIGN FLOW 480 L.T.A.R. 0.25

Septic Tank: 1000 Gallons; STB 338 Date 11-15-04

Pump Tank: 1000 Gallons; PT 283 Date 11-15-04

Pump Maker Gould Model WE0312M4U Serial No. JD484926

Nitrification Field: No. Fields 1 Square Feet 960 Linear Feet 320

No. Lines 5@64' Trench Width 36" Max Trench Bottom Depth 36" Gravel Depth —

☒ New System ☐ Repair System Type: I, II, III, (IV), V, VI

System Description: LP Panel Block

Repair System Description: Same

Maintenance Agreement Required: ☒ Yes ☐ No

☒ House/Mod. Home No. Bedrooms 4

☐ Mobile Home No. Bathrooms ____

☐ Business No. Employees ____

☐ Other ____


☐ Slab ☒ Crawl Space ☐ Basement w/plumbing ☐ Basement wo/plumbing

Water Supply: ☐ Individual ☒ Public ☒ Community

Comments:/Conditions:

Comments:/Conditions: Checked tanks & lines 12/17/04 MD

INITIAL SITE SKETCH

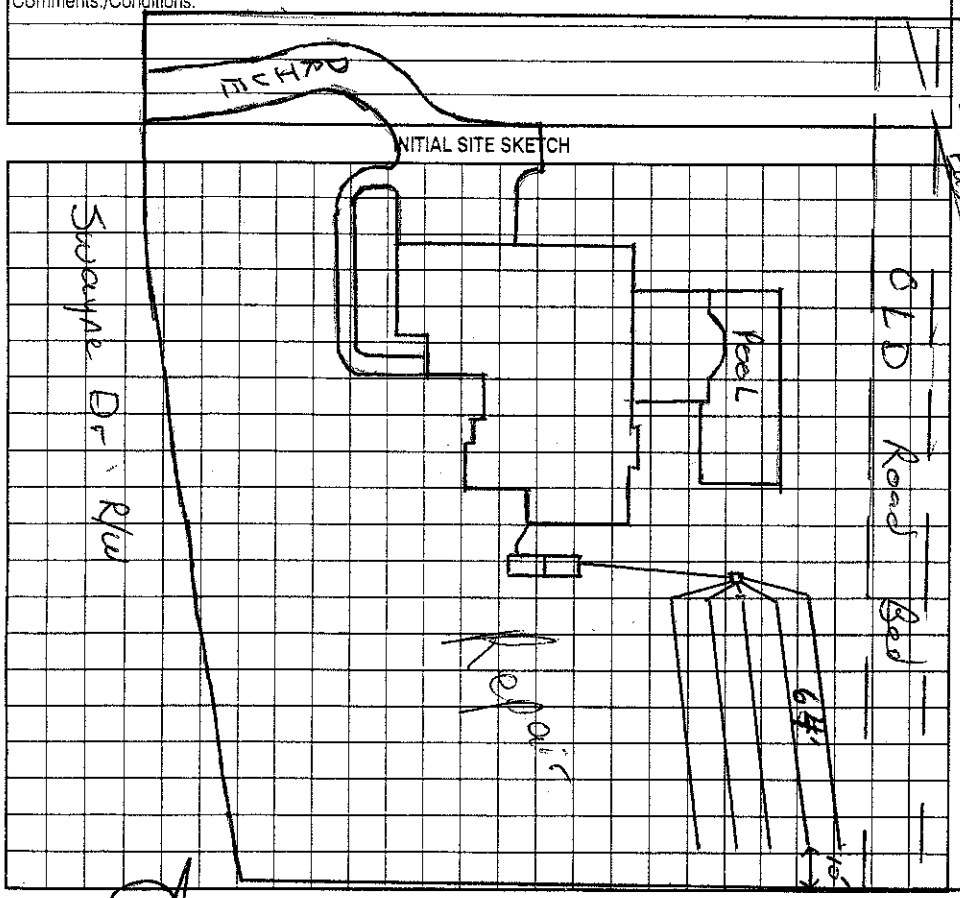

AS BUILT SKETCH

Location of the proposed Inground pool addition does not appear to impact the existing on-site septic system or well. **NOTE: Keep pool Cotat least 15ft Septic

Maina M Dotson REHS Date: 12/16/04

ICHD-Environmental Health Division

Permit can be suspended or revoked if any false information is supplied toward securing the permit/any unauthorized changes are made to the site/any unauthorized changes are made in the installation of the system. Improvement Permit with plan valid without expiration. Improvement Permit with site plan valid for sixty months. Authorization to Construct is valid for a period equal to that of Improvement Permit – not to exceed sixty months.

Signed: _____ date 10-29-04 Installed by: R&H

Improvement Permit by: _____ RS date 10/27/04 Operation Permit by: Maina M Dotson RS date 11/21/05

Authorization to Construct by: _____ RS date 10/27/04 Existing System Inspection by: _____ date _____

HEALTH DEPT COPY: WHITE OWNER COPY (FINAL): YELLOW OWNER COPY (INITIAL): PINK