IREDELL COUNTY HEALTH DEPARTMENT

STATESVILLE 704-878-6305 MOORESVILLE 704-664-5281

IMPROVEMENT PERMIT / AUTHORIZATION TO CONSTRUCT / OPERATION PERMIT / EXISTING SYSTEM INSPECTION

PERMIT# 108141 PIN# ~~4624-27-59-05-1141~~ 4624-59-5141 DATE 7/16/03

OWNER OR CONTRACTOR David Dibble Custom Homes PHONE: Business 704-799-1688 Home

ADDRESS PO Box 2355 Cornelius NC 28031

LOCATION BSR, TL Torrence Chapel, TL Shelburne, TL Cape Cod Way, on RT

SUBDIVISION Point BLOCK / SECTION 11 LOT 1141 LOT AREA 33,505 Ft2 SITE CLASS. PS DESIGN FLOW 600 L.T.A.R. 0.5

Septic Tank: 1500 Gallons; STB 338 Date 12/5/03
Pump Tank: 1500 Gallons; PT 421 Date 11/13/03
Pump Make: Zoeller Model WE0712HU Serial No. 6033271
Nitrification Field: No Fields 1 Square Feet 990 Linear Feet 330
No Lines 4@33' Trench Width 36" Max Trench Bottom Depth 36" Gravel Depth —

☒ New System ☐ Repair System Type: I, II, III, IV, V, VI
System Description: LP Panel Block
Repair System Description: same
Maintenance Agreement Required: ☒ Yes ☐ No

☒ House/Mod. Home No. Bedrooms 5
☐ Mobile Home No. Bathrooms 4½
☐ Business No. Employees
☐ Other


☐ Slab ☐ Crawl Space ☒ Basement w/plumbing ☐ Basement wo/plumbing

Water Supply: ☐ Individual ☐ Public ☒ Community

Comments:/Conditions:

Comments:/Conditions:

INITIAL SITE SKETCH

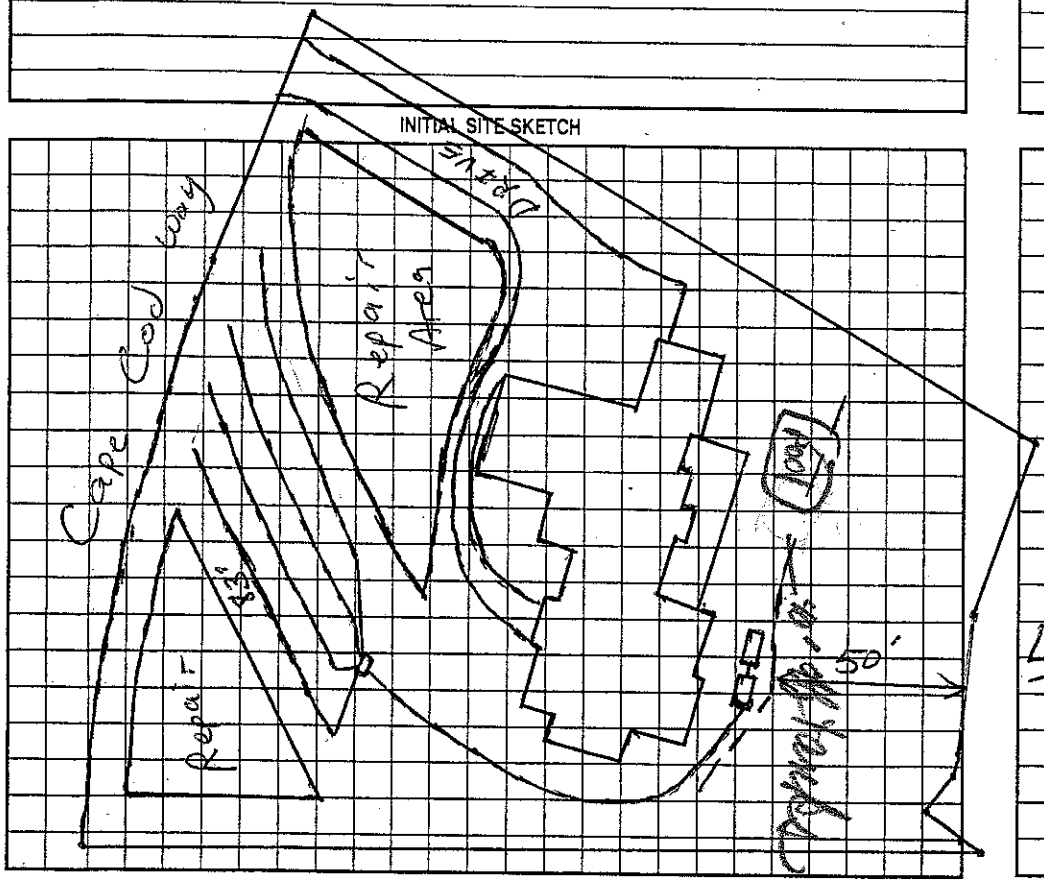

AS BUILT SKETCH

The proposed / existing Pool addition does not appear to impact the existing septic system.
**NOTE: Shall be min. 15' from septic tanks
Judy Melville R.S.
Date: 4-13-12
ICHD-Environmental Health Division

Permit can be suspended or revoked if any false information is supplied toward securing the permit/any unauthorized changes are made to the site/any unauthorized changes are made in the installation of the system. Improvement Permit with plat valid without expiration. Improvement Permit with site plan valid for sixty months. Authorization to Construct is valid for a period equal to that of Improvement Permit – not to exceed sixty months.

Signed: Cindy Dibble date 7/17/03
Improvement Permit by: RS date 7/16/03
Authorization to Construct by: RS date 7/16/03
Installed by: D. Dibble
Operation Permit by: RS date 3/25/04
Existing System Inspection by: date

HEALTH DEPT. COPY: WHITE OWNER COPY (FINAL): YELLOW OWNER COPY (INITIAL): PINK