IREDELL COUNTY HEALTH DEPARTMENT

STATESVILLE 704-878-5305 MOORESVILLE 704-664-5281

IMPROVEMENT PERMIT / AUTHORIZATION TO CONSTRUCT / OPERATION PERMIT / EXISTING SYSTEM INSPECTION

PERMIT# 108141 PIN# ~~4624-27-5705.1141~~ 4624-59-5141 DATE 7/16/03

OWNER OR CONTRACTOR David Dibble Custom Homes PHONE: Business 704-799-1688 Home

ADDRESS PO Box 2355 Cornelius NC 28031

LOCATION BSR, TL Torrence Chapel, TL Shelburne, TL Cape Cod Way, on Rt

SUBDIVISION Point BLOCK / SECTION 11 LOT 1141 LOT AREA 33,505 Ft² SITE CLASS. PS DESIGN FLOW 600 L.T.A.R. 0.3

Septic Tank: 1500 Gallons; STB 335 Date 12/5/03
Pump Tank: 1500 Gallons; PT 431 Date 11/13/03
Pump Make: Gatlds Model NE0712HU Serial No. 0337271
Nitrification Field: No Fields 1 Square Feet 990 Linear Feet 330
No Lines 4@83' Trench Width 36" Max Trench Bottom Depth 36" Gravel Depth —

☒ New System ☐ Repair System Type: I, II, III, IV, V, VI
System Description: LP Panel Block
Repair System Description: Same
Maintenance Agreement Required: ☒ Yes ☐ No

☒ House/Mod. Home No. Bedrooms 5
☐ Mobile Home No. Bathrooms 4½
☐ Business No. Employees ___
☐ Other


☐ Slab ☐ Crawl Space ☒ Basement w/plumbing ☐ Basement wo/plumbing

Water Supply:
☐ Individual
☐ Public
☒ Community


Comments:/Conditions:

Comments:/Conditions:

INITIAL SITE SKETCH

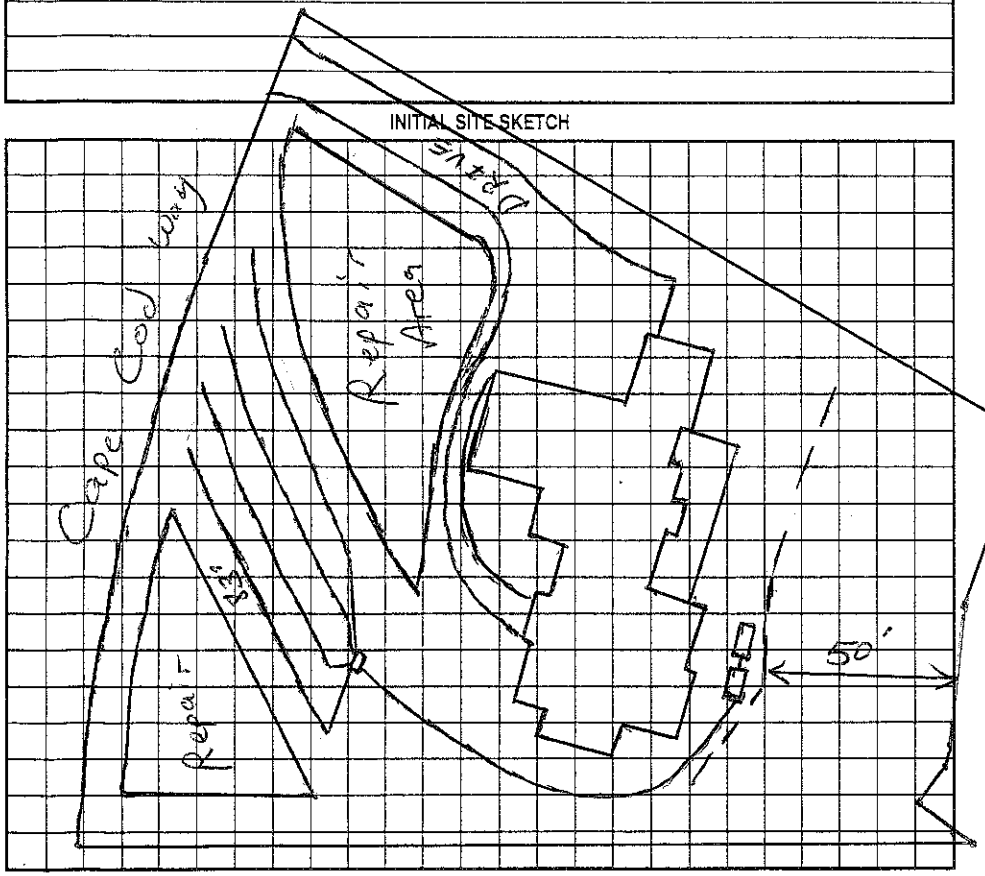

AS BUILT SKETCH

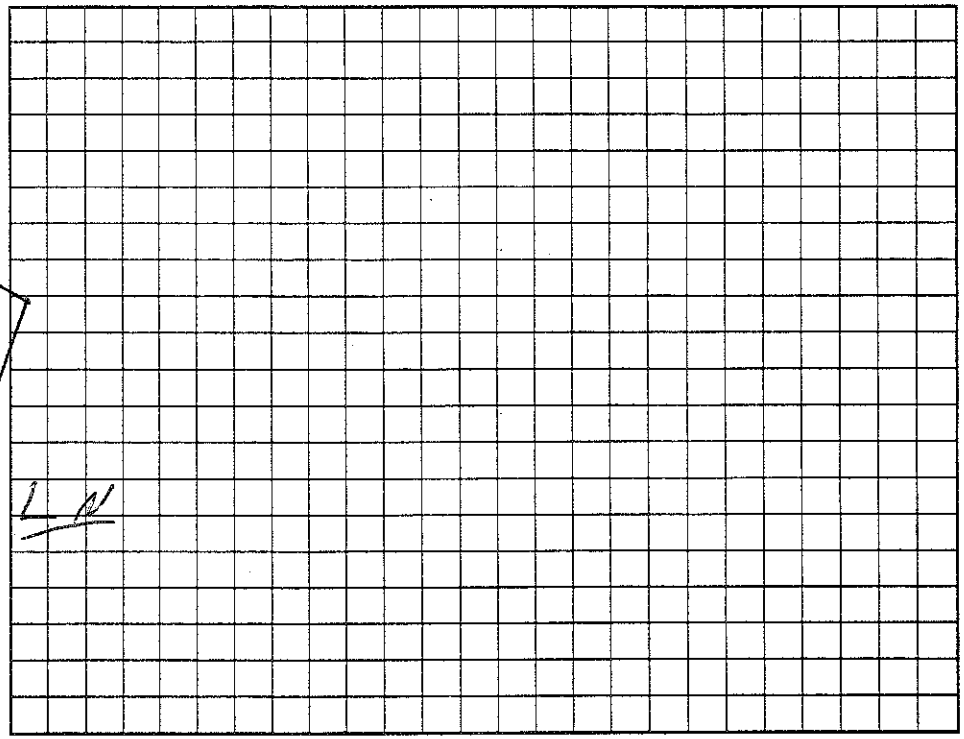

Permit can be suspended or revoked if any false information is supplied toward securing the permit/any unauthorized changes are made to the site/any unauthorized changes are made in the installation of the system. Improvement Permit with plat valid without expiration. Improvement Permit with site plan valid for sixty months. Authorization to Construct is valid for a period equal to that of Improvement Permit – not to exceed sixty months.

Signed: [signature] date 7/17/03 Installed by: Orbisco

Improvement Permit by: [signature] RS date 7/16/03 Operation Permit by: [signature] RS date 3/25/04

Authorization to Construct by: [signature] RS date 7/16/03 Existing System Inspection by: ___ date ___

HEALTH DEPT. COPY: WHITE OWNER COPY (FINAL): YELLOW OWNER COPY (INITIAL): PINK