3:00

IREDELL COUNTY HEALTH DEPARTMENT

STATESVILLE 704-878-5305 MOORESVILLE 704-664-5281

IMPROVEMENT PERMIT / AUTHORIZATION TO CONSTRUCT / OPERATION PERMIT / EXISTING SYSTEM INSPECTION

PERMIT# 108728 PIN# 4624-27-5905.1146 4624-59-7501 DATE Nov. 13, 02

OWNER OR CONTRACTOR The Pointe/Norvant // Crescent Resources Inc. / DESIGNST PHONE: Business _____ Home _____

ADDRESS 2219 Brawley Sch Rd. Mooresville N.C. 28117

LOCATION Brawley Sch Rd TL Torrence Chapel TL Shelburne TL Cope Rd TL Quincy Ct, on Right

SUBDIVISION The Point BLOCK / SECTION 11 LOT 1146 LOT AREA 41,536 ft² SITE CLASS. FS DESIGN FLOW 480 gpd L.T.A.R. .02-.25

Septic Tank: 1000 Gallons; STB 338 Date 1-26-04
Pump Tank: 1000 Gallons; PT 27 Date 1-23-04
Pump Make: Myers Model ME 50 Serial No. _____
Nitrification Field: No Fields 1 Square Feet 720/1080 Linear Feet 360
No Lines 4 Trench Width 24"min 36" Max Trench Bottom Depth 36" Gravel Depth NA

☑ New System ☐ Repair System Type: I, II, III, IV, V, VI
System Description: LPP PPBPS
Repair System Description: LPP PPBPS
Maintenance Agreement Required: ☑ Yes ☐ No

☑ House/Mod. Home No. Bedrooms 4
☐ Mobile Home No. Bathrooms 4
☐ Business No. Employees _____
☐ Other _____
☐ Slab ☑ Crawl Space ☐ Basement w/plumbing ☐ Basement wo/plumbing


Water Supply: ☐ Individual ☑ Public ☑ Community

Comments:/Conditions: or 36" max 90'

Comments:/Conditions: Used 80 panels, drilled 3/16" holes
Checked tanks & lines, 3/5/04
Blue filter installed


1"=50'

INITIAL SITE SKETCH

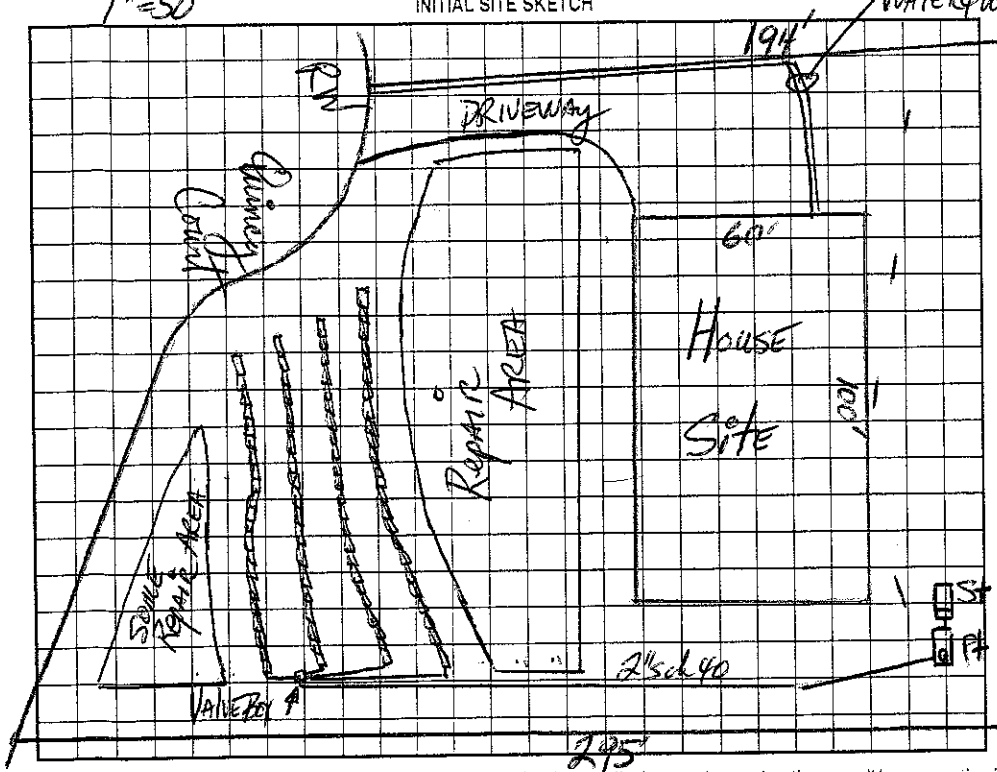

Water & Utility Lines This side

AS BUILT SKETCH

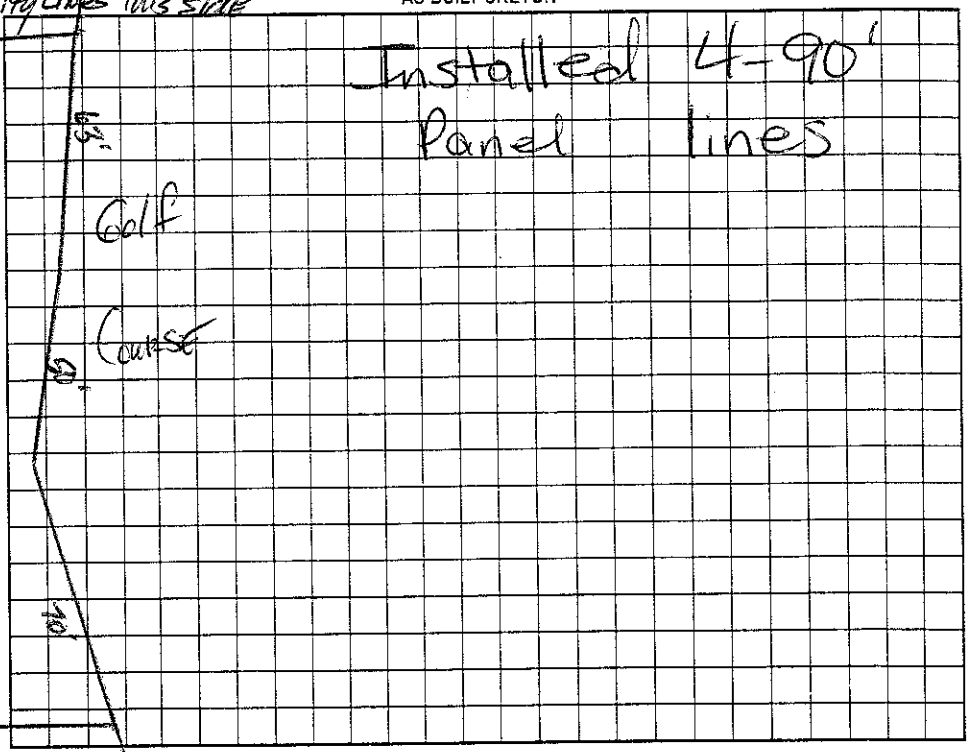

Permit can be suspended or revoked if any false information is supplied toward securing the permit/any unauthorized changes are made to the site/any unauthorized changes are made in the installation of the system. Improvement Permit with plat valid without expiration. Improvement Permit with site plan valid for sixty months. Authorization to Construct is valid for a period equal to that of Improvement Permit – not to exceed sixty months.

Signed: _____ date 11/7/02
Improvement Permit by: _____ date 11-13-02
Authorization to Construct by: _____ date 8/20/03

Installed by: R & H R.S
Operation Permit by: _____ date 3/31/04
Existing System Inspection by: _____ date _____

HEALTH DEPT. COPY: WHITE OWNER COPY (FINAL): YELLOW OWNER COPY (INITIAL): PINK