IREDELL COUNTY HEALTH DEPARTMENT

STATESVILLE 704-878-5305 MOORESVILLE 704-664-5281

IMPROVEMENT PERMIT / AUTHORIZATION TO CONSTRUCT / OPERATION PERMIT / EXISTING SYSTEM INSPECTION

PERMIT# 108144 PIN# 4624 29 5905 .1143 4624-59-8040 DATE 9/26/03

OWNER OR CONTRACTOR Eldred Custom Homes PHONE: Business 704-361-5991 Home

ADDRESS PO Box 1003 Charlotte, NC.

LOCATION 1100 TL Point Dr. Torrence Chapel TL Shelburne TL Cape Cod on R at end

SUBDIVISION Point BLOCK / SECTION 11 LOT 1143 LOT AREA 47,769 SITE CLASS. PS DESIGN FLOW 480 L.T.A.R. .3

Septic Tank: 1000 Gallons; STB 338 Date 9/28/04
Pump Tank: 1000 Gallons; PT 283 Date 9/27/04
Pump Make: Gouds Model WE05P2HHU Serial No. A04056577
Nitrification Field: No Fields 1 Square Feet 1080 Linear Feet 360'
No Lines 5 Trench Width 2'-3' Max Trench Bottom Depth 3' Gravel Depth N/A

☒ New System ☐ Repair System Type: I, II, III, (IV) V, VI
System Description: Pressure - 16" PPBPS
Repair System Description: PPBPS
Maintenance Agreement Required: ☒ Yes ☐ No


☒ House/Mod. Home No. Bedrooms 4
☐ Mobile Home No. Bathrooms 3.5
☐ Business No. Employees
☐ Other
☐ Slab ☒ Crawl Space ☐ Basement w/plumbing ☐ Basement wo/plumbing

Water Supply:
☐ Individual
☐ Public
☒ Community
Point


Comments:/Conditions:

Comments:/Conditions:

INITIAL SITE SKETCH (1"=50')

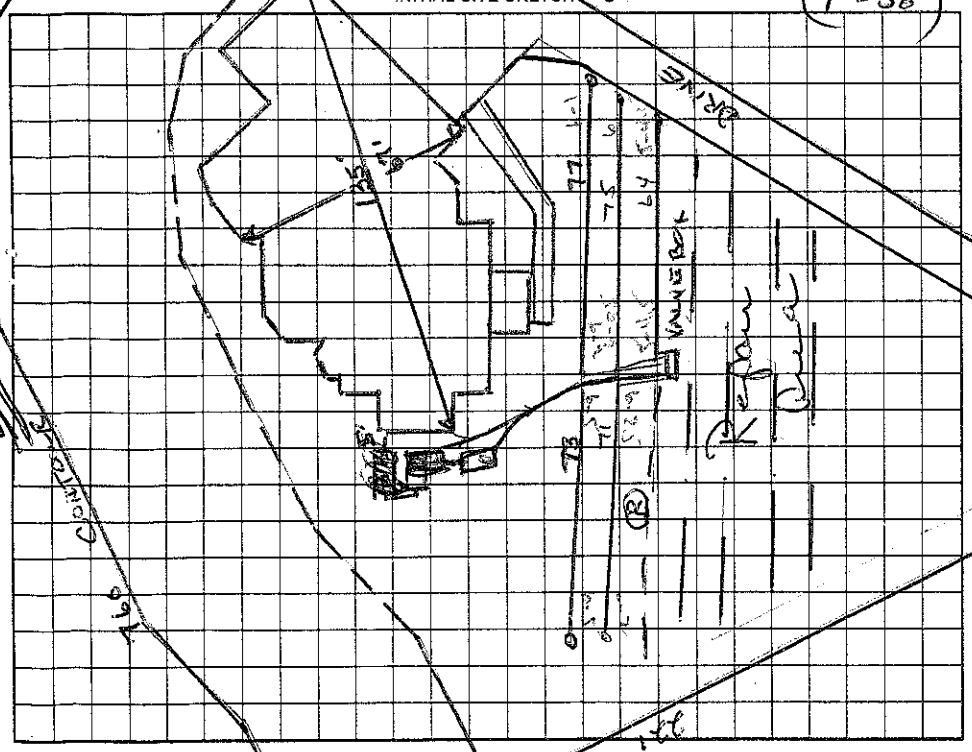

AS BUILT SKETCH

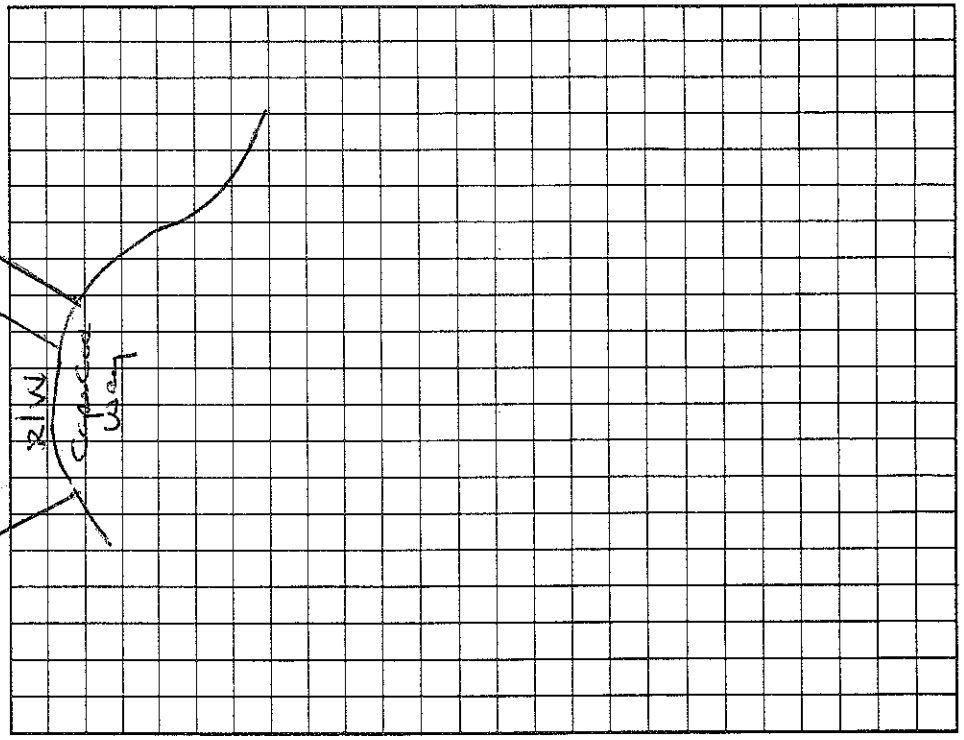

Permit can be suspended or revoked if any false information is supplied toward securing the permit/any unauthorized changes are made to the site/any unauthorized changes are made in the installation of the system. Improvement Permit with plat valid without expiration. Improvement Permit with site plan valid for sixty months. Authorization to Construct is valid for a period equal to that of Improvement Permit – not to exceed sixty months.

Signed: ✕ date 9/30/03 Installed by: Orbison & Sons

Improvement Permit by: Wesley Sparks R.S. date 9/28/03 Operation Permit by: Wesley Sparks R.S. date 8/23/04

Authorization to Construct by: Wesley Sparks R.S. date 9/29/03 Existing System Inspection by: date

HEALTH DEPT. COPY: WHITE OWNER COPY (FINAL): YELLOW OWNER COPY (INITIAL): PINK