IREDELL COUNTY HEALTH DEPARTMENT

STATESVILLE 704-878-5305 MOORESVILLE 704-664-5281

IMPROVEMENT PERMIT / AUTHORIZATION TO CONSTRUCT / OPERATION PERMIT / EXISTING SYSTEM INSPECTION

2500 Paid

PERMIT# 108694 PIN# 4624-27-5905 4624-59-9193 DATE Aug 20, 03

OWNER OR CONTRACTOR CRI // Kingswood Custom Homes PHONE: Business 506-3456 Home

ADDRESS 8033 Corp Dr. Suite 400 Charlotte, N.C. 28226

LOCATION Brawley Sch Rd. TL Torrence Chapel TL Shelburne TL Cape Cod at end on Right - SFE at end of Quincy Ct. on left

SUBDIVISION The Point BLOCK / SECTION // LOT 11441/11444 LOT AREA 37829 + 44735 ft² SITE CLASS. PS SFE DESIGN FLOW 720 gpd L.T.A.R. .025 SFE

Septic Tank: 1500 Gallons; STB 338 Date 4/25/04
Pump Tank: 1500 Gallons; PT 421 Date 4/21/04
Pump Make: Gould Model WEO 20121HC Serial No C033730L
Nitrification Field: No Fields 1 Square Feet 960/1440 Linear Feet 480
No Lines 8@60'± Trench Width 24" min 36" Max Trench Bottom Depth 36" Gravel Depth NA

☑ New System ☐ Repair System Type: I, II, III, ⓘ V, VI
System Description: LPP BPS
Repair System Description: SAME
Maintenance Agreement Required: ☑ Yes ☐ No

☑ House/Mod. Home No. Bedrooms 6
☐ Mobile Home No. Bathrooms 5
☐ Business No. Employees
☐ Other

☐ Slab ☑ Crawl Space ☐ Basement w/plumbing ☐ Basement wo/plumbing


Water Supply: ☐ Individual ☑ Public ☑ Community

Comments:/Conditions: OR 36" MAX 9'0C
Tanks, Lines, Access

Comments:/Conditions:

1"=100'

INITIAL SITE SKETCH

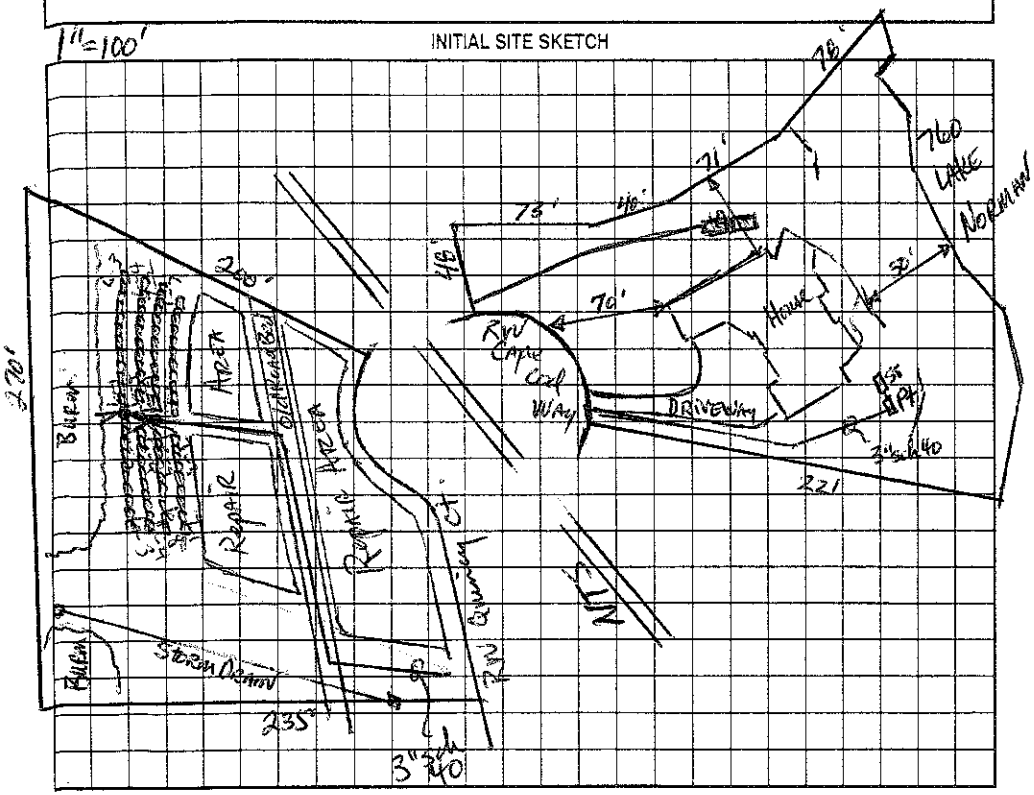

AS BUILT SKETCH

Permit can be suspended or revoked if any false information is supplied toward securing the permit/any unauthorized changes are made to the site/any unauthorized changes are made in the installation of the system. Improvement Permit with plat valid without expiration. Improvement Permit with site plan valid for sixty months. Authorization to Construct is valid for a period equal to that of Improvement Permit – not to exceed sixty months.

Signed: [signature] date 8-20-03 Installed by: Kevin Hellmen

Improvement Permit by: [signature] RS date 8-20-03 Operation Permit by: Wesley Sparks R.S. date 7/12/04

Authorization to Construct by: [signature] RS date 8-20-03 Existing System Inspection by: date

HEALTH DEPT. COPY: WHITE OWNER COPY (FINAL): YELLOW OWNER COPY (INITIAL): PINK