IREDELL COUNTY HEALTH DEPARTMENT

STATESVILLE 704-878-5305 D MOORESVILLE 704-664-5281

IMPROVEMENT PERMIT / AUTHORIZATION TO CONSTRUCT / OPERATION PERMIT / EXISTING SYSTEM INSPECTION

PERMIT# 117233 PIN# 4624 67 0643 DATE 12/15/03

OWNER OR CONTRACTOR Bill Rayburn / James Preso PHONE: Business 704-773-0891 Home

ADDRESS 268 Shepherd Rd 252 Greyfriars Rd. Mooresville, NC. 28117

LOCATION 1100' ± Torrence Chapel TL Greyfriars Rd. first house on R

SUBDIVISION Greyfriars Cove BLOCK / SECTION LOT 1 LOT AREA SITE CLASS. DESIGN FLOW 480 L.T.A.R.

Septic Tank: EXISTING Gallons; STB Date

Pump Tank: EXISTING Gallons; PT Date

Pump Make: Model Serial No.

Nitrification Field: No Fields Square Feet existing system Linear Feet

No Lines Trench Width Max Trench Bottom Depth Gravel Depth

☐ New System ☐ Repair System Type: I, II, III, IV, V, VI

System Description: Existing System

Repair System Description:

Maintenance Agreement Required: ☐ Yes ☐ No

☒ House/Mod. Home No. Bedrooms 4

☐ Mobile Home No. Bathrooms 3

☐ Business No. Employees

☐ Other

☐ Slab ☒ Crawl Space ☐ Basement w/plumbing ☐ Basement wo/plumbing


Water Supply: ☒ Individual ☐ Public ☐ Community

Comments:/Conditions:

Comments:/Conditions:

INITIAL SITE SKETCH

AS BUILT SKETCH

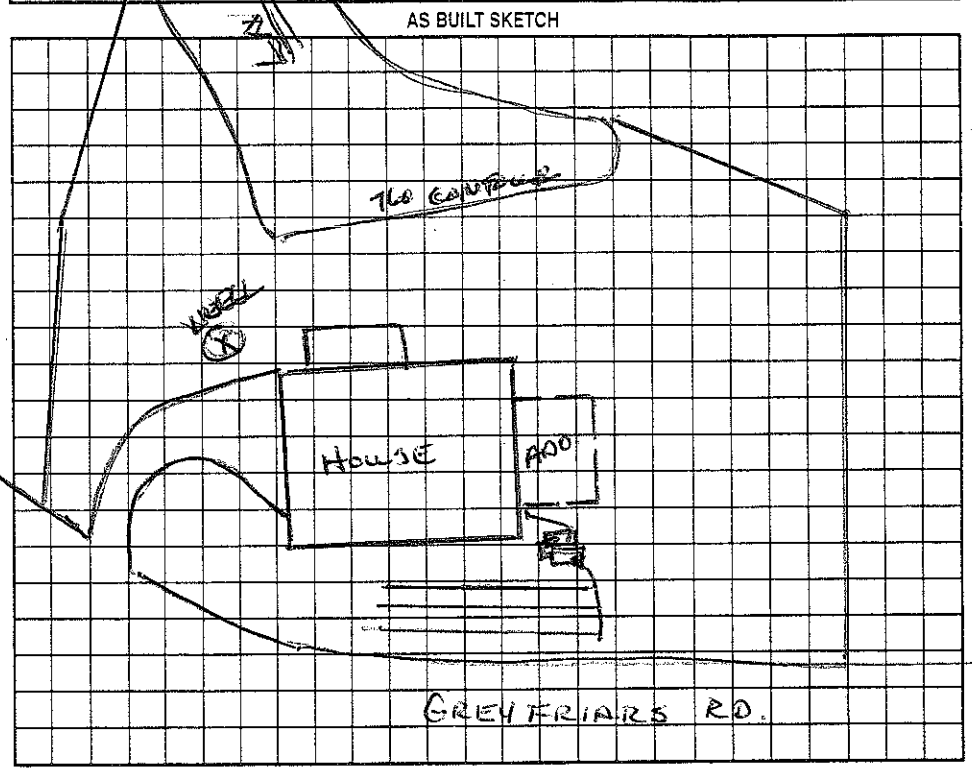

Permit can be suspended or revoked if any false information is supplied toward securing the permit/any unauthorized changes are made to the site/any unauthorized changes are made in the installation of the system. Improvement Permit with plat valid without expiration. Improvement Permit with site plan valid for sixty months. Authorization to Construct is valid for a period equal to that of Improvement Permit – not to exceed sixty months.

Signed: [signature] date 12/16/03 Installed by:

Improvement Permit by: date Operation Permit by: date

Authorization to Construct by: date Existing System Inspection by: [signature] date 12/15/03

HEALTH DEPT. COPY: WHITE OWNER COPY (FINAL): YELLOW OWNER COPY (INITIAL): PINK