42.50 (1:30) (2:30-3:00) - Orbison

# COUNTY HEALTH DEPARTMENT

STATESVILLE 704-878-5305 MOORESVILLE 704-664-5281

## IMPROVEMENT PERMIT / AUTHORIZATION TO CONSTRUCT / OPERATION PERMIT / EXISTING SYSTEM INSPECTION

PERMIT# 077046 PIN# 4624671577 DATE 10/29/98

OWNER OR CONTRACTOR Mike Hamby PHONE: Business 642-5095 Home

ADDRESS 17102 Greyfriars Rd Mooresville NC 28117

LOCATION Brawley School Rd TL Torrence Chapel TL Greyfriars Rd 2nd lot on right (Former Meek Neck)

SUBDIVISION Greyfriars BLOCK / SECTION LOT 2 LOT AREA .45Acre SITE CLASS. PS DESIGN FLOW 360gpd L.T.A.R. .3

Septic Tank: 1000 Gallons; STB 794 Date 12/10/98

Pump Tank: 1000 Gallons; PT 27 Date 7/17/99

Pump Make: Hydromatic Model Shaef SOA Serial No.

Nitrification Field: No Fields 1 Square Feet 420' Linear Feet 210'

No Lines 6 at 45'eq Trench Width 24" Max Trench Bottom Depth 30"

[X] New System [ ] Repair System Type: I, II, III, IV, V, VI

System Description: Pump(PM) Panel Blk +

Repair System Description: Same

Maintenance Agreement Required: [ ] Yes [X] No

[X] House/Mod. Home No. Bedrooms 3

[ ] Mobile Home No. Bathrooms 4.5

[ ] Business No. Employees

[ ] Other

Water Supply: [X] Individual [ ] Public [ ] Community


Gravel Depth N/A [ ] Slab [ ] Crawl Space [X] Basement w/plumbing [ ] Basement wo/plumbing

Comments:/Conditions: Keep Septic System at least 10' from PL, 50' from lake & 50' from all wells


Comments:/Conditions: +50% Reduction In Drainfield Area
* Well variance needed - well closer than 50' to lake.

Scale 1:30'

**INITIAL SITE SKETCH**

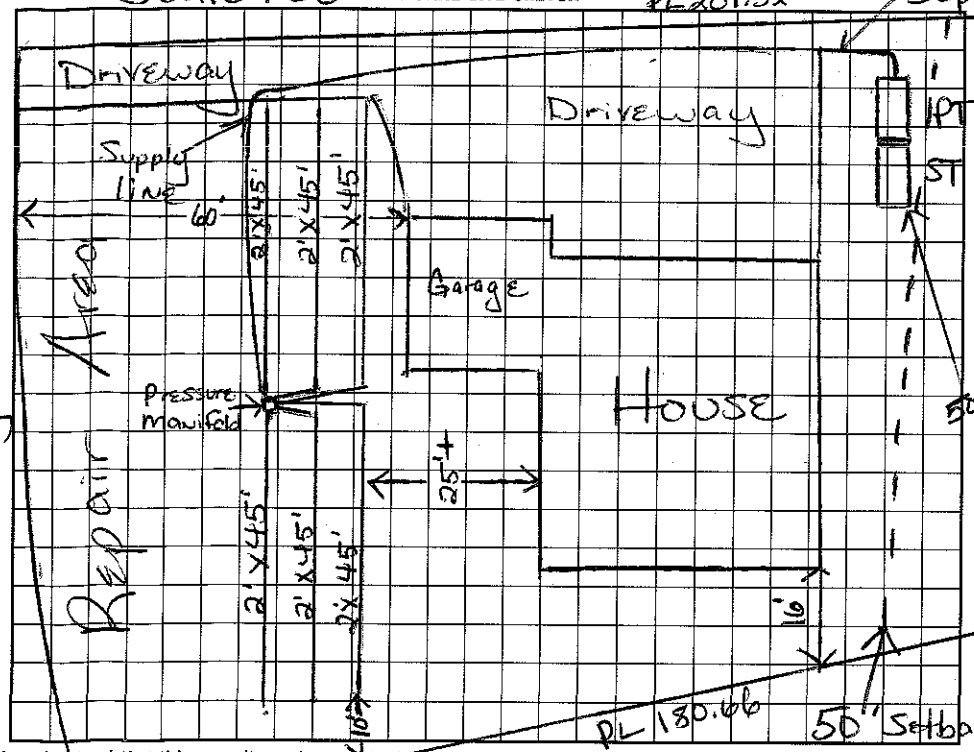


**AS BUILT SKETCH**

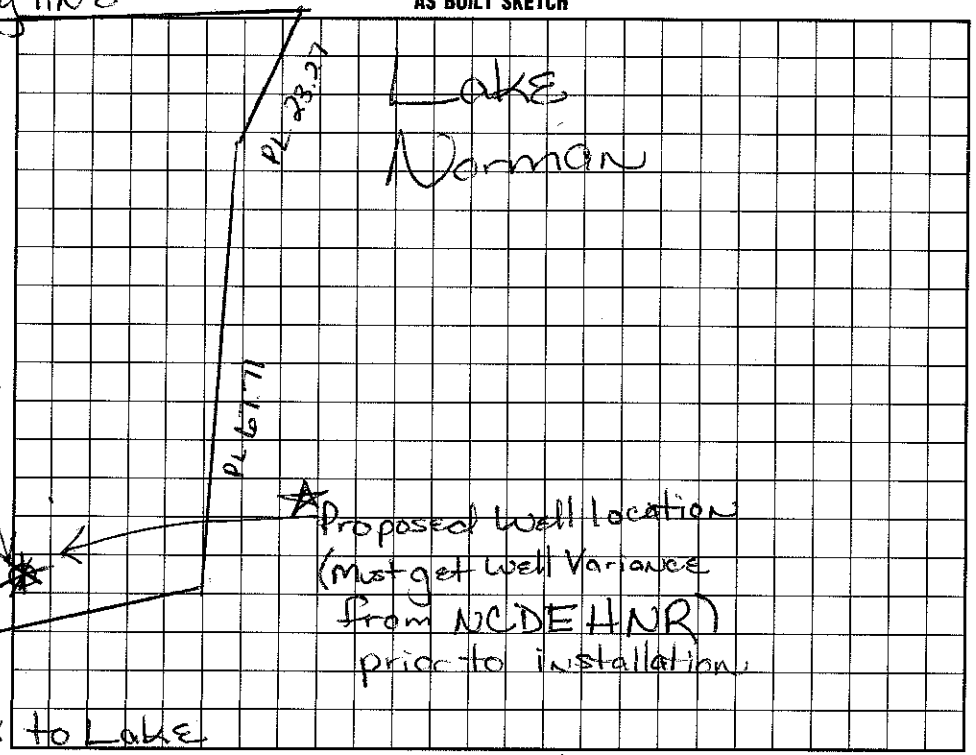


I understand that this permit can be suspended or revoked if any false information is supplied toward securing the permit/any unauthorized changes are made to the site/any unauthorized changes are made in the installation of the system. Improvement Permit with plat valid without expiration. Improvement Permit with site plan valid for sixty months. Authorization to Construct is valid for a period equal to that of Improvement Permit – not to exceed sixty months.

Signed: Cheryl Hamby date 10/30/98 Installed by: Orbison

vement Permit by: Marina H. Dotson RS date 10/29/98 Operation Permit by: Jeff Moyer date 7/22/99

ation to Construct by: Marina H. Dotson RS date 10/29/98 Existing System Inspection by: date

HEALTH DEPT. COPY: WHITE INSPECTION COPY (FINAL): GREEN OWNER COPY (FINAL): YELLOW INSPECTION COPY (INITIAL): PINK OWNER COPY (INITIAL): GOLD