ICHD–ENVIRONMENTAL HEALTH DIVISION

Statesville Office (704) 878-5305 | Mooresville Office (704) 660-3625 | PERMIT # AP-302294

SEPTIC IMPROVEMENT PERMIT / AUTHORIZATION TO CONSTRUCT / OPERATION PERMIT / EXISTING SYSTEM

PIN # 4624-67-4237

APPLICANT/OWNER: Robert F. Wojcik | APPLICANT ADDRESS: 280 Greyfriars Rd. Mooresville, NC | PHONE: 704-799-9556 | ALT. PHONE

SITE ADDRESS: 280 Greyfriars Rd. Mooresville, NC 28117 | SAP CONTROLLED: ☐ YES ☒ NO

SITE DIRECTIONS: BSR → Torrence Chapel Rd → L on Greyfriars → House on Right | DESIGN FLOW: 360 GPD | L.T.A.R.: 0.30 (Existing)

SUBDIVISION: Greyfriars | SECTION: — | LOT # 6 | LOT AREA: 0.47 acres

Septic Tank	1000 (gal)	STB	Infiltrator	Date	Infiltrator	☐ New System ☒ Repair ☐ Expansion	System Type: I II III (IV) V VI
Pump Tank	Existing (gal)	PT	Existing	Date	Existing	System Description:	Replace Septic tank as needed.
Pump Make	"	Model	"	Serial #	"	Repair System Description:	Pump + Crush existing tank.
# Nitrification Fields	1	# Lines	3 (Existing)	Linear Ft	210 Existing	Maintenance Agreement Required:	☒ YES ☐ NO
Trench Width	Existing	Trench Bottom Depth(Low side)	Existing	Gravel Depth	—		☐ GRAVITY ☒ PRESSURE


☒ Residence ☐ Business ☐ Other ☐ Slab ☐ Basement w/plumbing

No. Bedrooms 3 | No. Persons 4 | No. Employees — | ☒ Crawl Space | ☐ Basement w/o plumbing


Water Supply: ☒ Private ☐ Public ☐ Community

Comments / Conditions: Existing tanks to be pumped + crushed in place or hauled away. 50' lake buffer MUST be marked + staked by a licensed surveyor prior to new tank installation and visible at time of final inspection. Contractor to verify integrity of pump tank as well. Replace if needed.

INITIAL SITE SKETCH

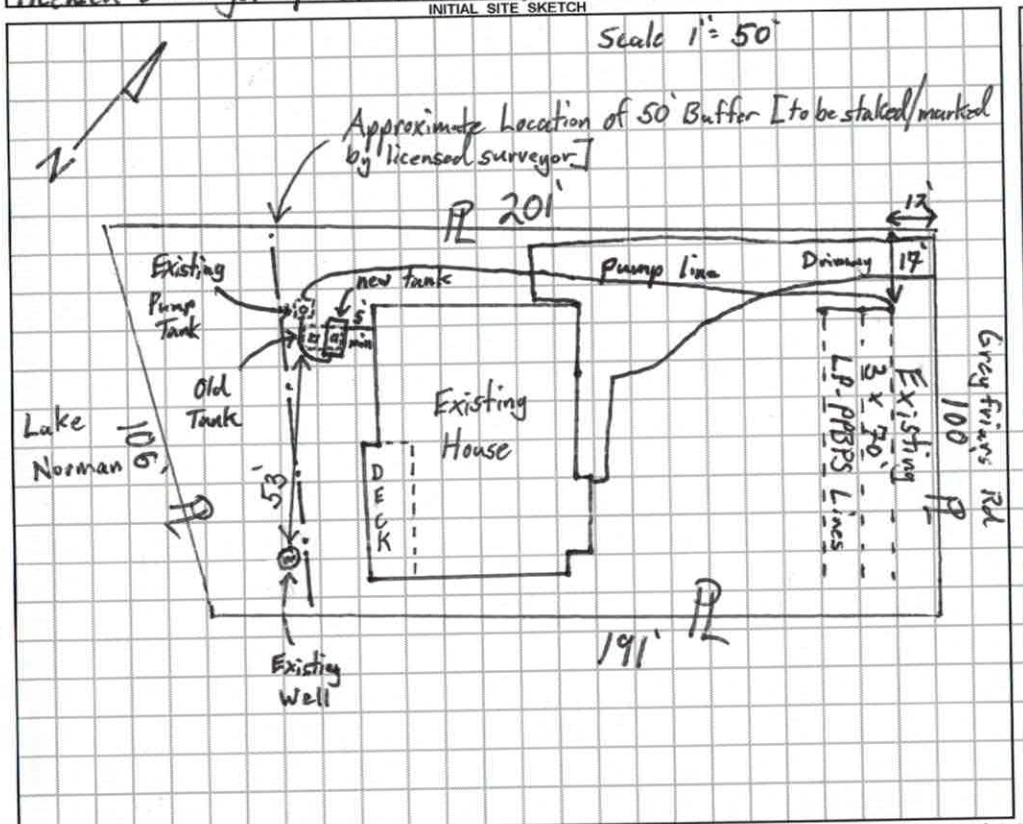

AS BUILT SKETCH

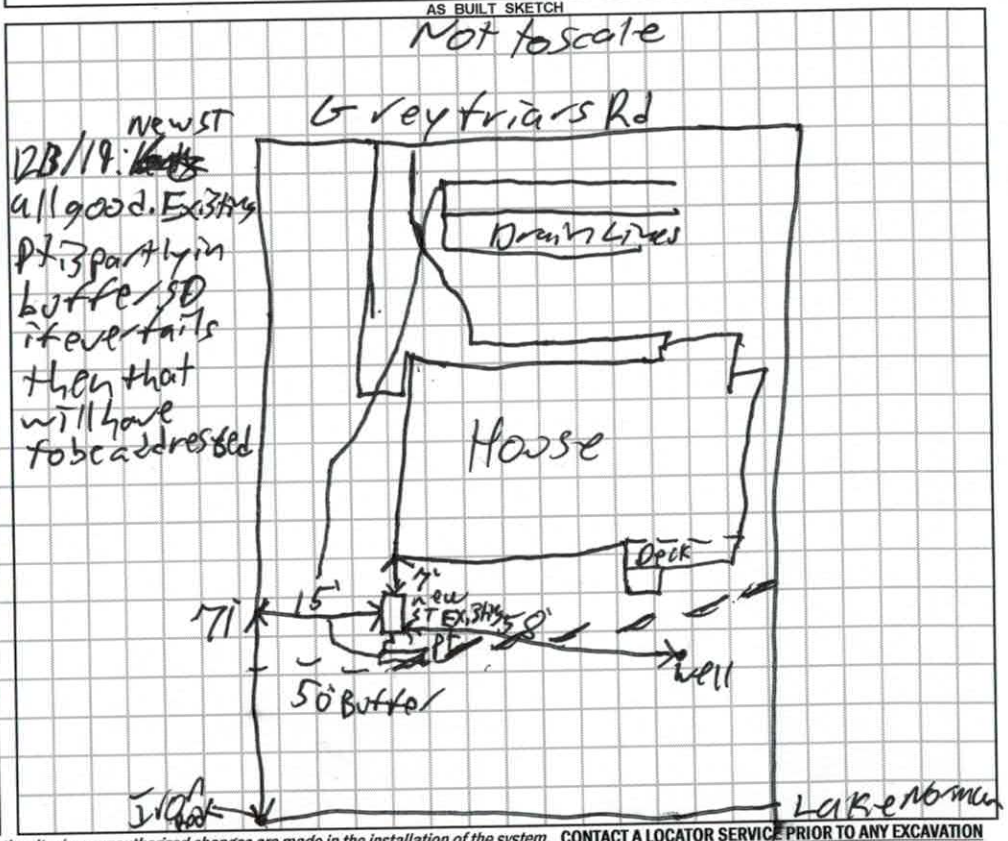

Permit can be suspended or revoked if any false information is supplied toward securing the permit / any unauthorized changes are made to the site / any unauthorized changes are made in the installation of the system. **CONTACT A LOCATOR SERVICE PRIOR TO ANY EXCAVATION**

☐ **IMPROVEMENT PERMIT** *with plat valid without expiration.* ☒ **IMPROVEMENT PERMIT** *with site plan valid for 60 mos.* ☒ **AUTHORIZATION TO CONSTRUCT** *valid for period equal to IMPROVEMENT PERMIT--not to exceed 60 mo.*

Owner / Applicant Signature: [signature] Date: 11/14/19 | Installed by: Lentz Wastewater

IMPROVEMENT PERMIT by: S Thomas Shuck Date: 11/14/19 | OPERATION PERMIT by: Patrick J Boyle III Date: 12/31/19

AUTHORIZATION TO CONSTRUCT by: S Thomas Shuck Date: 11/14/19 | Existing System Inspected by: Date:

FOR SEPTIC FINAL INSPECTION: CALL 704-664-3703 between 8am-9am the day the inspection is needed. Be sure to speak with an inpsector to confirm your inspection time.

APPLICATION MUST BE FILLED OUT COMPLETELY & BE LEGIBLE OR IT WILL NOT BE PROCESSED

AP-302294
11.1.19
Repl. Eval ✓

Iredell County Health Department – Environmental Health Division

PAGE 1: *APPLICATION FORM*

Application For: ( ) New Well Permit ( ) Well Repair Permit ( ) Well Abandonment
( ) Septic Improvement Permit ( ) Authorization to Construct ( ) Existing System Inspection (X) Septic System Repair

THE ABOVE PERMIT DOCUMENTS WILL BECOME INVALID IF INFORMATION PROVIDED ON THIS APPLICATION IS FALSIFIED OR CHANGED, OR IF THE SITE IS ALTERED. THE IMPROVEMENT PERMIT IS VALID FOR EITHER 60 MONTHS OR WITHOUT EXPIRATION DEPENDING UPON DOCUMENTATION SUBMITTED. APPLICATION WITH SITE PLAN 60 MONTHS, APPLICATION WITH COMPLETE, SCALED PLAT WITHOUT EXPIRATION. SEE 15A NCAC 18A .1937(f) FOR DETAILS.

Page 2: *Site Plan Worksheet* form MUST accompany this application

The following optional attachments may also be submitted: ( ) Survey Plat, scaled no more than 1 inch = 60 feet
Place an (X) beside whichever is submitted if applicable ( ) Custom Site Plan, scaled no more than 1 inch = 60 feet

Applicant Information: (PRINT CLEARLY)

Applicant Name: ROBERT F. WOJCIK Address: 280 GREYFRIARS RD., MOORESVILLE, NC Zip: 28117
Applicant Email: sailing4@windstream.net Phone: 704.799.9556 Alt. Phone: _____
Owner Name: ROBERT F. WOJCIK Address: 280 GREYFRIARS RD.; MOORESVILLE, NC Zip: 28117
Owner Email: sailing4@windstream.net Phone: 704.799.9556 Alt. Phone: _____

Property Information:

Street Address: 280 GREYFRIARS RD.; MOORESVILLE, NC 28117
Subdivision Name: GREYFRIARS Section/Phase: _____ Lot Number: 6
Driving Directions: BRAWLEY SCHOOL RD., LEFT ONTO TORRENCE CHAPEL RD., LEFT ONTO GREYFRIARS RD.

Site Development Information: *(check or complete ALL that apply*

CHECK FOUNDATION TYPE

( ) New Single Family Residence
( ) New Multi-Family Residence
( ) Accessory Building
( ) Bedroom(s) Addition
(✓) Repair to failing septic system (Tank) ___ Drain lines Describe Problem: TANK CRACKING

Maximum Number of Bedrooms: 3
Maximum Number of Occupants: _____
( ) Swimming Pool
( ) Other Addition/Structure: _____

(X) Crawl Space Foundation
( ) Concrete Slab Foundation
( ) Basement with Plumbing
( ) Basement without Plumbing

Non-Residential Site Development: Type of Business: _____
Square Footage of Building: _____ Max. Number of Employees: _____ Max. Number of Seats/Beds/Other: _____

Water Supply: ( ) Replacement Well – Reason: _____
( ) Multi-connection Well Number of Houses: ONE Number of Persons: TWO
( ) New Well (X) Existing Well ( ) Community Well ( ) City Water ( ) Other Public Water

Desired Septic System Type: *(you may rank in order of preference)* Year existing system installed: _____
( ) No Preference ( ) Alternative ( ) Conventional ( ) Innovative ( ) Modified Conventional ( ) Other: _____

Please answer the following to the best of your ability:

( ) Yes (X) No Does the site contain any jurisdictional wetlands?
( ) Yes (X) No Is any non-domestic sewage (i.e. industrial) to be generated?
( ) Yes (X) No Is the site subject to approval by any other public agency?

I have read this application and certify that the information provided herein is true, complete, and correct. Authorized county and state officials are granted right of entry to conduct necessary inspections to determine compliance with applicable laws and rules. I understand that I am solely responsible for the proper identification and labeling of all property lines and corners and making the site accessible so that a complete site evaluation can be performed.

Signature: R. Wojcik OCT. 31, 2019
Property owner or owner's legal representative signature (SIGNATURE REQUIRED) DATE

11/4/19 @ 3:05pm
97.8
10.75 current Lake Level
1.50 (760 elev)

DOCUMENTATION TO AUTHORIZE AN OWNER'S LEGAL REPRESENTATIVE

(Check and sign only ONE of the options below)

1. *** APPLICANT AND OWNER ARE THE SAME. *** (*Sign here*) _____

Applications for permits require the "signature of the owner or owner's legal representative" (15A NCAC 18A .1937). If the owner does not sign the application himself or herself, they can submit any one of the following documents to designate their legal representative: *Power of Attorney; Real Estate Contract; Estate executor; Bankruptcy trustee; Court ordered guardianship* In the absence of the above documentation, the property owner may provide the local health department with documentation that designates a legal representative. A property owner may:
Complete this form to document his or her legal representative, or provide his or her own form that contains the information in this form. If there are multiple property owners, then all property owners must sign the form that designates a legal representative.

By signing a form that designates a legal representative for purposes of 15A NCAC 18A .1937, the property owner authorizes that representative to act on their behalf in matters pertaining to the application and permitting process, including signing or receiving any application, document or permit. The owner retains full responsibility to meet all permit conditions specified by the local health department.

2. I, _____, am the legal owner(s) of the property located at _____, identified as PIN (Parcel Identification Number) _____, located in Iredell County, North Carolina.

I do hereby authorize (**print legal representative/company name**) _____, to act as an agent on my behalf in applying for/signing/obtaining any of the documents described below.

- Application for Improvement Permit (IP) / Authorization to Construct (AC)
- Improvement Permit (IP) / Authorization to Construct (AC)
- Application for soil-site evaluation (new/repair)
- Application/permit for private drinking water well/well abandonment
- Application for Compliance Inspection

I agree to abide by all decisions and/or conditions between the legal representative acting on my behalf and the Iredell County Department of Public Health, Environmental Health Division.

X _____ 11/01/2019

Signature of Owner(s) Date

Mooresville - Environmental Health
ronda.hart@co.iredell.nc.us
Fax: 704-662-3239
610 E. Center Avenue, Mooresville, NC 28115

Statesville - Environmental Health
adrienne.shea@co.iredell.nc.us
Fax: 704-871-3483
349 N. Center Street, Statesville, NC 28677