IREDELL COUNTY HEALTH DEPARTMENT

STATESVILLE 704-878-5305 MOORESVILLE 704-664-5281

IMPROVEMENT PERMIT / AUTHORIZATION TO CONSTRUCT / OPERATION PERMIT / EXISTING SYSTEM INSPECTI

50.00 Eq. 2 4.00

PERMIT# 094334 PIN# 4624674237 DATE 9-23-2

OWNER OR CONTRACTOR James Williams PHONE: Business (704) 639-0168 Home

ADDRESS 1602 B. S Boundary Salisbury, NC 28144

LOCATION Brawley School Rd TL Torrence Chapel TL GreyFriars on right 280 Greyfriars

SUBDIVISION GreyFriars BLOCK / SECTION LOT 6 LOT AREA .47Acre SITE CLASS PS DESIGN FLOW 360gpd L.T.A.R. .3+

Septic Tank: 1000 Gallons; STB 525 Date 11-20-02

Pump Tank: 1000 Gallons; PT 302 Date 8-12-02

Pump Make: Zoeller Model N137 Serial No.

Nitrification Field: No Fields 1 Square Feet 630 Linear Feet 210'

No Lines 3 @ 70' Trench Width 24"-36" Max Trench Bottom Depth 30 Gravel Depth N/A

☒ New System ☐ Repair System Type: I, II, III, (IV), V, VI

System Description: Pump-LP Panel BLK

Repair System Description: same

Maintenance Agreement Required: ☒ Yes ☐ No

☒ House/Mod. Home ☐ Mobile Home ☐ Business ☐ Other

No. Bedrooms 3 No. Bathrooms 4 No. Employees


☐ Slab ☒ Crawl Space ☐ Basement w/plumbing ☐ Basement wo/plumbing

Water Supply: ☒ Individual ☐ Public ☐ Community


Comments/Conditions: Keep Septic System at least 10' From PL, 50' from Lake & at least 50' From any well. Trenches will be Slightly deeper on one side

Comments/Conditions: Well variance letter attached Replaces permit dated 7/23/2001. Number of bedrooms Can not exceed 3. Tanks, ~~electrical alarm~~ lines ~~pressure~~

INITIAL SITE SKETCH Scale 1:40

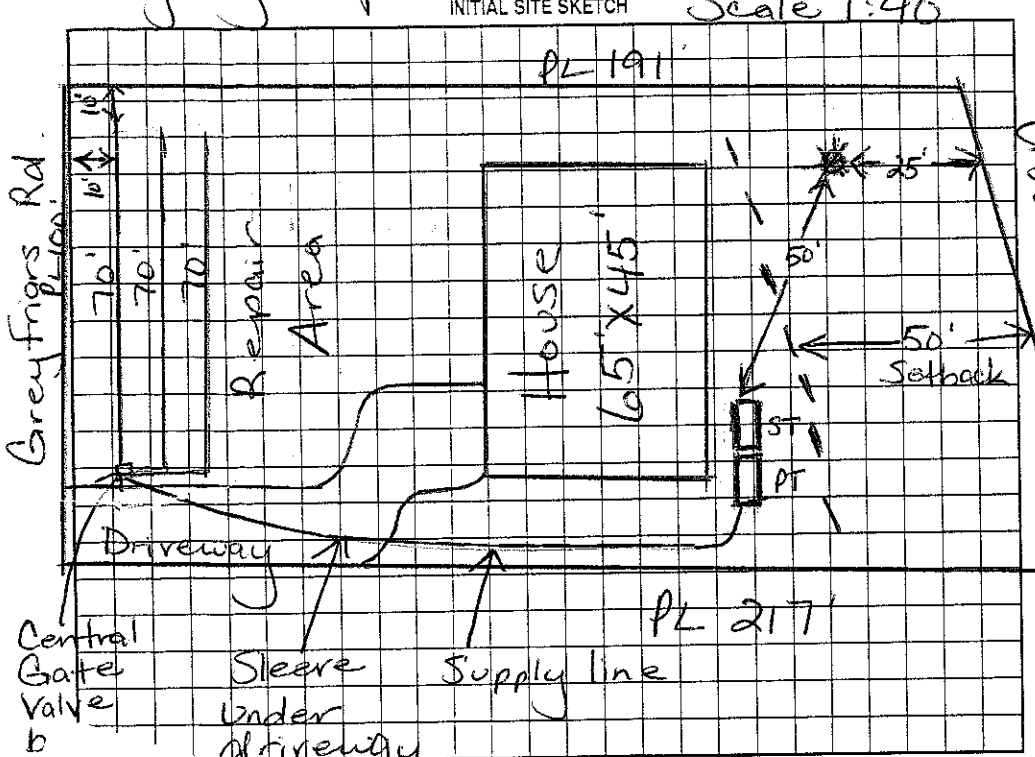

AS BUILT SKETCH

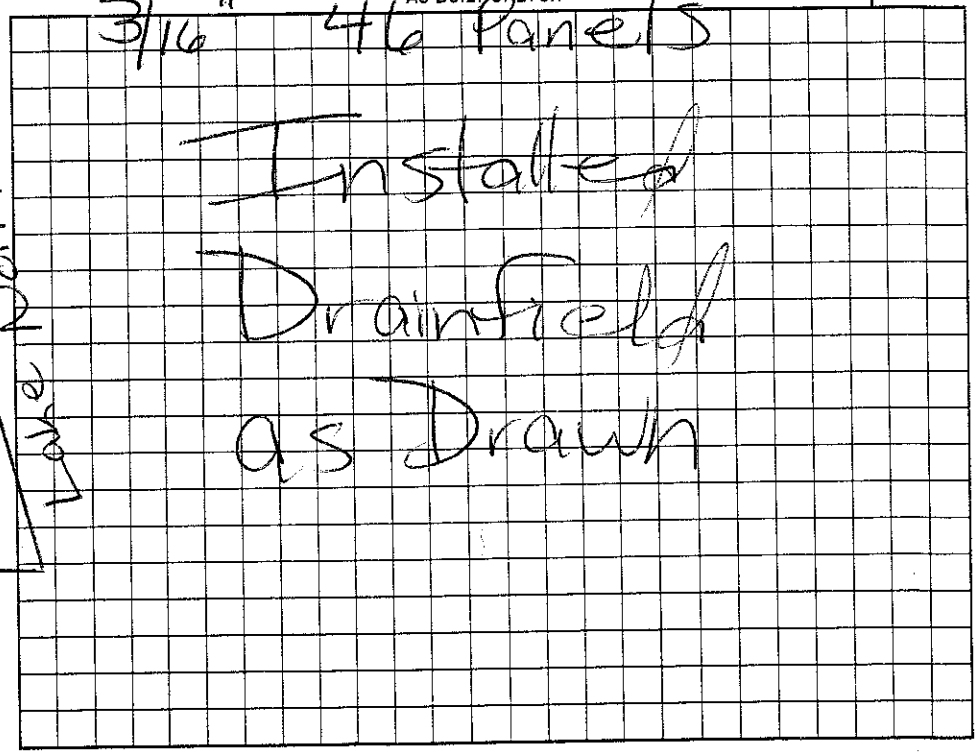

...or revoked if any false information is supplied toward securing the permit/any unauthorized changes are made to the site/any unauthorized changes are made in the installation of the system. Improvement ... Improvement Permit with site plan valid for sixty months. Authorization to Construct is valid for a period equal to that of Improvement Permit – not to exceed sixty months.

date JAN 06-03 Installed by: Mike Barnes Septic

RS date 9/23/02 Operation Permit by: [illegible] date 2/11/03

9/23/02 Existing System Inspection by: date

...COPY (FINAL): YELLOW OWNER COPY (INITIAL): PINK