IREDELL COUNTY HEALTH DEPARTMENT

STATESVILLE 704-878-5305 MOORESVILLE 704-664-5281

IMPROVEMENT PERMIT / AUTHORIZATION TO CONSTRUCT / OPERATION PERMIT / EXISTING SYSTEM INSPECTION

PERMIT# 109532 PIN# ~~4624 27 5705. HZT~~ 4624-67-4680 DATE 2/23/04

OWNER OR CONTRACTOR Dibble Custom Homes PHONE: Business 704-799-1488 Home

ADDRESS PO Box 2355 Cornelius, NC. 28031

LOCATION 1180, TL Torrence Chapel TL Shelburne on (R)

SUBDIVISION Point BLOCK / SECTION 11 LOT 1121 LOT AREA 38,472 FT² SITE CLASS. PS DESIGN FLOW 480 L.T.A.R. .3

Septic Tank: 1500 Gallons; STB 338 Date 11/8/04
Pump Tank: 1000 Gallons; PT 27 Date 1/7/04
Pump Make: Bould Model WE0-312 Serial No. 1/7/04
Nitrification Field: No Fields 1 Square Feet 804 Linear Feet 268
No Lines 4@67 Trench Width 3' Max Trench Bottom Depth 3' Gravel Depth N/A

[X] New System [ ] Repair System Type: I, II, III, (IV) V, VI
System Description: Pres Dosed - 16" PPBPS
Repair System Description: Same Type
Maintenance Agreement Required: [X] Yes [ ] No

[X] House/Mod. Home No. Bedrooms 4
[ ] Mobile Home No. Bathrooms 4
[ ] Business No. Employees
[ ] Other
[ ] Slab [X] Crawl Space [ ] Basement w/plumbing [ ] Basement wo/plumbing

Water Supply:
[ ] Individual
[ ] Public
[X] Community
POINT


Comments:/Conditions:

INITIAL SITE SKETCH

Comments:/Conditions:

Shelburne Place
193

AS BUILT SKETCH

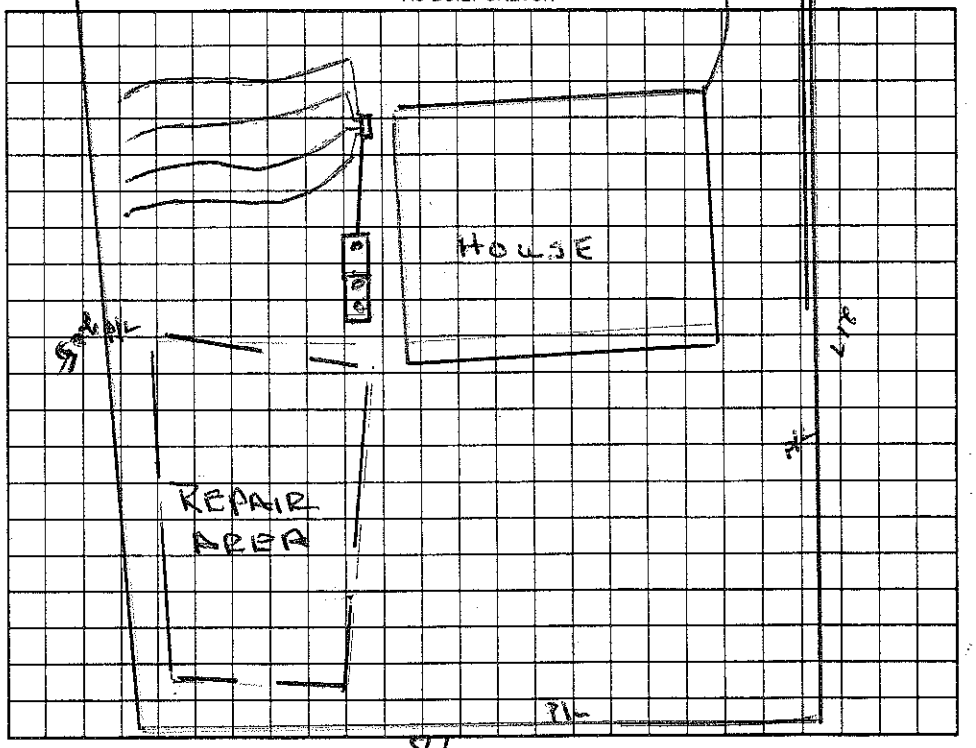

Permit can be suspended or revoked if any false information is supplied toward securing the permit/any unauthorized changes are made to the site/any unauthorized changes are made in the installation of the system. Improvement Permit with plat valid without expiration. Improvement Permit with site plan valid for sixty months. Authorization to Construct is valid for a period equal to that of Improvement Permit – not to exceed sixty months.

Signed: _____ date _____

Improvement Permit by: _____ date _____

Authorization to Construct by: _____ date _____

Installed by: Orbison Const.

Operation Permit by: Willy Sparks RS. date 5/17/04

Existing System Inspection by: Willy Sparks RS. date 5/17/04

HEALTH DEPT. COPY: WHITE OWNER COPY (FINAL): YELLOW OWNER COPY (INITIAL): PINK