IREDELL COUNTY HEALTH DEPARTMENT

STATESVILLE 704-878-5305 MOORESVILLE 704-664-5281

IMPROVEMENT PERMIT / AUTHORIZATION TO CONSTRUCT / OPERATION PERMIT / EXISTING SYSTEM INSPECTION

PERMIT # 159762 PIN # 4624-67-5150 DATE 4-7-10

OWNER or APPLICANT FRANCIS & DAVID BENDERT PHONE: Business 704-660-5062 Home: JOHN PAUL BUILDERS

OWNER or APPLICANT ADDRESS 288 GREYFRIARS RD MOORESVILLE NC 28117

LOCATION / DIRECTIONS BSR, GREYFRIARS, 288

SUBDIVISION GREYFRIARS COVE BLOCK / SECTION LOT # 4 .44AC DESIGN FLOW 480 GPD L.T.A.R. .3

Septic Tank EX. 1000 Gallons: STB

Pump Tank EX. 1000 Gallons: P T

Pump Make Model

Nitrification Field No Fields 1 No Lines 2 Linear F

Trench Width 24-36" Max. Trench Bottom Depth

Date

	Date	Initials
Drain Lines Checked	10-11	BA
Tanks Checked	10-11	BA
Pressure Manifold or Valve Box Checked	10-11	BA
Pressure Head Set	10-11	BA
Electrical Checked	12-10	BA
Floats Set	12-10	BA
Alarm Checked	12-10	BA
Maintenance Contract (Y) / N	12-10	BA


II III (IV) V VI

☒ Residence No. Bedrooms 4
☐ Business No. Persons
☒ Other No. Employees
☐ Slab ☒ Crawl Space
☐ Basement w/plumbing ☐ Basement w/o plumbing

Water Supply: ☒ Private ☐ Public ☐ Community

Comments / Conditions 1) 3 LINES CLOSEST TO HOUSE SHORTEN TO 35, 35 & 30 2) LINES SHOWN 3) GARAGE MUST BE 5' ATTACHED TO HOUSE W/ CRAWL SPACE W/ PLUMBING

INITIAL SITE SKETCH

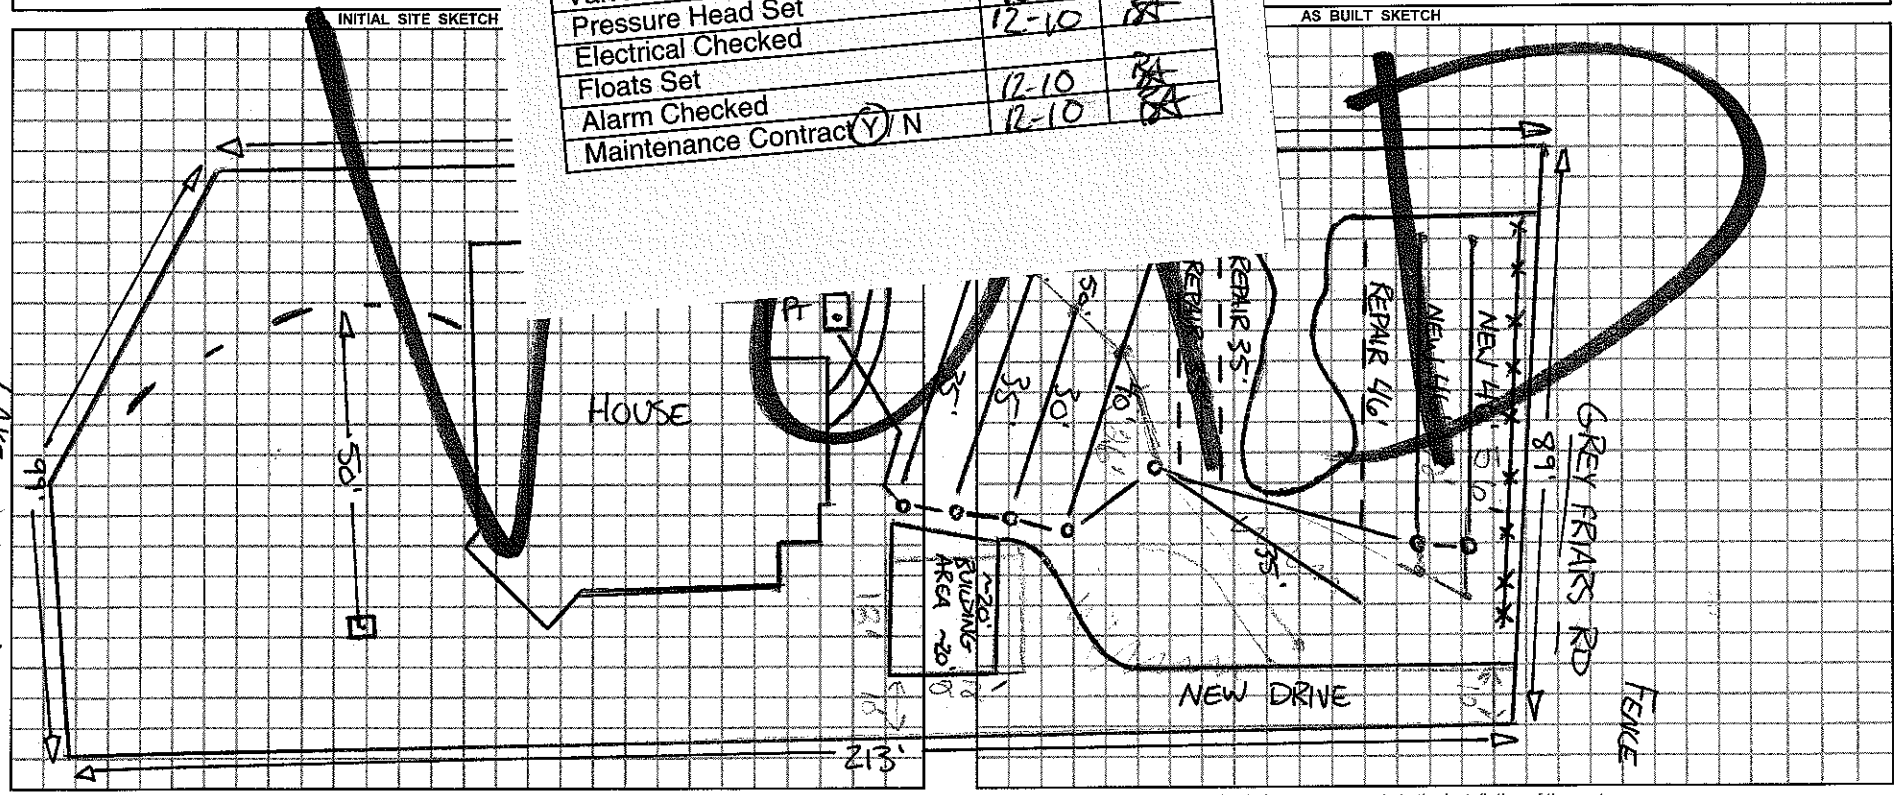

AS BUILT SKETCH

Permit can be suspended or revoked if any false information is supplied toward securing the permit / any unauthorized changes are made to the site / any unauthorized changes are made in the installation of the system.

☐ *IMPROVEMENT PERMIT w / plat valid without expiration.* ☐ *IMPROVEMENT PERMIT w / site plan valid for 60 mos.* ☒ *AUTHORIZATION TO CONSTRUCT valid for period equal to IMPROVEMENT PERMIT-not to exceed 60 mo.*

Owner / Applicant Signature: Date

Improvement Permit by: REHS Date 4-7-10

Authorzation to Construct by: REHS Date 4-7-10

YOU SHOULD CONTACT A LOCATOR SERVICE PRIOR TO ANY EXCAVATION.

Installed by:

Operation Permit by: Date:

Existing System Inspected by: Date:

WHITE COPY Environmental Health YELLOW COPY (Final) Owner / Applicant PINK COPY (Initial) Owner / Applicant