3:00 pm

# IREDELL COUNTY HEALTH DEPARTMENT

STATESVILLE 704-878-5305 MOORESVILLE 704-664-5281

## IMPROVEMENT PERMIT / AUTHORIZATION TO CONSTRUCT / OPERATION PERMIT / EXISTING SYSTEM INSPECTION

PERMIT # 174320 PIN # 4624676766 DATE 9-12-2012

OWNER or APPLICANT KENNETH BEALER HOMES PHONE: Business 704 889-1600 Home:

OWNER or APPLICANT ADDRESS 1106 Oakley Ave Kineville, NC. 28134

LOCATION / DIRECTIONS Brawley School Rd TL Torrence Chapel TL Shellbourne Pl on left near end

SUBDIVISION The Point BLOCK / SECTION 11 LOT # 1127/1127A LOT AREA .785Ac+ DESIGN FLOW 600 L.T.A.R. .3

| | | | | | | | |
|---|---|---|---|---|---|---|---|
| Septic Tank | 1500 | Gallons: STB | 338 | Date | 12-20-13 | [X] New System [ ] Repair [ ] Expansion System Type I II (III) IV V VI | [X] Residence No. Bedrooms 5 |
| Pump Tank | 1500 | Gallons: PT | 477 | Date | 11-13-13 | System Description: Pump-PM-25% Reduction | [ ] Business No. Persons |
| Pump Make | | Model | | Serial # | | Repair System Description: Same | [ ] Other No. Employees |
| Nitrification Field | No Fields 1 | No Lines 4 | Linear Feet 500 | | | Maintenance Agreement Required [ ] YES [X] NO | [ ] Slab [X] Crawl Space |
| Trench Width | 36" | Max. Trench Bottom Depth | 36" | Gravel Depth | N/A | [ ] GRAVITY [X] PRESSURE | [ ] Basement w/plumbing [ ] Basement w/o plumbing |


Water Supply: [ ] Private [ ] Public [X] Community

Comments / Conditions: Follow Specifications for Septic Systems in Crescent Communities

Supply line ~ left from PL @ 22" under water line

Scale 1:50

INITIAL SITE SKETCH

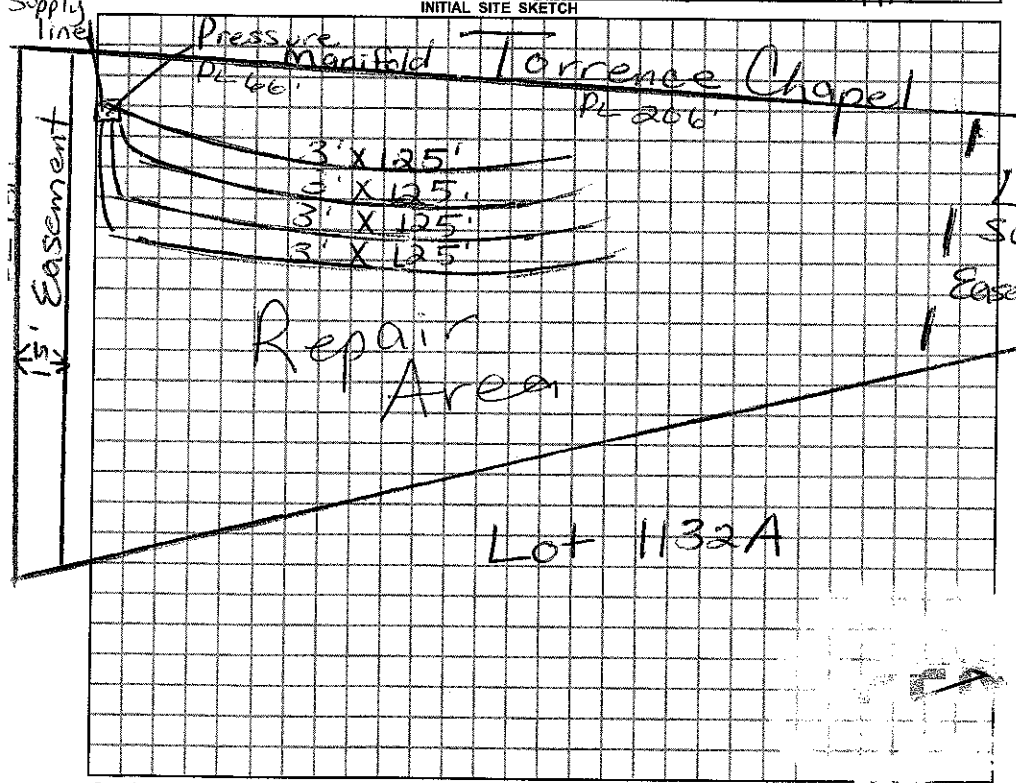



Comments / Conditions

5/13/14 Checked lines Norman Lake

Quick 4 installed as drawn. Extra Chamber in 3rd line

AS BUILT SKETCH

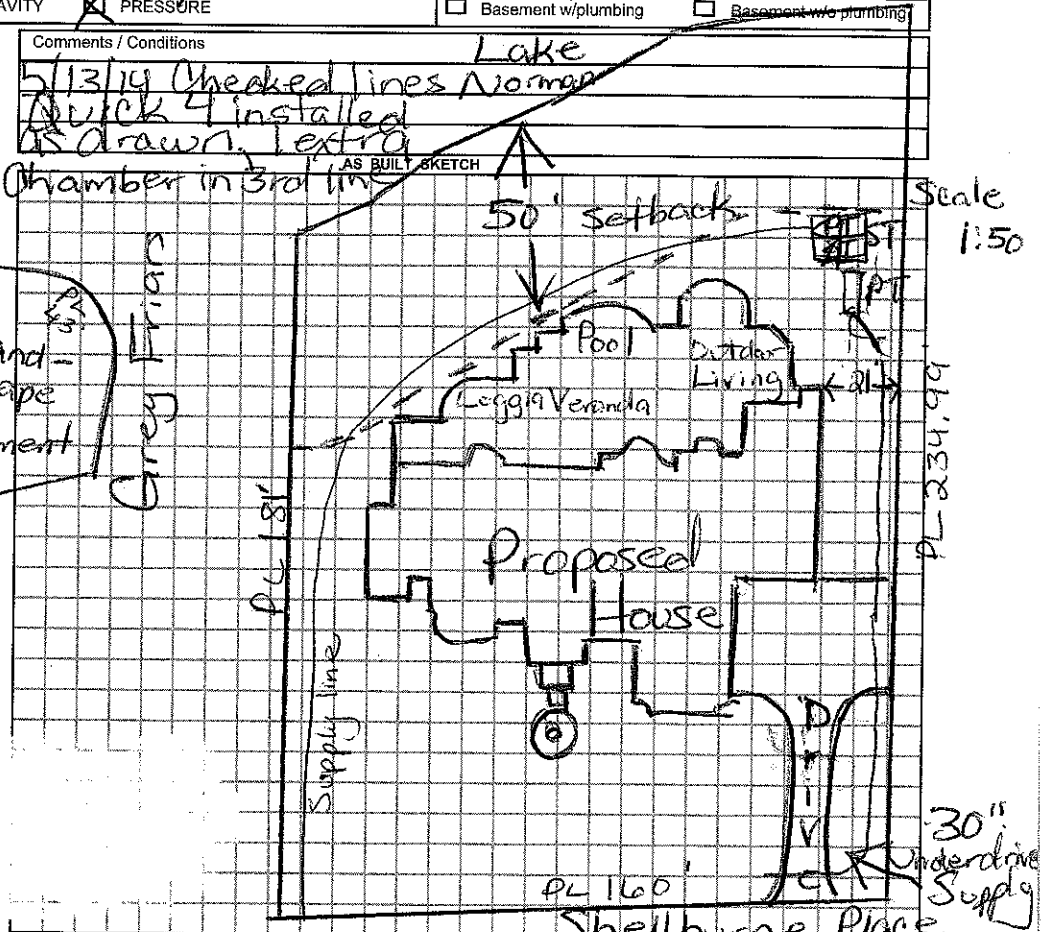


*Permit can be suspended or revoked if any false information is supplied toward securing the permit / any unauthorized changes are made to the site / any unauthorized changes are made in the installation of the system.*

[ ] IMPROVEMENT PERMIT w / plat valid without expiration. [ ] IMPROVEMENT PERMIT w / site plan valid for 60 mos. [X] AUTHORIZATION TO CONSTRUCT valid for period equal to IMPROVEMENT PERMIT-not to exceed 60 mo.

Owner / Applicant Signature: Kenneth Bealer Date 11/29/13

Improvement Permit by: Marie Hall Elam RS Date 9/12/12

Authorization to Construct by: Marie Hall Elam RS Date 9/13/12

Installed by: Piedmont Backhoe

Operation Permit by: [signature] Date: 10-13-14

Existing System Inspected by: Date:

***YOU SHOULD CONTACT A LOCATOR SERVICE PRIOR TO ANY EXCAVATION.***

WHITE COPY Environmental Health YELLOW COPY (Final) Owner / Applicant PINK COPY (Initial) Owner / Applicant