IREDELL COUNTY HEALTH DEPARTMENT

STATESVILLE 704-878-5305 MOORESVILLE 704-664-5281

IMPROVEMENT PERMIT / AUTHORIZATION TO CONSTRUCT / OPERATION PERMIT / EXISTING SYSTEM INSPECTION

PERMIT# 108132 PIN# 4624-27-5505, 1126 4624-67-8606 DATE 6/24/05

OWNER OR CONTRACTOR Simonini Bldrs PHONE: Business 704 35-8 9940 Home

ADDRESS 1910 South Blvd Charlotte NC

LOCATION NSR, TL Torrence Chapel, TL Shelburne, on Lt Near end

SUBDIVISION Point BLOCK / SECTION 11 LOT 1126 LOT AREA 40,640 Ft.² SITE CLASS. PS DESIGN FLOW 600 L.T.A.R. 0.3

Septic Tank: 1500 Gallons; STB 338 Date 9-20-05
Pump Tank: 1500 Gallons; PT 477 Date 10-22-05
Pump Make: Myers Model ME 50 Serial No.
Nitrification Field: No Fields 1 Square Feet 990 Linear Feet 330
No Lines 3 Trench Width 36" Max Trench Bottom Depth 36" Gravel Depth —

☒ New System ☐ Repair System Type: I, II, III, (IV), V, VI
System Description: LP Panel Block
Repair System Description: 59mm
Maintenance Agreement Required: ☒ Yes ☐ No

☒ House/Mod. Home No. Bedrooms 5
☐ Mobile Home No. Bathrooms
☐ Business No. Employees
☐ Other


☐ Slab ☐ Crawl Space ☒ Basement w/plumbing ☐ Basement wo/plumbing

Water Supply: ☐ Individual ☐ Public ☒ Community

Comments:/Conditions:


Comments:/Conditions: Cheaked lines 4/6/06
Cheaked tanks 4/7/06
3/16" hole drilled
Needs caulk & change tie wraps

INITIAL SITE SKETCH

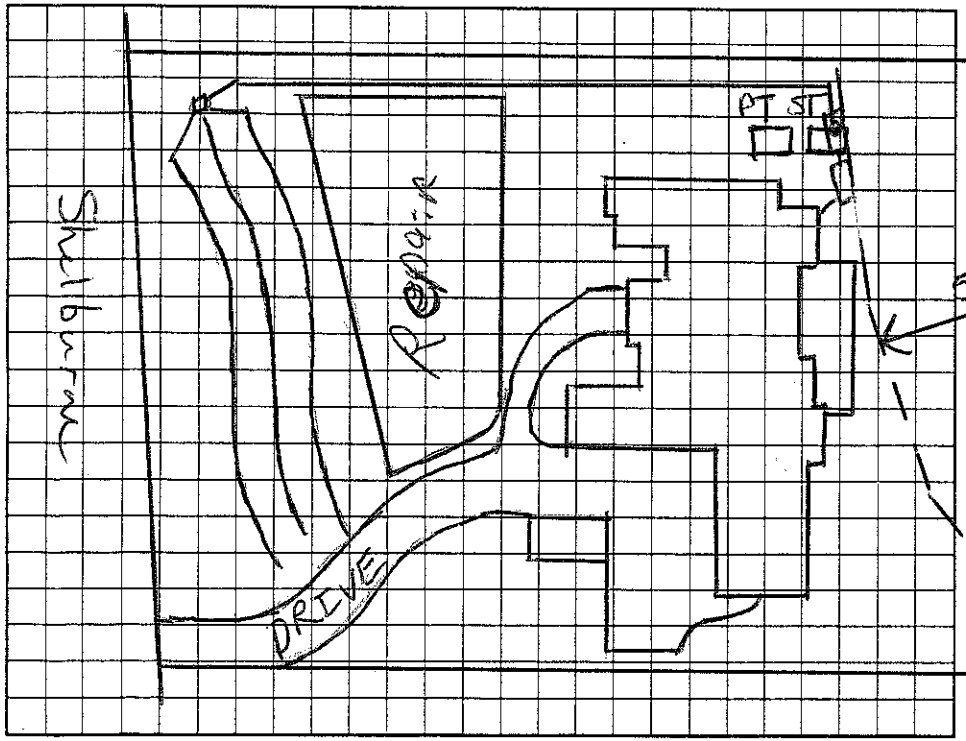

AS BUILT SKETCH

Installed as Drawn

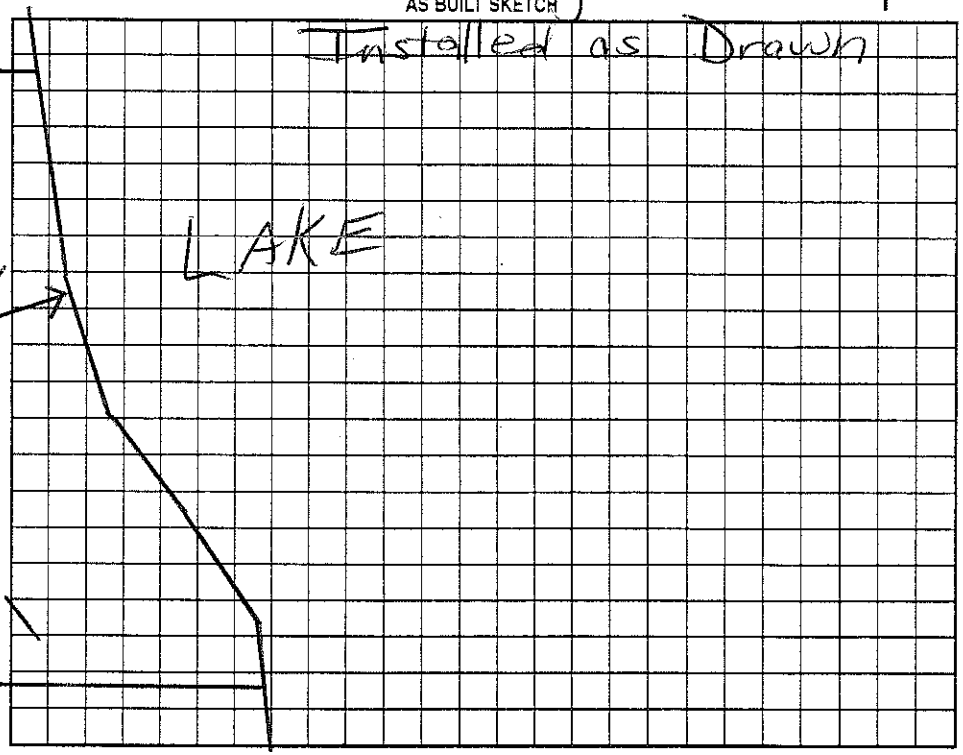

Permit can be suspended or revoked if any false information is supplied toward securing the permit/any unauthorized changes are made to the site/any unauthorized changes are made in the installation of the system. Improvement Permit with plat valid without expiration. Improvement Permit with site plan valid for sixty months. Authorization to Construct is valid for a period equal to that of Improvement Permit – not to exceed sixty months.

Signed: date 6-30-05 Installed by: R&H Dozer RS

Improvement Permit by: RS date 6/24/05 Operation Permit by: Manual Dozer date 11/14/06

Authorization to Construct by: RS date 6/24/05 Existing System Inspection by: date

HEALTH DEPT. COPY: WHITE OWNER COPY (FINAL): YELLOW OWNER COPY (INITIAL): PINK