IREDELL COUNTY HEALTH DEPARTMENT

STATESVILLE 704-878-5305 MOORESVILLE 704-664-5281

$195.00

IMPROVEMENT PERMIT / AUTHORIZATION TO CONSTRUCT / OPERATION PERMIT / EXISTING SYSTEM INSPECTION

PERMIT# 108130 PIN# 4624-67-9534 DATE 2/17/03

OWNER OR CONTRACTOR ~~Lakeland Luxury Inc.~~ ELRODHOMES PHONE: Business 708-361-5991 Home

ADDRESS 16405 D Northcross Dr. Huntersville NC 28078

LOCATION Brawley Sch, TL Torrence Chapel, TL Shelbourne PL, at end on Ct.

SUBDIVISION The Point BLOCK / SECTION 11 LOT 1125 LOT AREA 47,416 Ft² SITE CLASS. PS DESIGN FLOW 600 L.T.A.R. 0.3

Septic Tank: 1500 Gallons; STB 338 Date 6/18/04
Pump Tank: 1500 Gallons; PT 338 Date 6/18/04
Pump Make: Gould's Model Well Sys Hwy Serial No. Fo 0113123
Nitrification Field: No Fields 1 Square Feet 990 Linear Feet 330
No Lines 3 @ 110' Trench Width 36" Max Trench Bottom Depth 36" Gravel Depth —

☒ New System ☐ Repair System Type: I, II, III, (IV), V, VI
System Description: LP Panel Block
Repair System Description: Same
Maintenance Agreement Required: ☒ Yes ☐ No

☒ House/Mod. Home ☐ Mobile Home ☐ Business ☐ Other
No. Bedrooms 5 No. Bathrooms 6 No. Employees


☐ Slab ☒ Crawl Space ☒ Basement w/plumbing ☐ Basement wo/plumbing

Water Supply: ☐ Individual ☐ Public ☒ Community


Comments/Conditions: Drive may be move to opposite side of lot - Supply line may need to be sleeved or moved

Comments/Conditions: 11/1/05 Tanks, lines & pressure checked by WS

INITIAL SITE SKETCH

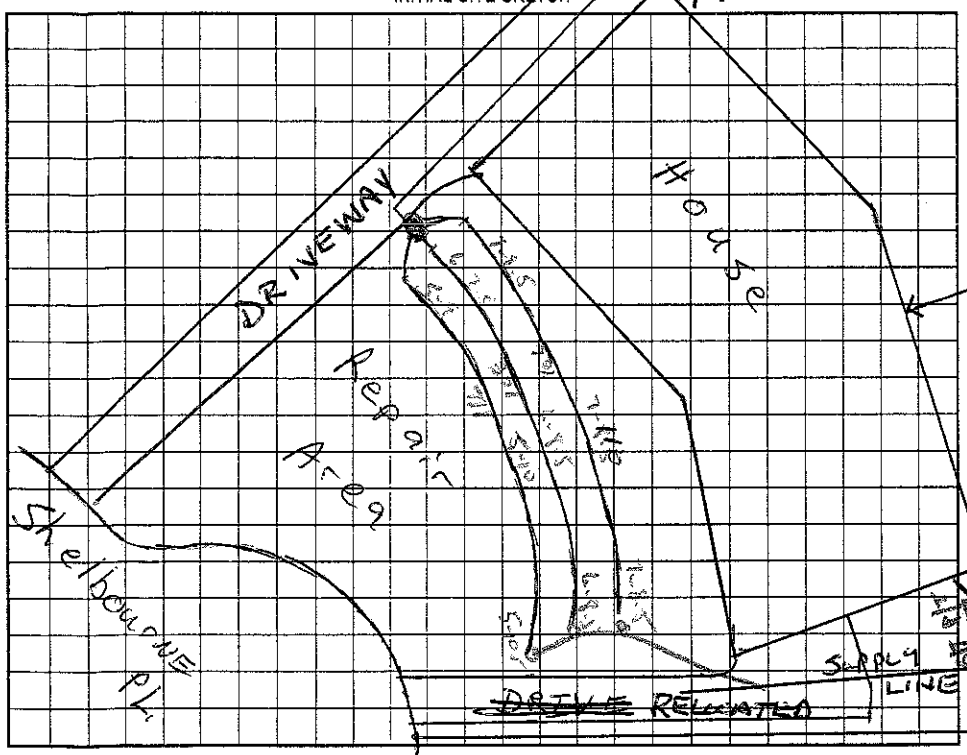

AS BUILT SKETCH

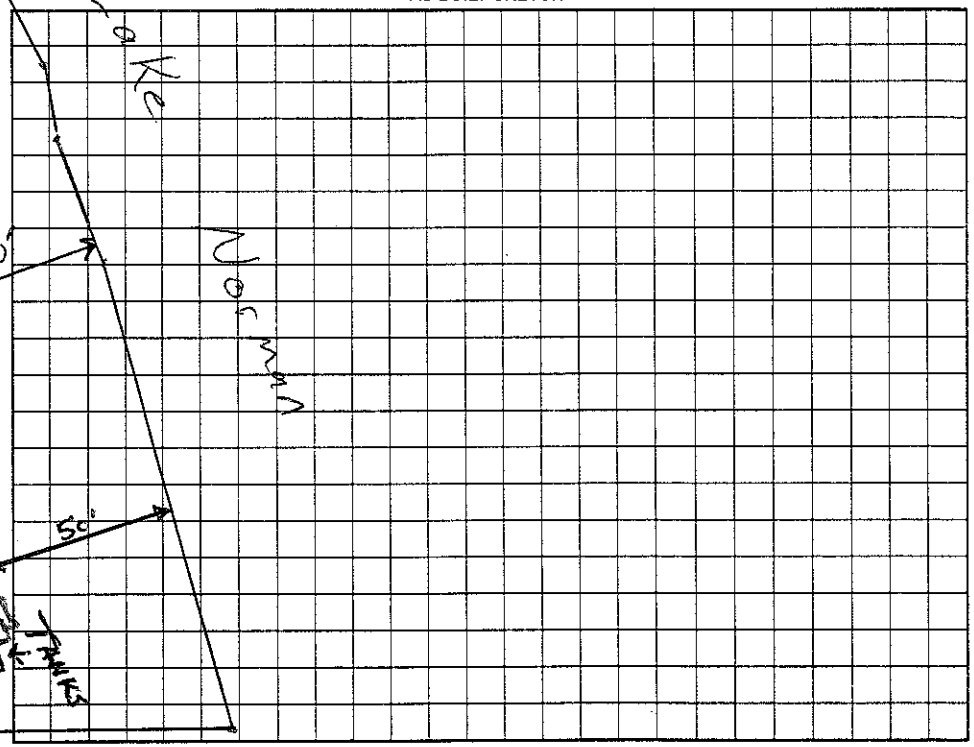

Permit can be suspended or revoked if any false information is supplied toward securing the permit/any unauthorized changes are made to the site/any unauthorized changes are made in the installation of the system. Improvement Permit with plat valid without expiration. Improvement Permit with site plan valid for sixty months. Authorization to Construct is valid for a period equal to that of Improvement Permit – not to exceed sixty months.

Signed: [signature] OSS date 7/15/02

Improvement Permit by: [signature] RS date 2/17/03

Authorization to Construct by: Wesley Sparks R.S. date 6/23/03

Installed by: Orbison RS

Operation Permit by: [signature] date 11/1/05

Existing System Inspection by: date

HEALTH DEPT. COPY: WHITE OWNER COPY (FINAL): YELLOW OWNER COPY (INITIAL): PINK