IREDELL COUNTY HEALTH DEPARTMENT

STATESVILLE 704-878-5305 MOORESVILLE 704-664-5281

IMPROVEMENT PERMIT / AUTHORIZATION TO CONSTRUCT / OPERATION PERMIT / EXISTING SYSTEM INSPECTION

PERMIT# 108135 PIN# 4624684948 DATE 12-18-07

OWNER OR APPLICANT Zande Homes PHONE: Business 704-660-5429 Home

ADDRESS 107 N. Main St. Mooresville NC 28115

LOCATION Brawley School Rd. Th Torrence Chapel Th Shelburne

SUBDIVISION The Point BLOCK / SECTION 11 LOT 1129 LOT AREA 39348 sq. ft. SITE CLASS. PS DESIGN FLOW 480 gpd L.T.A.R. .25 gpd/EFF

Septic Tank: 1000 Gallons: ST8 338 Date 4-9-07

Pump Tank: 1000 Gallons: PT 283 Date 4-9-07

Pump Make: Goulds Model WE0312MU Serial No.

Nitrification Field: No Fields 1 Square Feet 1440 Linear Feet 480

No Lines 6@80' Trench Width 36" Max Trench Bottom Depth 36"

☒ New System ☐ Repair ☐ Expansion System Type: I II III IV V VI

System Description: 25% reduction pm

Repair System Description: 25% reduction pm on 1129A

Maintenance Agreement Required: ☐ Yes ☒ No

☒ House/Mod. Home ☐ Mobile Home ☐ Business ☐ Other

No. Bedrooms 4 No. Persons 8 No. Employees


Water Supply: ☐ Individual ☒ Public ☒ Community

Gravel Depth NA ☐ Gravity ☒ Pressure ☐ Slab ☒ Crawl Space ☐ Basement w/plumbing ☐ Basement wo/plumbing


Comments:/Conditions: 1/3/08 Cheaked lines Quick 4 installed

Comments:/Conditions: Repair offsite 12-13-07 1500g. ST Blue Poly/ok filter 1000g. PT 1/3 HP 4/25/08 Pressure (2ft), elect ok/alarm

INITIAL SITE SKETCH

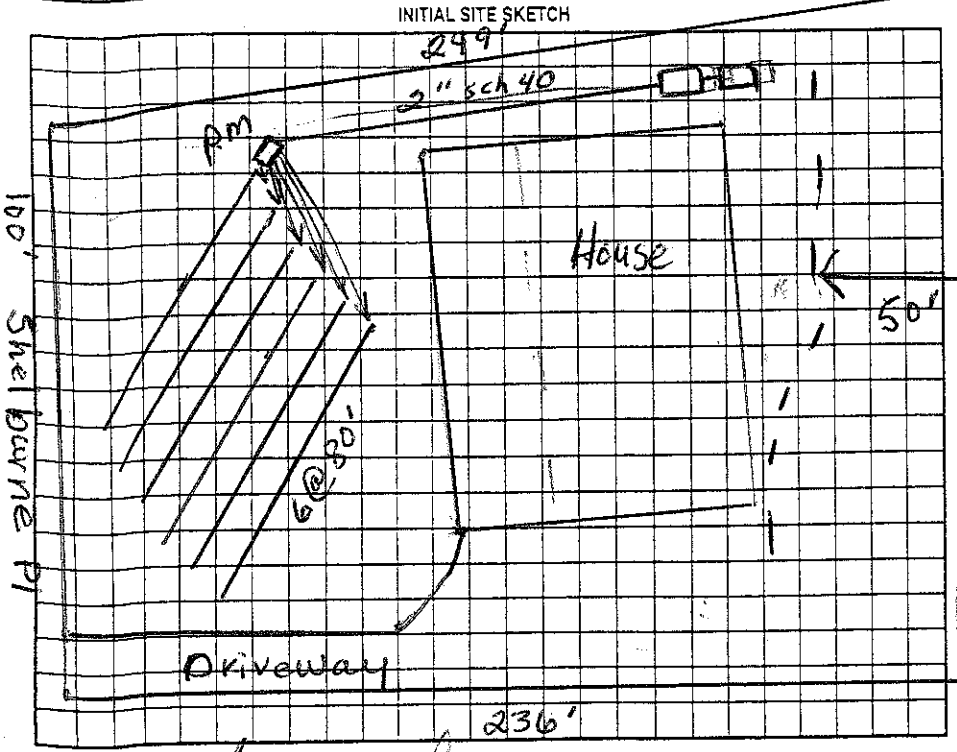

AS BUILT SKETCH

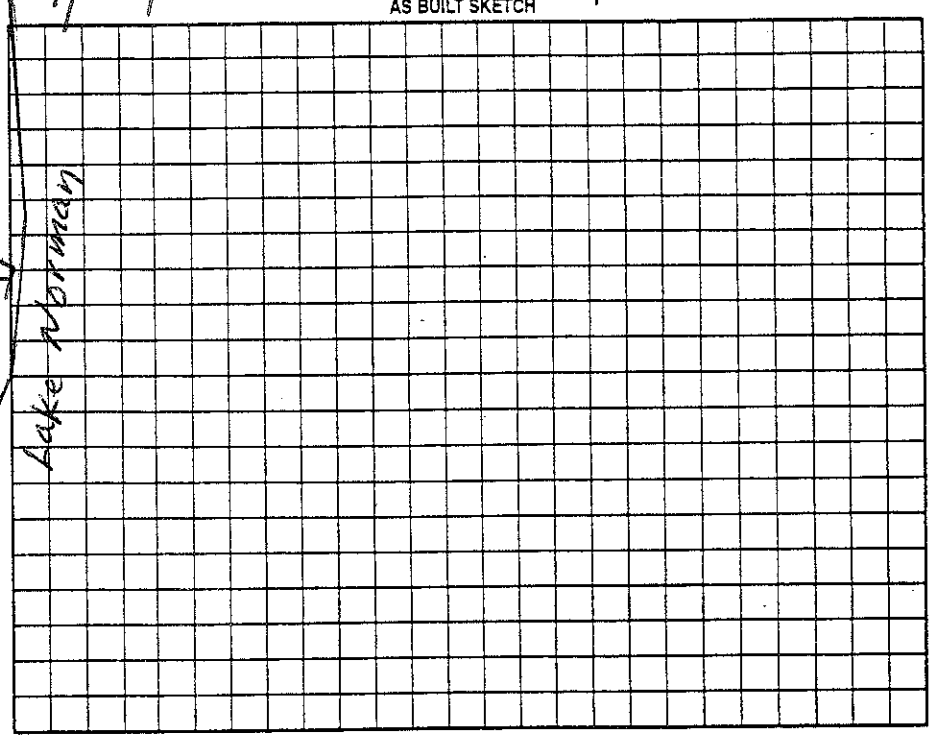

Permit can be suspended or revoked if any false information is supplied toward securing the permit/any unauthorized changes are made to the site/any unauthorized changes are made in the installation of the system. Improvement Permit with plat valid without expiration ☐ Improvement Permit with site plan valid for sixty months ☒ Authorization to Construct is valid for a period equal to that of Improvement Permit – not to exceed sixty months.

Sworn by: date 12/20/07 Installed by: R+H

by: Judy Melville date 12-19-07 Operation Permit by: KS date 4/25/08

Construct by: Judy Melville date 12-19-07 Existing System Inspection by: date

HEALTH DEPT. COPY: WHITE OWNER COPY (FINAL): YELLOW OWNER COPY (INITIAL): PINK