IREDELL COUNTY HEALTH DEPARTMENT

STATESVILLE 704-878-5305 MOORESVILLE 704-664-5281

IMPROVEMENT PERMIT / AUTHORIZATION TO CONSTRUCT / OPERATION PERMIT / EXISTING SYSTEM INSPECTION

PERMIT# 114556 PIN# 4625 TI 7476 et 4624-69-2874 DATE 4/10/06

OWNER OR APPLICANT Kenneth Beaver Homes PHONE: Business 704-746-4669 Home

ADDRESS PO Box 3398 Mooresville, NC 28117

LOCATION 1100 TL New Haven TR Lynnfield at end of cul de sac (9-16)

SUBDIVISION Point BLOCK / SECTION 12 LOT 1201 LOT AREA 1.0AC ± SITE CLASS. PS DESIGN FLOW 600 L.T.A.R. .3

Septic Tank: 1500 Gallons; STB 338 Date 4-25-06
Pump Tank: 1500 Gallons; PT 477 Date 4-16-06
Pump Make: Myers Model Wee-512 Serial No.
Nitrification Field: No Fields 1 Square Feet 666 Linear Feet 333
No Lines 3@111 Trench Width 2 Max Trench Bottom Depth 3'

☒ New System ☐ Repair ☐ Expansion System Type: I II III IV V VI
System Description: LP - PBPS
Repair System Description: SAME
Maintenance Agreement Required: ☒ Yes ☐ No

☒ House/Mod. Home No. Bedrooms 5
☐ Mobile Home No. Persons 4
☐ Business No. Employees
☐ Other

Water Supply: ☐ Individual ☐ Public ☒ Community POINT


Gravel Depth No ☐ Gravity ☒ Pressure ☐ Slab ☐ Crawl Space ☒ Basement w/plumbing ☐ Basement wo/plumbing

Comments/Conditions: Checked tanks 7/12/06 TMR
Checked lines 11/13/06


Comments/Conditions: ☒ Must keep pool cut at least 15ft from Septic lines & tanks

NOT TO SCALE

INITIAL SITE SKETCH

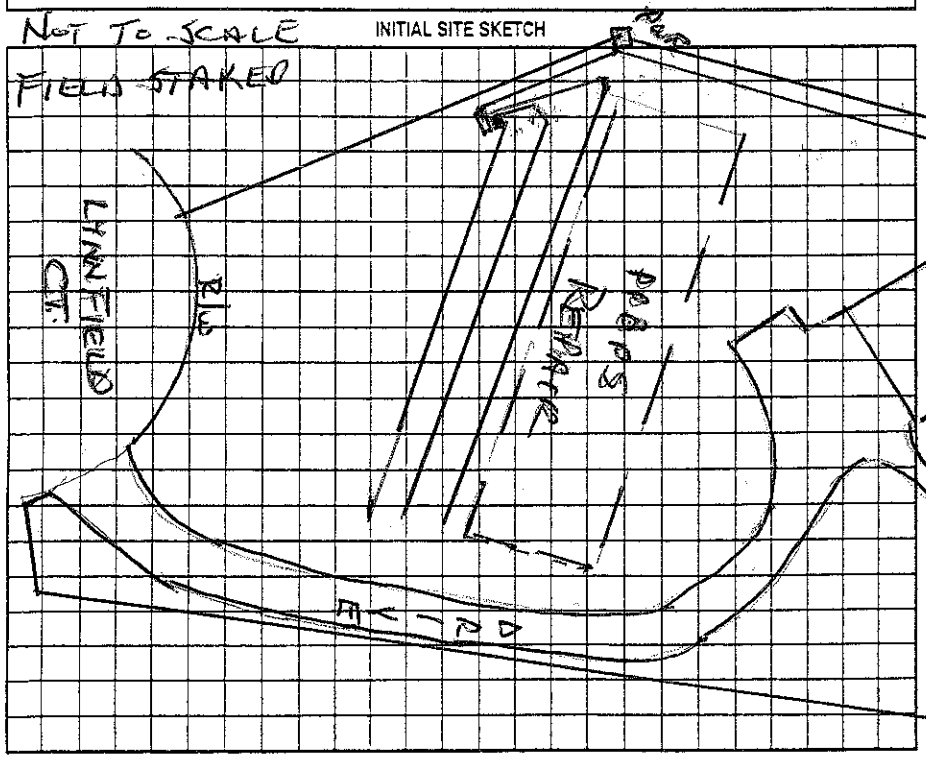

AS BUILT SKETCH

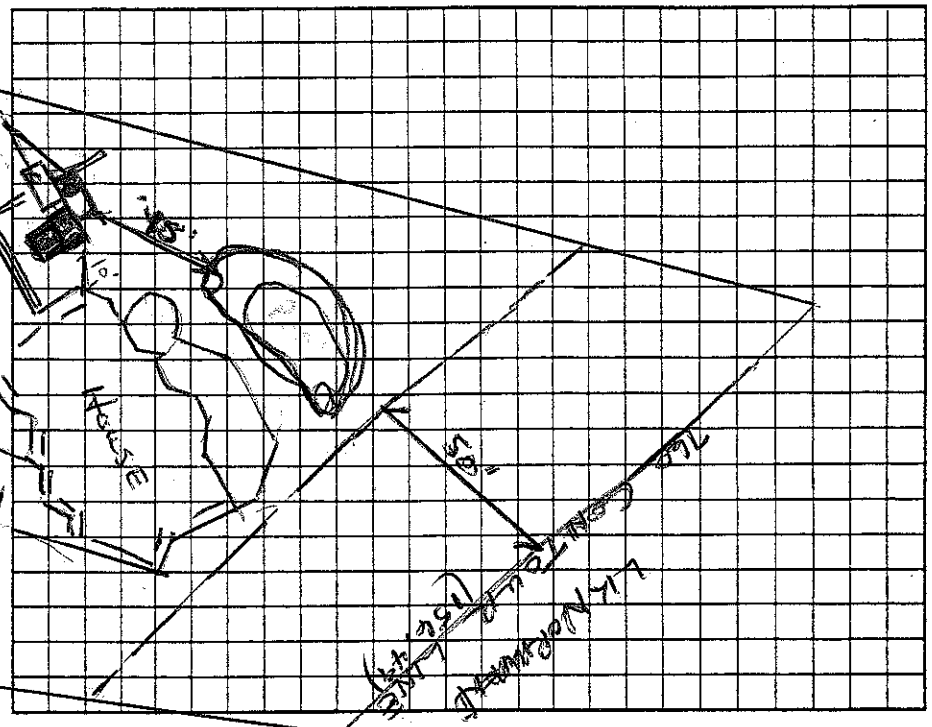

Permit can be suspended or revoked if any false information is supplied toward securing the permit/any unauthorized changes are made to the site/any unauthorized changes are made in the installation of the system. Improvement Permit with plat valid without expiration ☐ Improvement Permit with site plan valid for sixty months ☐ Authorization to Construct is valid for a period equal to that of Improvement Permit – not to exceed sixty months.

Signed: [signature] date 4/16/06

Improvement Permit by: Wesley Sparks R.S. date 4/10/06

Authorization to Construct by: Wesley Sparks R.S. date 4/10/06

Installed by: R-Hougland Hallmon unveld PIT

Operation Permit by: Wesley Sparks R.S. date 2/28/07

Existing System Inspection by: date

HEALTH DEPT. COPY: WHITE OWNER COPY (FINAL): YELLOW OWNER COPY (INITIAL): PINK