IREDELL COUNTY HEALTH DEPARTMENT

STATESVILLE 704-878-5305 MOORESVILLE 704-664-5281

130

IMPROVEMENT PERMIT / AUTHORIZATION TO CONSTRUCT / OPERATION PERMIT / EXISTING SYSTEM INSPECTION

PERMIT# 114566 PIN# ~~4625-71-7476.9~~ ~~4624980970~~ 4624698676 DATE 9/5/03

OWNER OR CONTRACTOR POINT ON NORMAN / Kingswood PHONE: Business 660-1185 Home

ADDRESS 2214 BRAWLEY SCHOOL - MOORESVILLE NC 28117

LOCATION BRAWLEY SCHOOL - T L NEW HAVEN - T R SOUTH LONG YELLOW - AT END ON RT

SUBDIVISION POINT BLOCK / SECTION 12 LOT 209 LOT AREA 42889 SITE CLASS. RS DESIGN FLOW 480.00 L.T.A.R. .36 PP/AC

Septic Tank: 1500 Gallons; STB 338 Date 10/5/04

Pump Tank: _____ Gallons; PT _____ Date _____

Pump Make: _____ Model _____ Serial No. _____

Nitrification Field: No Fields 1 Square Feet 1200 Linear Feet 400

No Lines 5@80 Trench Width 36" Max Trench Bottom Depth 36" Gravel Depth N/A

☑ New System ☐ Repair System Type: I, II, (III), IV, V, VI

System Description: GRAVITY 25% REDUCTION

Repair System Description: LP PANEL

Maintenance Agreement Required: ☐ Yes ☑ No

☑ House/Mod. Home No. Bedrooms 4

☐ Mobile Home No. Bathrooms 4

☐ Business No. Employees

☐ Other


☐ Slab ☑ Crawl Space ☐ Basement w/plumbing ☐ Basement wo/plumbing

Water Supply: ☐ Individual ☐ Public ☑ Community


Comments:/Conditions: Reviewed Building plans & site plans; essentially in Compliance with I.P. 6/15/04 Changes essentially conform to Plan Permit Area 1"=50'

Comments:/Conditions: 4@160' x 3' EZFLOW

INITIAL SITE SKETCH

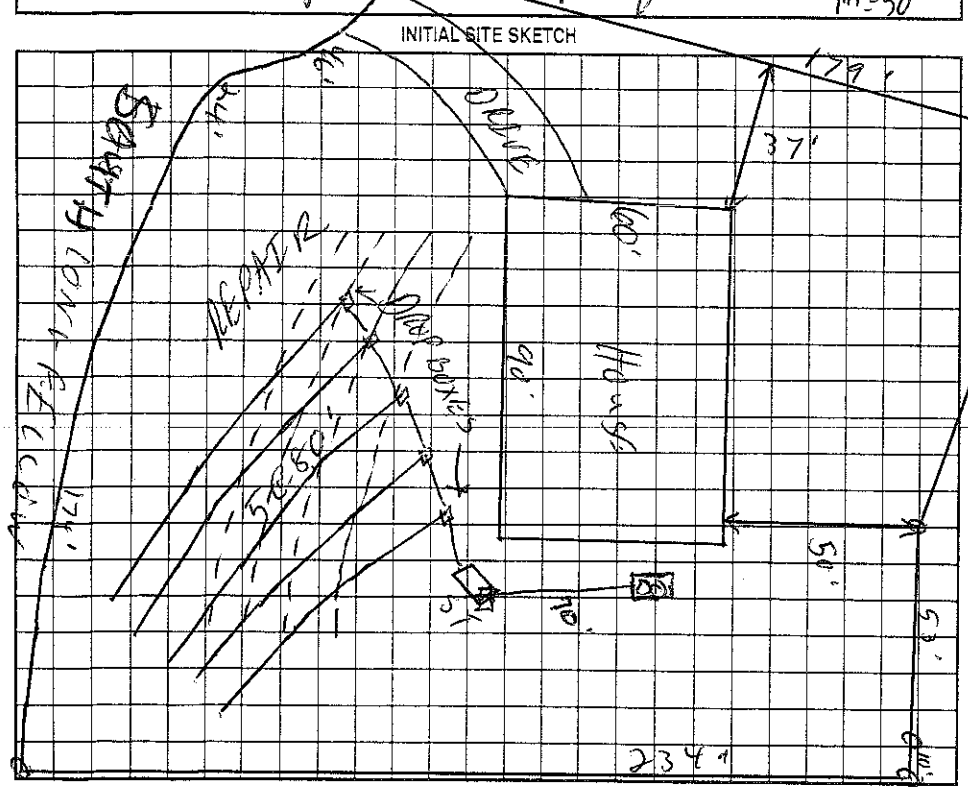

AS BUILT SKETCH

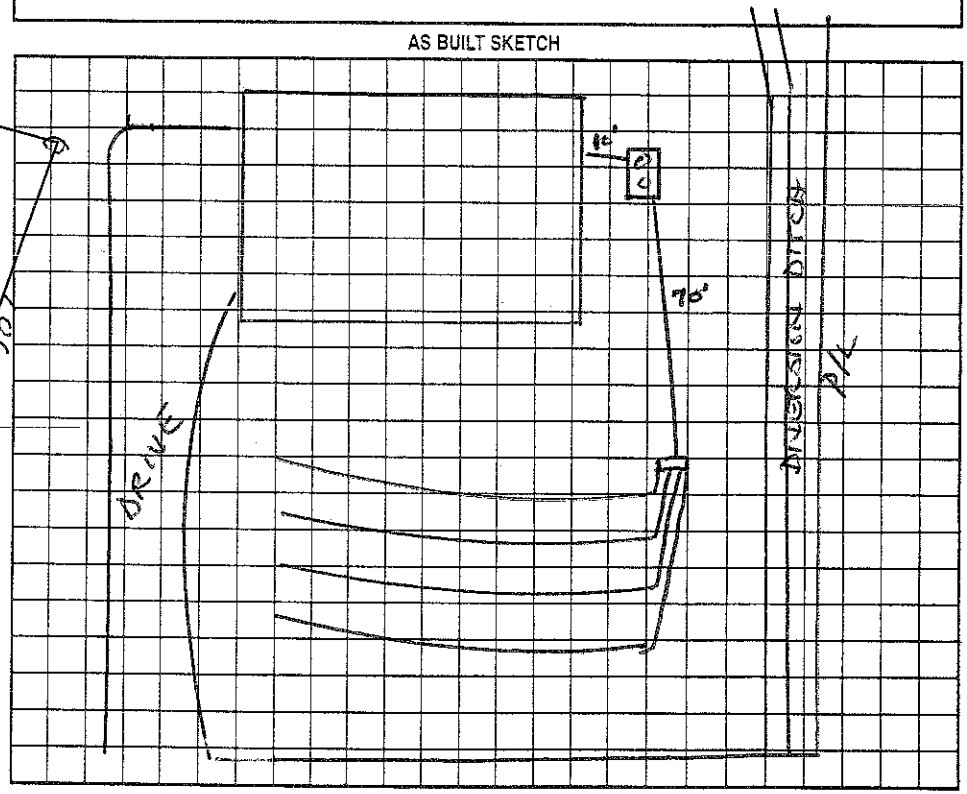

Permit can be suspended or revoked if any false information is supplied toward securing the permit/any unauthorized changes are made to the site/any unauthorized changes are made in the installation of the system. Improvement Permit with plat valid without expiration; Improvement Permit with site plan valid for sixty months. Authorization to Construct is valid for a period equal to that of Improvement Permit – not to exceed sixty months.

Signed: _____ date 9-23-03 Installed by: Hallman Const. Co.

Improvement Permit by: C. _____ RS date 9/5/03 Operation Permit by: Wesley Sparks RS date 12/16/04

Authorization to Construct by: Maria H. Dalton RS date 4/6/04 Existing System Inspection by: _____ date _____

HEALTH DEPT. COPY: WHITE OWNER COPY (FINAL): YELLOW OWNER COPY (INITIAL): PINK