IREDELL COUNTY HEALTH DEPARTMENT

STATESVILLE 704-878-5305 MOORESVILLE 704-664-5281

~~1:30~~ 10:30

IMPROVEMENT PERMIT / AUTHORIZATION TO CONSTRUCT / OPERATION PERMIT / EXISTING SYSTEM INSPECTION

PERMIT# 114638 PIN# 4625 71 7476.15 4624-79-1536 DATE 9/8/03

OWNER OR CONTRACTOR POINT ON NORMAN / GM Helms PHONE: Business 660-1185 Home

ADDRESS 2214 BRAWLEY SCHOOL RD. MOORESVILLE NC 28115

LOCATION BRAWLEY SCHOOL - TR NEW HAVEN - TR ~~SOUTH~~ LONG YELLOW OAK LT

SUBDIVISION POINT BLOCK / SECTION 12 LOT 15 LOT AREA 3.921 AC SITE CLASS. PS DESIGN FLOW 480GPD L.T.A.R. .36 / KT 2

Septic Tank: ~~1000~~ 1500 Gallons; STB 338 Date 6-22-05

Pump Tank: 1000 Gallons; PT 283 Date 7-1-05

Pump Make: Myers Model ME 50 Serial No.

Nitrification Field: No Fields 1 Square Feet 1200 Linear Feet 400

No Lines 5 @ 80' Trench Width 36" Max Trench Bottom Depth 36" Gravel Depth N/A

☑ New System ☐ Repair System Type: I, II, (III), IV, V, VI

System Description: PUMP 25% REDUCTION

Repair System Description: LP PANEL

Maintenance Agreement Required: ☐ Yes ☐ No

☑ ~~House~~/Mod. Home No. Bedrooms 4

☐ Mobile Home No. Bathrooms 4

☐ Business No. Employees

☐ Other

☐ Slab ☑ Crawl Space ☑ Basement w/plumbing ☐ Basement wo/plumbing

Water Supply: ☐ Individual ☐ Public ☑ ~~Community~~


Comments/Conditions: Reviewed Building plans & Site plan 12/22/04 essentially in Compliance with original permit.

Rec'd 1/17/06

Comments/Conditions: PARTIAL

Note: House Slightly larger than original foot print however should still have enough room for Drainfield.


INITIAL SITE SKETCH 1" = 50'

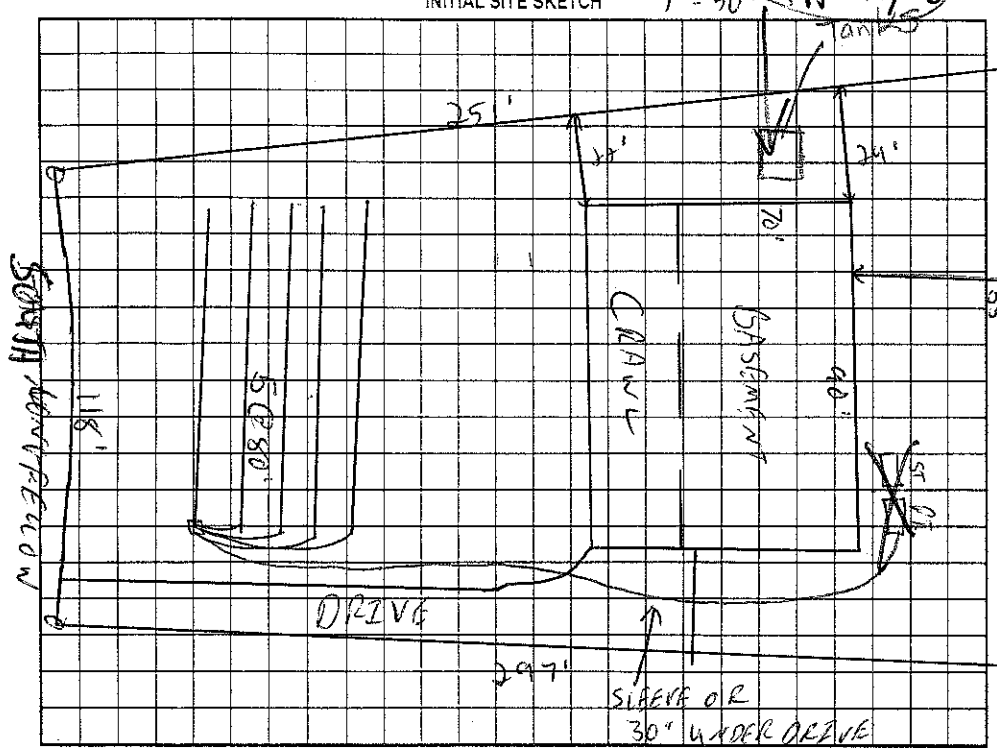

AS BUILT SKETCH

8/5/05 Checked lines & tanks 8/5/05

EZ Flow

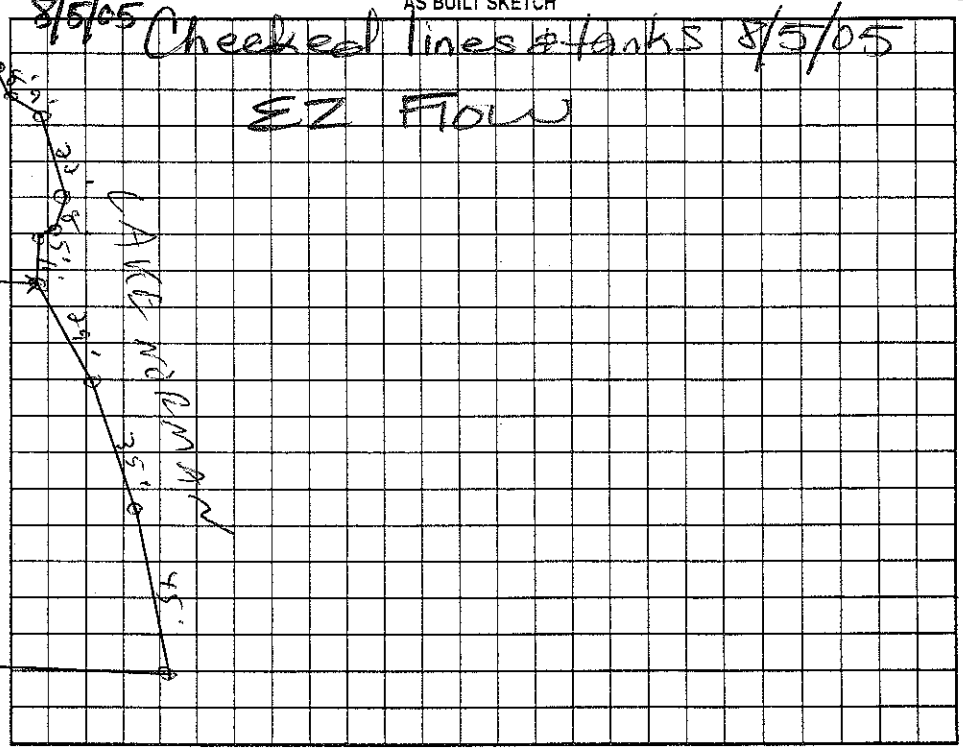

Permit can be suspended or revoked if any false information is supplied toward securing the permit/any unauthorized changes are made to the site/any unauthorized changes are made in the installation of the system. Improvement Permit with plat valid without ~~expiration~~. Improvement Permit with site plan valid for sixty months. Authorization to Construct is valid for a period equal to that of Improvement Permit – not to exceed sixty months.

Signed: [illegible] date 9-23-03 Installed by: R & H RS

Improvement Permit by: [illegible] RS date 9/8/03 Operation Permit by: [illegible] date 1/17/06

Authorization to Construct by: [illegible] RS date 12/22/04 Existing System Inspection by: date

HEALTH DEPT. COPY: WHITE OWNER COPY (FINAL): YELLOW OWNER COPY (INITIAL): PINK