IREDELL COUNTY HEALTH DEPARTMENT

STATESVILLE 704-878-5305 MOORESVILLE 704-664-5281

IMPROVEMENT PERMIT / AUTHORIZATION TO CONSTRUCT / OPERATION PERMIT / EXISTING SYSTEM INSPECTION

PERMIT# 075889 PIN# 4624 87 9569 DATE 9/14/98

OWNER OR CONTRACTOR Ode N Jensen PHONE: Business _____ Home 895-7294

ADDRESS 20511-E Sterling Bay Ln W Cornelius, NC. 28031

LOCATION Yacht Rd, 1100 TL Yacht Rd. lot on R across from Stingray Ct.

SUBDIVISION Williams Former Meck Nook BLOCK / SECTION _____ LOT 10 LOT AREA .70 SITE CLASS: P3 DESIGN FLOW 360 L.T.A.R. .3

Septic Tank: 1000 Gallons; STB 1012 Date 6/26/98
Pump Tank: 1000 Gallons; PT 17 Date 5/14/99
Pump Make: _____ Model ME 40HCII Serial No. _____
Nitrification Field: No Fields 1 Square Feet 900 Linear Feet 300
No Lines 6 Trench Width 36" Max Trench Bottom Depth 36" Gravel Depth SAND

[X] New System [ ] Repair System Type: I, II, [III], IV, V, VI
System Description: Pres. Manifold-Ch. Plastic Dome
Repair System Description: _____
Maintenance Agreement Required: [ ] Yes [X] No

[X] House/Mod. Home No. Bedrooms 3
[ ] Mobile Home No. Bathrooms 3
[ ] Business No. Employees _____
[ ] Other _____

[ ] Slab [X] Crawl Space [ ] Basement w/plumbing [ ] Basement wo/plumbing


Water Supply: [X] Individual [ ] Public [ ] Community

Comments:/Conditions: Filter installed


100' From well to Initial system.

Comments:/Conditions: Installed as drawn
Tanks, lines & Pressure Checked. 8/30/99 mx

INITIAL SITE SKETCH

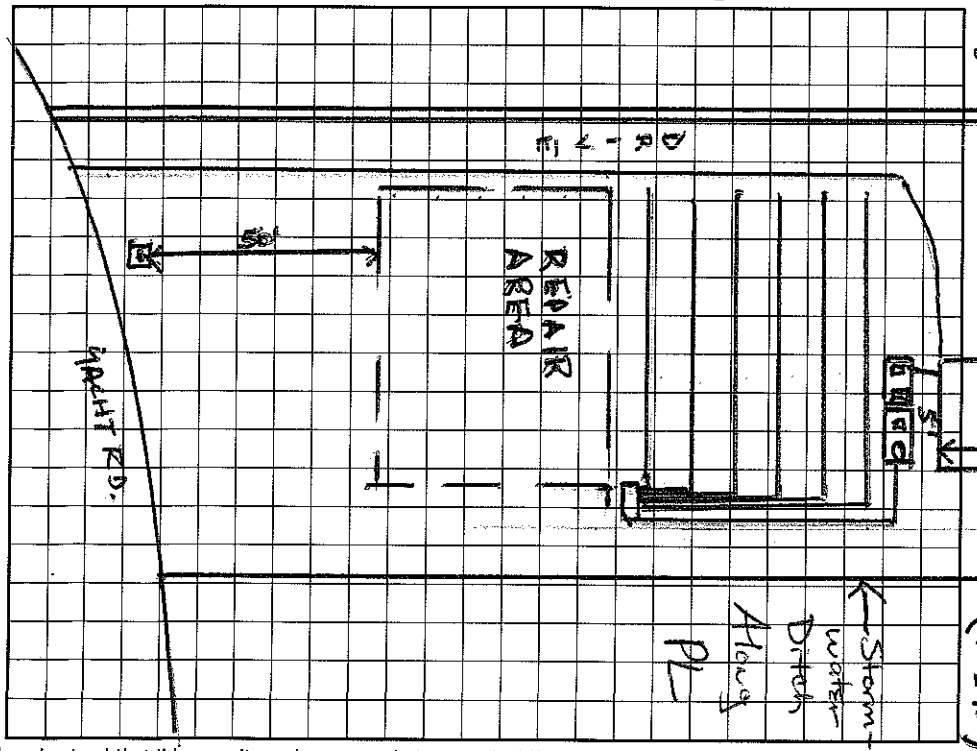

AS BUILT SKETCH

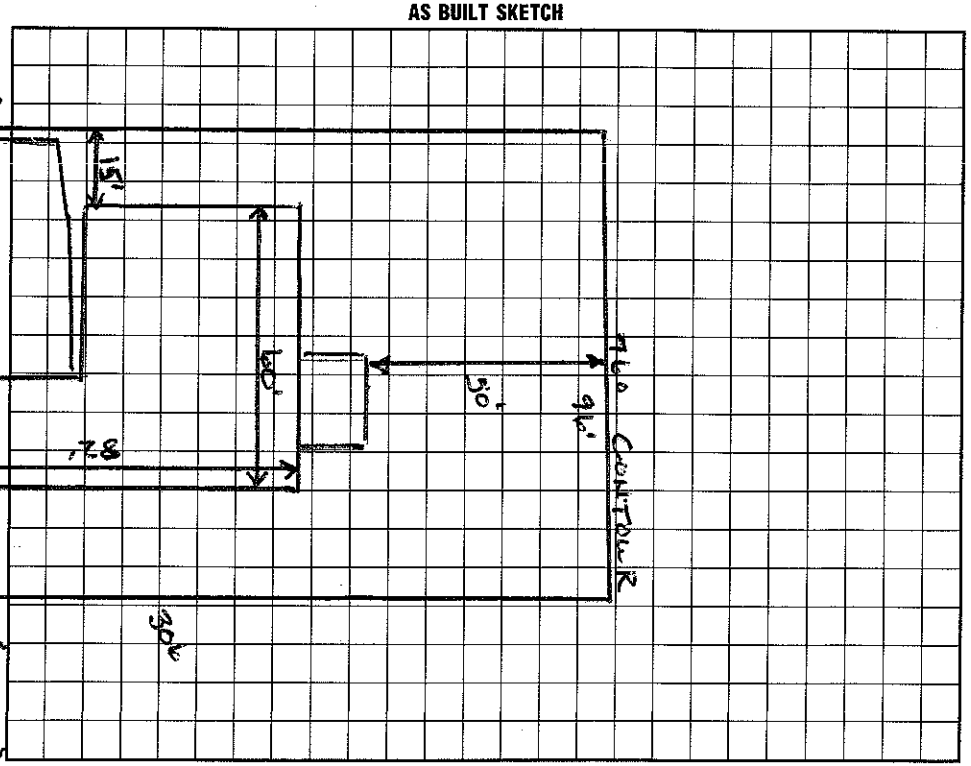

I understand that this permit can be suspended or revoked if any false information is supplied toward securing the permit/any unauthorized changes are made to the site/any unauthorized changes are made in the installation of the system. Improvement Permit with plat valid without expiration. Improvement Permit with site plan valid for sixty months. Authorization to Construct is valid for a period equal to that of Improvement Permit – not to exceed sixty months.

Signed: * _____ date 9/15/98 Installed by: Richard Abernathy

Improvement Permit by: Wesley Sparks RS. date 9/15/98 Operation Permit by: Wesley Sparks RS. date 8/31/99

Authorization to Construct by: Wesley Sparks RS. date 9/15/98 Existing System Inspection by: _____ date _____

HEALTH DEPT. COPY: WHITE INSPECTION COPY (FINAL): GREEN OWNER COPY (FINAL): YELLOW INSPECTION COPY (INITIAL): PINK OWNER COPY (INITIAL): GOLD