IREDELL COUNTY HEALTH DEPARTMENT

Statesville Office (704) 878-5305 Mooresville Office (704) 660-3625 PERMIT # 2096116

IMPROVEMENT PERMIT / AUTHORIZATION TO CONSTRUCT / OPERATION PERMIT / EXISTING SYSTEM

PIN # 4624-87-9569

APPLICANT: BROOKS HENDERSON APPLICANT ADDRESS: Po Box 1409 CORNELIUS

SITE ADDRESS: 350 YACHT RD. PHONE: 704-201-1429 ALT. PHONE:

SITE DIRECTIONS: SAME

SUBDIVISION: WILLIAMS SECTION: LOT # 10 LOT AREA: .7 AC DESIGN FLOW: 360 L.T.A.R.: .3

Septic Tank Ex.1000 (gal) STB Date

Pump Tank Ex.1000 (gal) PT Date

Pump Make Model Serial #

Nitrification Fields EXISTING # Lines Linear Ft:

Trench Width Max. Trench Bottom Depth Gravel Depth —

☐ New System ☐ Repair ☐ Expansion System Type: I II III IV V VI

System Description: PM - PPBPS

Repair System Description: SAME

Maintenance Agreement Required: ☐ YES ☒ NO

☐ GRAVITY ☒ PRESSURE

☐ Residence No. Bedrooms 3

☐ Business No. Persons

☒ Other No. Employees

☐ Slab ☒ Crawl Space

☐ Basement w/plumbing ☐ Basement w/o plumbing

Water Supply: ☒ Private ☐ Public ☐ Community

Comments / Conditions:

SMALL ADDITION MAKING BEDROOM BIGGER

INITIAL SITE SKETCH

SEE PLAN FROM ROLLANS SOIL & ENVIRONMENTAL SERVICES

AS BUILT SKETCH

Permit can be suspended or revoked if any false information is supplied toward securing the permit / any unauthorized changes are made to the site / any unauthorized changes are made in the installation of the system. **CONTACT A LOCATOR SERVICE PRIOR TO ANY EXCAVATION**

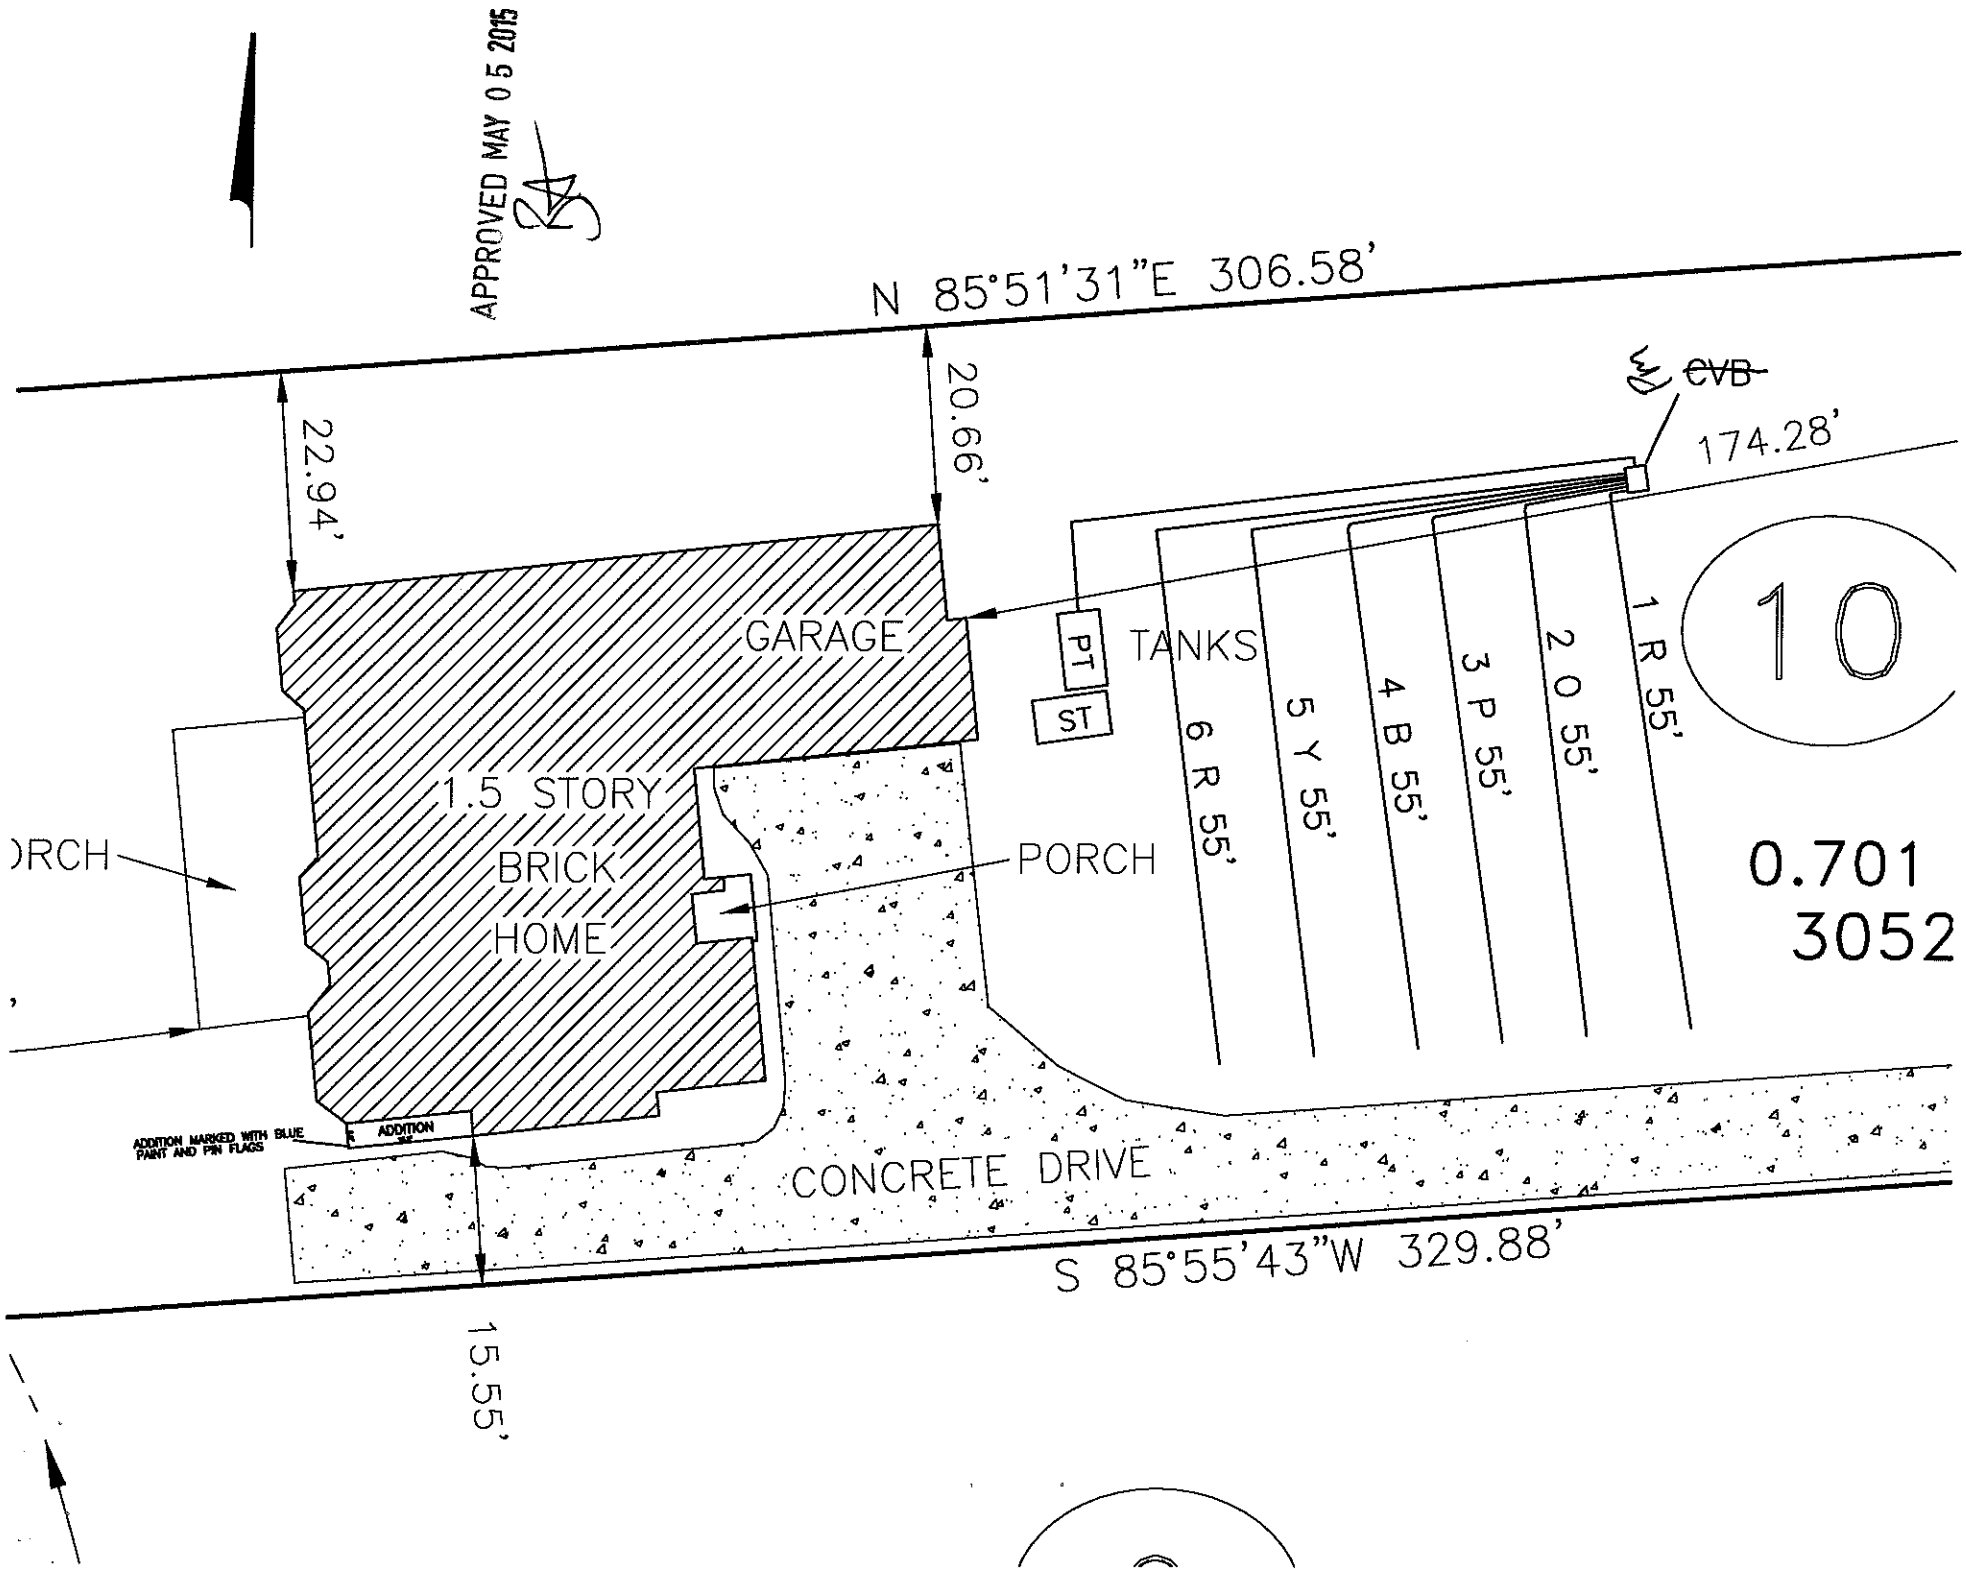
☐ **IMPROVEMENT PERMIT** *with plat valid without expiration.* ☐ **IMPROVEMENT PERMIT** *with site plan valid for 60 mos.* ☐ **AUTHORIZATION TO CONSTRUCT** *valid for period equal to IMPROVEMENT PERMIT--not to exceed 60 mo.*

Owner / Applicant Signature: Date: 5/8/15 Installed by:

IMPROVEMENT PERMIT by: Date: OPERATION PERMIT by: Date:

AUTHORIZATION TO CONSTRUCT by: Date: Existing System Inspected by: Date: APPROVED MAY 05 2015

Health Dept. Copy - WHITE Applicant (Final Approval) - YELLOW Applicant (Conditional Approval) - PINK


APPROVED MAY 05 2015
N 85°51'31"E 306.58'
22.94'
20.66'
CVB
174.28'
GARAGE
PT
ST
TANKS
6 R 55'
5 Y 55'
4 B 55'
3 P 55'
2 O 55'
1 R 55'
10
1.5 STORY
BRICK
HOME
PORCH
0.701
3052
ADDITION MARKED WITH BLUE PAINT AND PIN FLAGS
ADDITION
CONCRETE DRIVE
S 85°55'43"W 329.88'
15.55'