IREDELL COUNTY HEALTH DEPARTMENT

STATESVILLE 704-878-5305 MOORESVILLE 704-664-5281

IMPROVEMENT PERMIT / AUTHORIZATION TO CONSTRUCT / OPERATION PERMIT / EXISTING SYSTEM INSPECTION

PERMIT# 088248 PIN# 4624-87-9590 DATE 4/3/00

OWNER OR CONTRACTOR Paul H. Lindemann PHONE: Business 948-1995 Home

ADDRESS 7914 Bethpage Rd. Huntersville, NC 28078 - 354 Yacht Rd.

LOCATION 1100, Yacht Rd., - Lake Norman Regency

SUBDIVISION BLOCK / SECTION LOT LOT AREA .67 AC SITE CLASS PS DESIGN FLOW 480 L.T.A.R. .3

Septic Tank: 1500 Gallons; STB 1091 Date 12/17/99
Pump Tank: 1000 Gallons; PT 19 Date 1000
Pump Make: HYDROMATIC Model SHEF 50A1 Serial No 8-99
Nitrification Field: No Fields 1 Square Feet 900 ± Linear Feet 300
No Lines 6@50' Trench Width 36" Max Trench Bottom Depth 36" Gravel Depth SAND

[X] New System [ ] Repair System Type: I, II, III, IV, V, VI
System Description: Presto 12" PP85
Repair System Description: Same
Maintenance Agreement Required: [X] Yes [ ] No

[X] House/Mod. Home No. Bedrooms 4
[ ] Mobile Home No. Bathrooms 5
[ ] Business No. Employees
[ ] Other


Water Supply: [X] Individual [ ] Public [ ] Community

[ ] Slab [X] Crawl Space [ ] Basement w/plumbing [ ] Basement wo/plumbing


Comments/Conditions: Maintenance Agreement Required

Comments/Conditions:

INITIAL SITE SKETCH

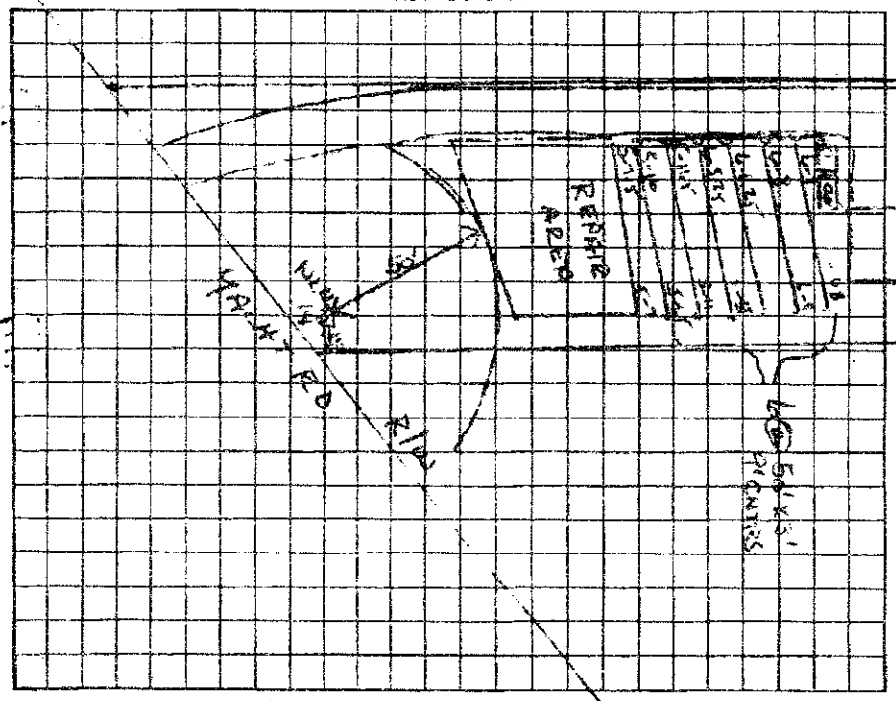

AS BUILT SKETCH

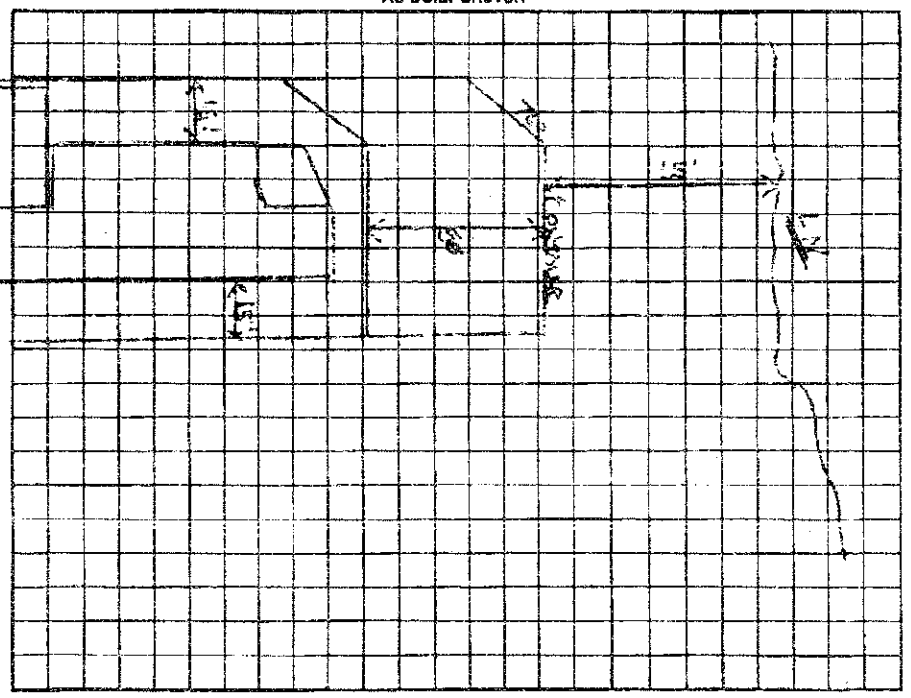

Permit can be suspended or revoked if any false information is supplied toward securing the permit/any unauthorized changes are made to the site/any unauthorized changes are made in the installation of the system. Improvement Permit with plat valid without expiration. Improvement Permit with site plan valid for sixty months. Authorization to Construct is valid for a period equal to that of Improvement Permit – not to exceed sixty months.

Signed: x [signature] date 4/3/00 Installed by: Statesville Septic Tank

Improvement Permit by: Wesley Sparks RS date 4/3/00 Operation Permit by: Wesley Sparks RS date 4/9/01

Authorization to Construct by: Wesley Sparks RS date 4/3/00 Existing System Inspection by: date

HEALTH DEPT. COPY: WHITE OWNER COPY (FINAL): YELLOW OWNER COPY (INITIAL): PINK

Aug-01-03 04:50P P.09