# IREDELL COUNTY HEALTH DEPARTMENT

Statesville Office (704) 878-5305 Mooresville Office (704) 660-3625 PERMIT # 206970

ALP

## IMPROVEMENT PERMIT / AUTHORIZATION TO CONSTRUCT / OPERATION PERMIT / EXISTING SYSTEM

PIN # 4624879739

APPLICANT: Augusta Homes (for Ron Pfeffer) APPLICANT ADDRESS: 10602-B Baily Rd Cornelius NC 28031

SITE ADDRESS: 348 Yacht Rd PHONE: (704) 201-4460 ALT. PHONE: (704) 892 7795 Ron Pfeffer

SITE DIRECTIONS: Go Brawley Sch Rd TL on Yacht Rd 1 mi on right near Pelican Court

SUBDIVISION: Mesh Neck SECTION: LOT # LOT AREA: .72 ac DESIGN FLOW: 480 L.T.A.R.: .3

Septic Tank existing (gal) STB Date

Pump Tank existing (gal) PT Date

Pump Make Model Serial #

# Nitrification Fields 1 # Lines 5 Linear Ft: 400

Trench Width 36" Max. Trench Bottom Depth 36" Gravel Depth N/A

☐ New System ☐ Repair ☐ Expansion System Type: I II III IV V VI

System Description: pressure manifold 25% reduction

Repair System Description: same

Maintenance Agreement Required: ☐ YES ☑ NO

☐ GRAVITY ☑ PRESSURE PM

☑ Residence No. Bedrooms 3

☐ Business No. Persons

☐ Other No. Employees


☐ Slab ☐ Crawl Space

☐ Basement w/plumbing ☐ Basement w/o plumbing


Water Supply: ☑ Private ☐ Public ☐ Community

Comments / Conditions: AUTHORIZATION FOR ADDITION OF 1-CAR GARAGE SPACE (11x22) and PANTRY (8x11) ONLY. NO ADDITION OF BEDROOMS ABOVE EXISTING 3BR on 360 gal/day or change of use from single family dwelling. Dimensions Proposed by applicant hot field verified. Existing 12x60' bed installed in 2002 was discovered in 2008 when repair was done. 12x60' bed may be removed during addition construction

INITIAL SITE SKETCH

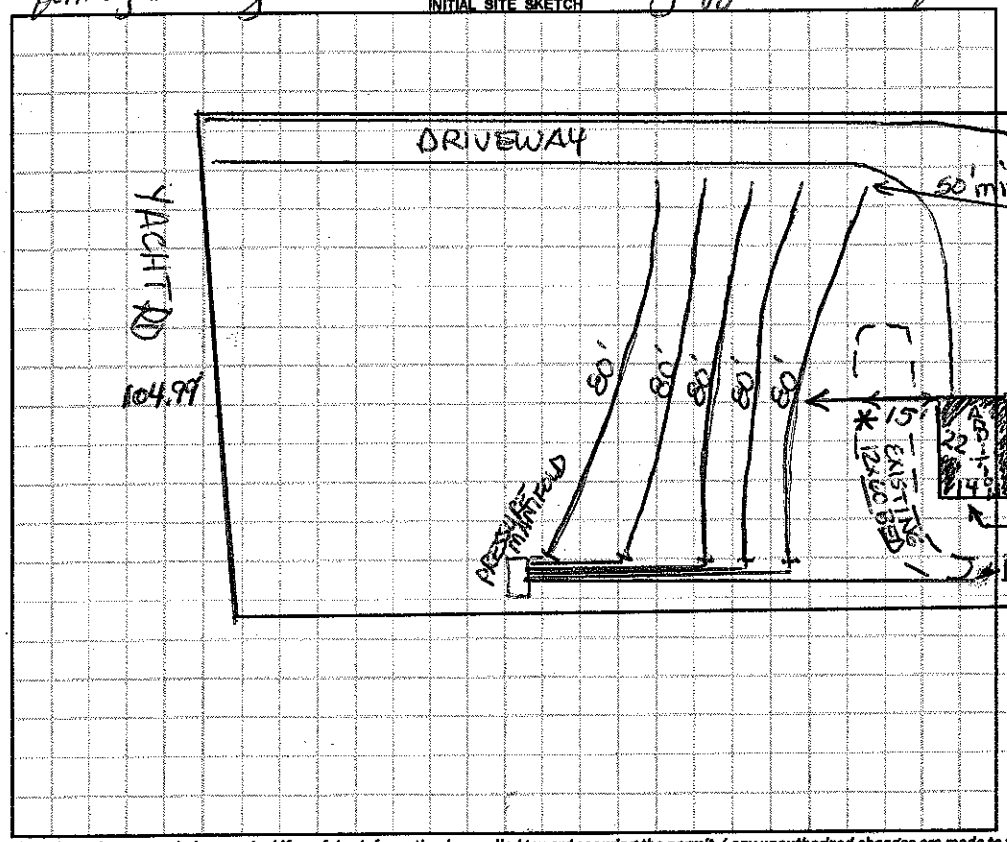


AS BUILT SKETCH

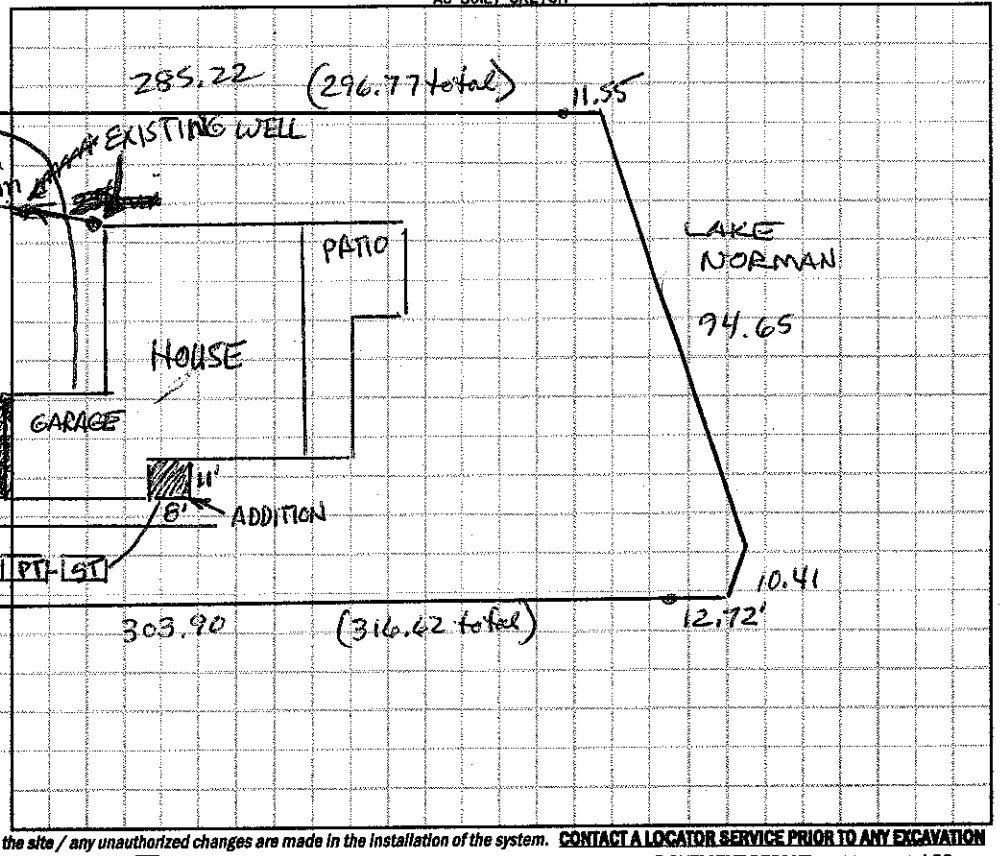


Permit can be suspended or revoked if any false information is supplied toward securing the permit / any unauthorized changes are made to the site / any unauthorized changes are made in the installation of the system. CONTACT A LOCATOR SERVICE PRIOR TO ANY EXCAVATION

☐ IMPROVEMENT PERMIT valid for site plan valid for 60 mos. ☐ AUTHORIZATION TO CONSTRUCT valid for period equal to IMPROVEMENT PERMIT--not to exceed 60 mo.

Location of the proposed garage and pantry addition does not appear to impact the existing on-site septic system or well. **NOTE:

Owner / App

IMPROVEME Richard Farris REHS Date: 11/20/14

AUTHORIZAT ICHD-Environmental Health Division

Installed by:

OPERATION PERMIT by: Date:

Existing System Inspected by: Date:

Health Dept. Copy - WHITE Applicant (Final Approval) - YELLOW Applicant (Conditional Approval) - PINK