IREDELL COUNTY HEALTH DEPARTMENT

STATESVILLE 704-878-5305 MOORESVILLE 704-664-5281

IMPROVEMENT PERMIT / AUTHORIZATION TO CONSTRUCT / OPERATION PERMIT / EXISTING SYSTEM INSPECTION

PERMIT# 086384 PIN# 4624 88 3773

OWNER OR CONTRACTOR Peter Gaspenny PHONE: Business 948-1995 Home DATE 12/20/99

ADDRESS 18021-H Kings Point Dr. Cornelius, NC. 28031

LOCATION 1100 TL Yacht Rd. TR Yacht Harbor TL Keel Ct. to 2ND lot on (R)

SUBDIVISION Yacht Com HARBOR LOT 28 LOT AREA .70 SITE CLASS PS DESIGN FLOW 480 L.T.A.R. .3

Septic Tank: 1000 Gallons; STB 325 Date 12/17/99

Pump Tank: 1000 Gallons; PT 300 Date 1/4/00

Pump Make: ARMATUR Model SHEF 5 A1 Serial No. 3/99

Nitrification Field: No Fields 1 Square Feet 840 Linear Feet 298

No Lines 8(4+4) Trench Width 36" Max Trench Bottom Depth 36" Gravel Depth SAND

[X] New System [ ] Repair System Type: I, II, III, (IV), V, VI

System Description: Pres. PPB 16"

Repair System Description: Same

Maintenance Agreement Required: [X] Yes [ ] No

[X] House/Mod. Home No. Bedrooms 4

[ ] Mobile Home No. Bathrooms 4

[ ] Business No. Employees

[ ] Other

[ ] Slab [X] Crawl Space [ ] Basement w/plumbing [ ] Basement wo/plumbing

Water Supply: [X] Individual [ ] Public [ ] Community


Comments:/Conditions: 40-45 GPM PUMP REQUIRED

(2) 1 - 3/16" hole per panel block, TURNED UP


2 GATE VALVES w 4 LINES PER VALVE

Comments:/Conditions:

INITIAL SITE SKETCH 1"=50'

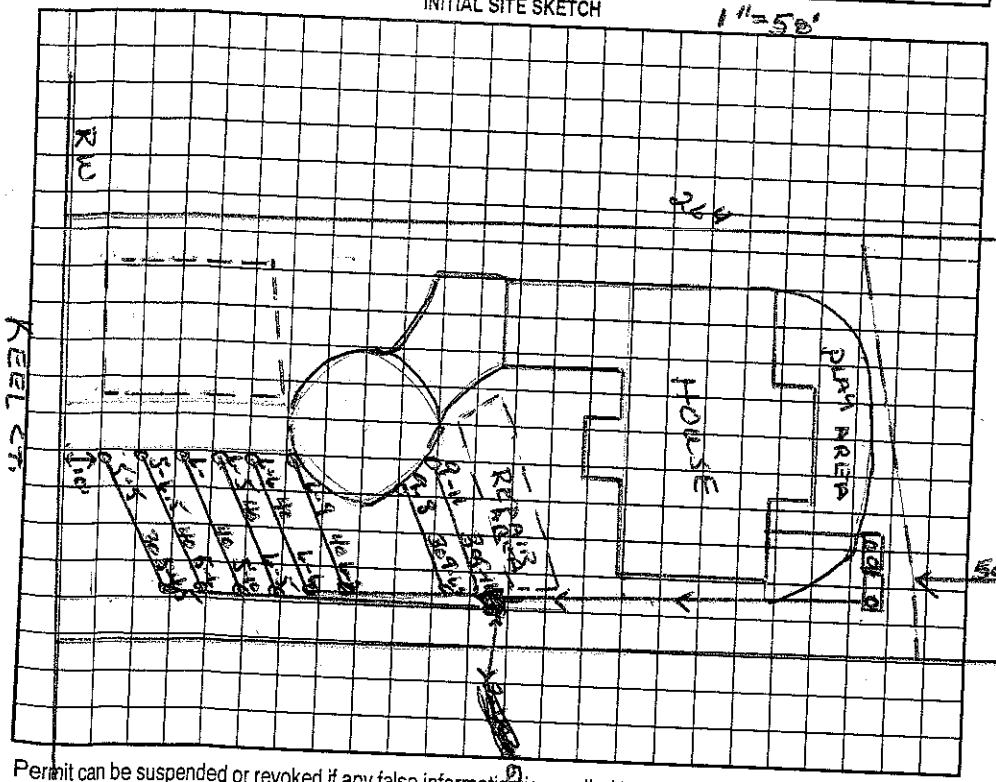

AS BUILT SKETCH

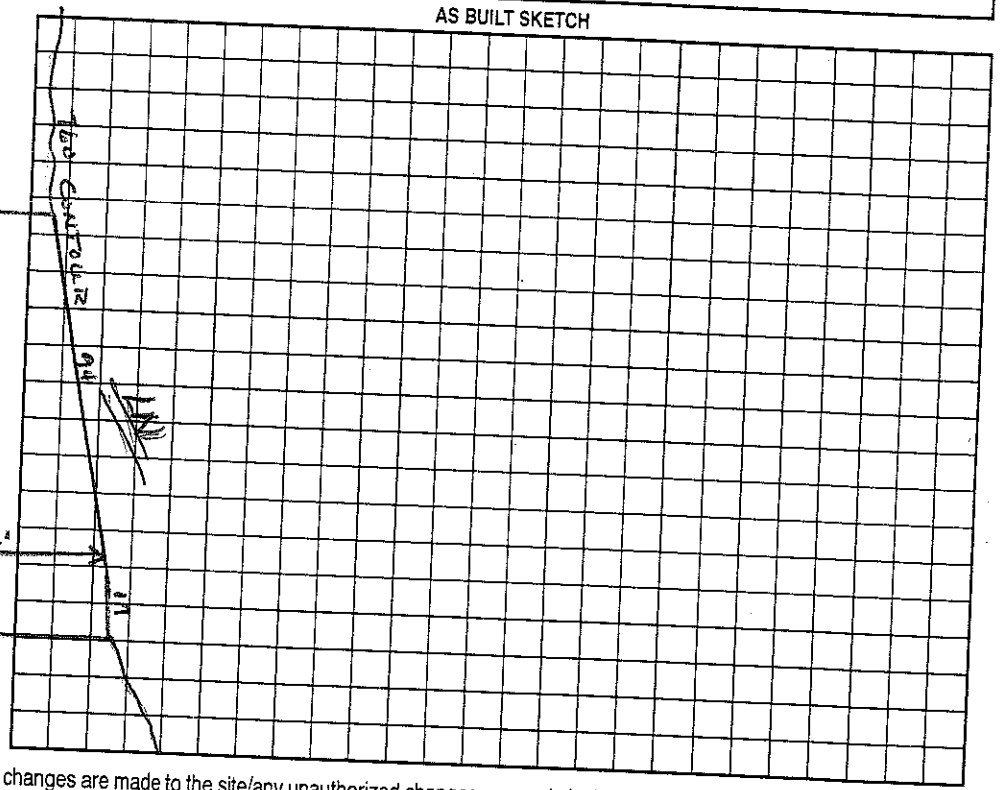

Permit can be suspended or revoked if any false information is supplied toward securing the permit/any unauthorized changes are made to the site/any unauthorized changes are made in the installation of the system. Improvement Permit with plat valid without expiration. Improvement Permit with site plan valid for sixty months. Authorization to Construct is valid for a period equal to that of Improvement Permit – not to exceed sixty months.

Signed: * [signature] date 1/3/2000

Improvement Permit by: Wesley Sparks R.S. date 12/20/99

Authorization to Construct by: Wesley Sparks R.S. date 12/20/99

Installed by: C+W Grading + Septic

Operation Permit by: Wesley Sparks R.S. date 8/4/00

Existing System Inspection by: date

HEALTH DEPT. COPY: WHITE OWNER COPY (FINAL): YELLOW OWNER COPY (INITIAL): PINK