IREDELL COUNTY HEALTH DEPARTMENT

STATESVILLE 704-878-5305 325.00 Paid MOORESVILLE 704-664-5281 Statesville Backhoe

IMPROVEMENT PERMIT / AUTHORIZATION TO CONSTRUCT / OPERATION PERMIT / EXISTING SYSTEM INSPECTION

DATE 5/29/01

PERMIT# 100473 PIN# 4624 88 3844

OWNER OR CONTRACTOR Henry Builders PHONE: Business 704-948-1995 Home

ADDRESS 7914 Bilead Rd. Huntersville, NC 28078

LOCATION 1100 TL Yacht Rd. TR Yacht Harbor TL Keel Ct. 2nd lot on (R)

SUBDIVISION YACHT HARBOR BLOCK / SECTION LOT 27 LOT AREA .74 Ac SITE CLASS PS DESIGN FLOW 600 L.T.A.R. .3

Septic Tank: 1500 ~~1250~~ Gallons; STB 338 Date 2/16/02

Pump Tank: 1500 ~~1250~~ Gallons; ST B 339 Date 12/11/01

Pump Make: Hydromatic Model SIHEF50A Serial No. 234685

Nitrification Field: No Fields 1 Square Feet 1050 Linear Feet 350

No Lines 5@70' Trench Width 3' Max Trench Bottom Depth 32" Gravel Depth No

[X] New System [ ] Repair System Type: I, II, III, IV, V, VI

System Description: LP - 16" PPBPS

Repair System Description: SAME

Maintenance Agreement Required: [X] Yes [ ] No

[X] House/Mod. Home No. Bedrooms 5

[ ] Mobile Home No. Bathrooms 5

[ ] Business No. Employees

[ ] Other

[ ] Slab [X] Crawl Space [ ] Basement w/plumbing [ ] Basement wo/plumbing


Water Supply: [X] Individual [ ] Public [ ] Community

DENR VARIANCE *


Comments:/Conditions: Very tight for well location. DENR Variance has been granted and is attached to Auth. Const.

Comments:/Conditions:

INITIAL SITE SKETCH (1"=60')

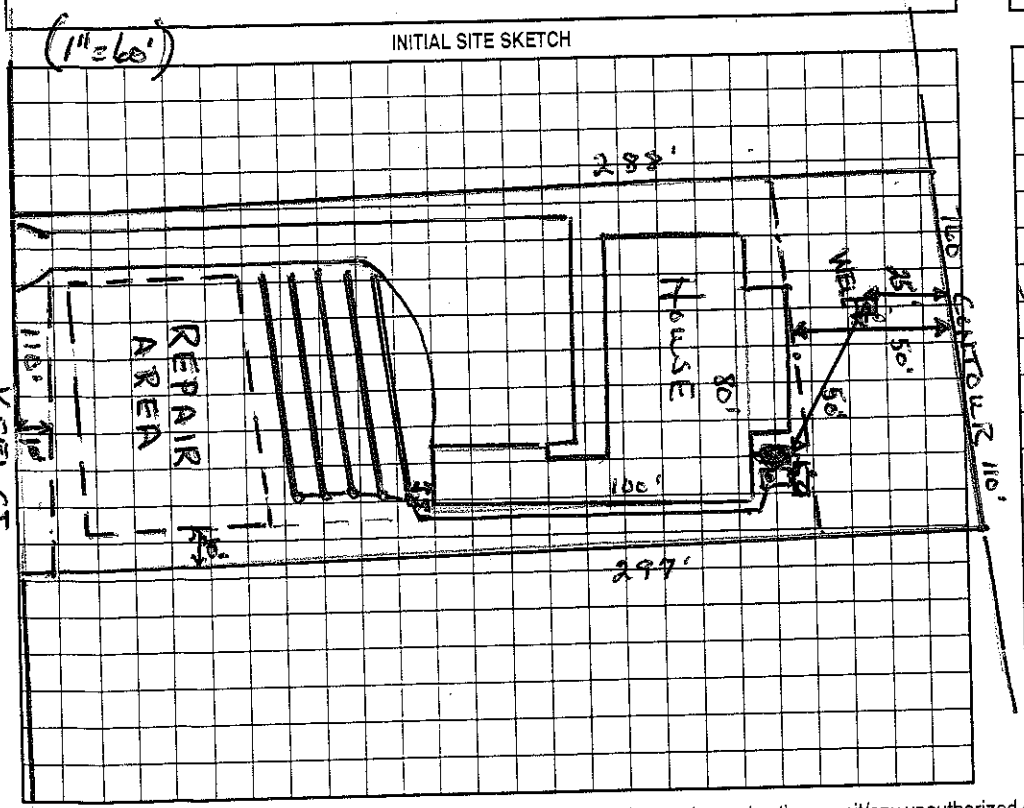

AS BUILT SKETCH

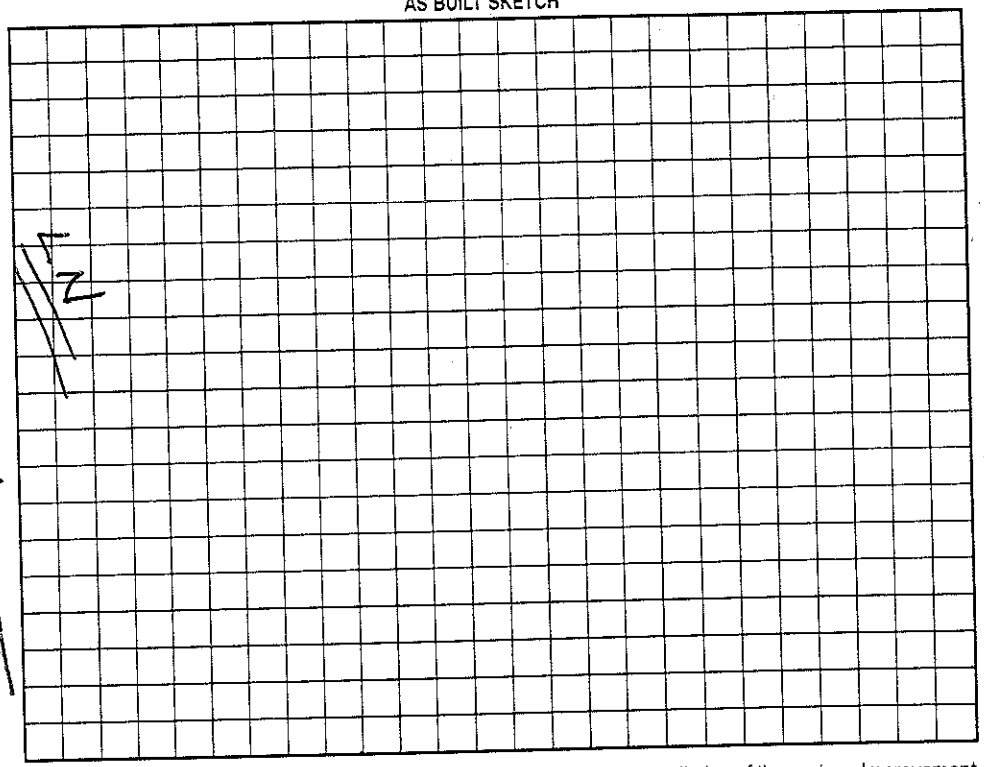

Permit can be suspended or revoked if any false information is supplied toward securing the permit/any unauthorized changes are made to the site/any unauthorized changes are made in the installation of the system. Improvement Permit with plat valid without expiration. Improvement Permit with site plan valid for sixty months. Authorization to Construct is valid for a period equal to that of Improvement Permit – not to exceed sixty months.

Signed: * [signature] date 6/5/01

Improvement Permit by: Wesley Sparks RS. date 5/29/01

Wesley Sparks RS. date 5/29/01

Installed by: Statesville Backhoe

Operation Permit by: Wesley Sparks RS. date 6/19/02

Existing System Inspection by: date

HEALTH DEPT. COPY: WHITE OWNER COPY (FINAL): YELLOW OWNER COPY (INITIAL): PINK