IREDELL COUNTY HEALTH DEPARTMENT

462488 4614

STATESVILLE 704-878-5305 MOORESVILLE 704-664-5281

IMPROVEMENT PERMIT / CERTIFICATE OF COMPLETION / OPERATION PERMIT / EXISTING SYSTEM INSPECTION

PROPERTY DESCRIPTION NO. 18481 DATE May 13, '94 TAX MAP NO. 2C 1B29

OWNER OR CONTRACTOR James P. DeMare PHONE: Business Home 343-3159 Watershed: ☑ Yes ☐ No L.N.

ADDRESS 7600 Red Oak Lane, Charlotte

LOCATION 1100 Tr 1101 Tr Yacht Harbour Tr Keel Lane on Right

SUBDIVISION Yacht Harbour BLOCK / SECTION LOT 29 LOT AREA 25-30,000 ft² SITE CLASS. PS pr. 1956 DESIGN FLOW 360 gpd L.T.A.R. .3

Septic Tank: 1000 Gallons; STB 765 71 Date 12-22-93

Pump Tank: Gallons; PT Date

Pump Make: Model Serial No.

Nitrification Field: No Fields 1 Square Feet 1200 Linear Feet 400

No Lines 4 Trench Width 36" Max Trench Bottom Depth 36" Gravel Depth 12"

☑ New System ☐ Repair System Type: I, II, III, IV, V, VI

System Description: gravity conventional

Repair System Description: Gravity or LPPPBPS

Maintenance Agreement Required: ☐ Yes ☑ No

☑ House/Mod. Home No. Bedrooms 3
☐ Mobile Home No. Bathrooms 2
☐ Business No. Employees
☐ Other


☐ Slab ☑ Crawl Space ☐ Basement w/plumbing ☐ Basement wo/plumbing

Water Supply: ☑ Individual ☐ Community ☐ Public


Comments:

Comments: Upper Line tapped "Rattlesnake" Approx 10-20' to 1st total footage Well not installed as of 6/22/94

INITIAL SITE SKETCH

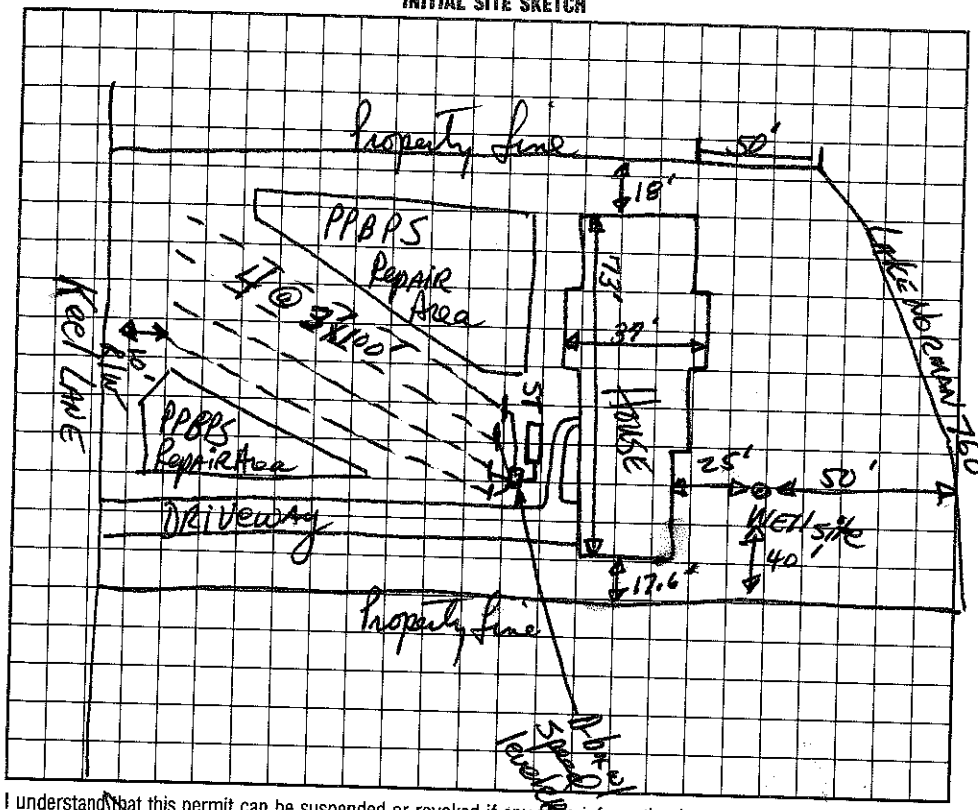

AS BUILT SKETCH

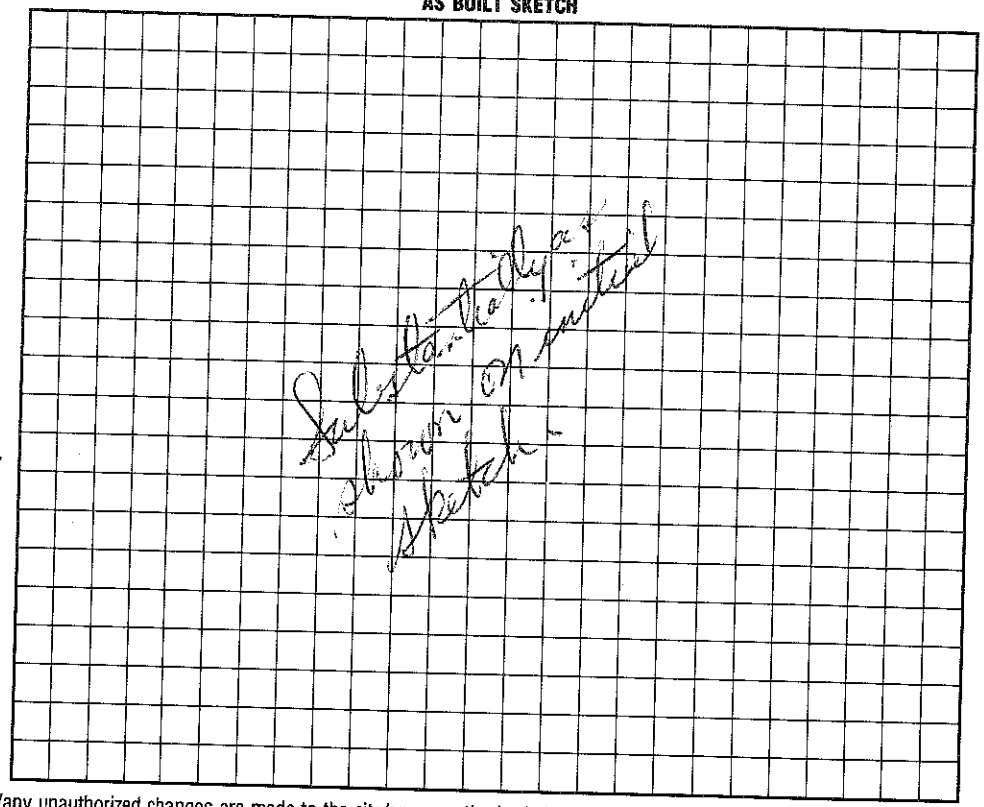

I understand that this permit can be suspended or revoked if any false information is supplied toward securing the permit/any unauthorized changes are made to the site/any unauthorized changes are made in the installation of the system. Improvement Permit is valid for 60 months from date of issuance.

Signed:

Improvement Permit by: Dave Patterson, RS date 5/13/94

Existing System Inspection by: date

Installed by: WT Hanover, Wareham, NC

Certificate of Completion by: Dave Patterson, RS date 6/22/94

Operation Permit by: date

HEALTH DEPT. COPY: WHITE INSPECTION COPY (FINAL): GREEN OWNER COPY (FINAL): YELLOW INSPECTION COPY (INITIAL): PINK OWNER COPY (INITIAL): GOLD