IREDELL COUNTY HEALTH DEPARTMENT

Statesville Office (704) 878-5305 Mooresville Office (704) 660-3625 PERMIT # 205498

IMPROVEMENT PERMIT / AUTHORIZATION TO CONSTRUCT / OPERATION PERMIT / EXISTING SYSTEM

PIN # 4629888089

APPLICANT: Andrew Hoyt APPLICANT ADDRESS: 328 Yacht Rd Mooresville NC

SITE ADDRESS: 328 Yacht Rd Mooresville NC PHONE: 704-517-7380 ALT. PHONE: N/A


SITE DIRECTIONS: Brawley School Rd T/L Yacht Rd

SUBDIVISION: N/A SECTION: N/A LOT # N/A LOT AREA: 0.61 ac DESIGN FLOW: EX L.T.A.R.: EX


Septic Tank	EX	(gal)	STB		Date		☐ New System	☐ Repair	☐ Expansion	System Type: I II III IV V VI	☒ Residence	No. Bedrooms	EX	Water Supply
Pump Tank	EX	(gal)	PT		Date		System Description: Existing				☐ Business	No. Persons	EX	☒ Private
Pump Make	EX	Model			Serial #		Repair System Description:				☐ Other	No. Employees		☐ Public
# Nitrification Fields	EX	# Lines	EX	Linear Ft:	EX		Maintenance Agreement Required:	☐ YES	☑ NO		☐ Slab	☒ Crawl Space		☐ Community
Trench Width	EX	Max. Trench Bottom Depth	EX	Gravel Depth	EX			☐ GRAVITY	☑ PRESSURE		☐ Basement w/plumbing	☐ Basement w/o plumbing		

Comments / Conditions: All building foundations must be ≥5' from any part of STS and ≥ 25' from any well.

INITIAL SITE SKETCH

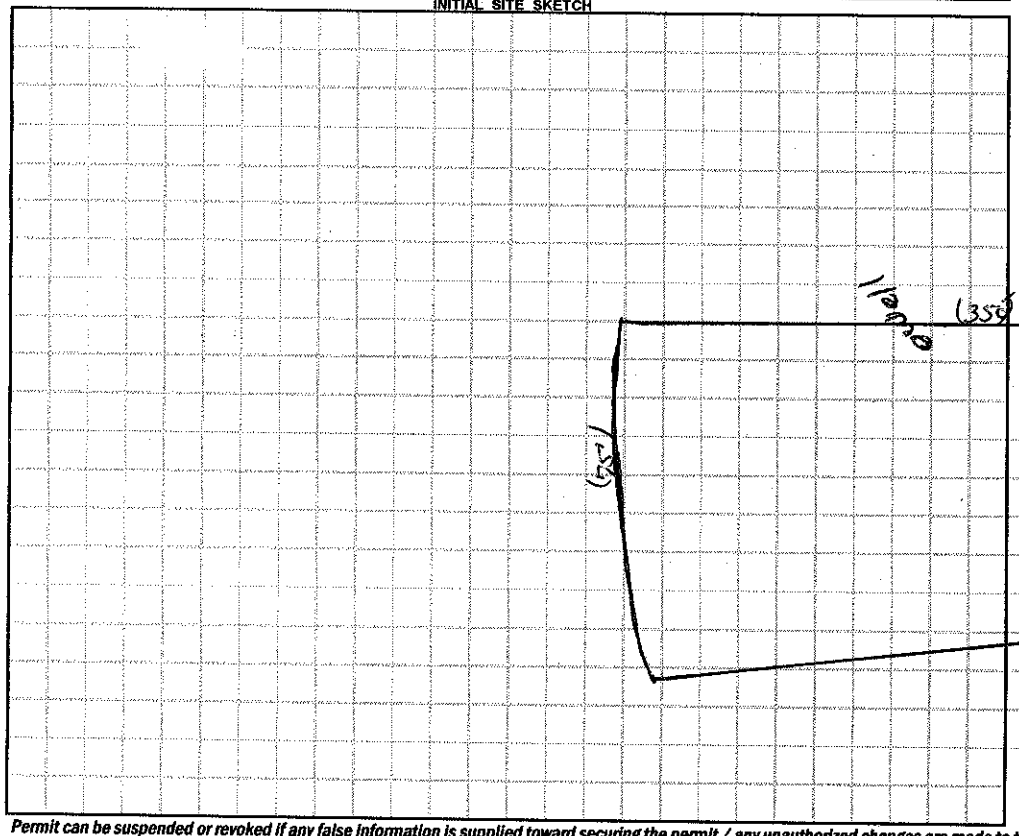

AS BUILT SKETCH

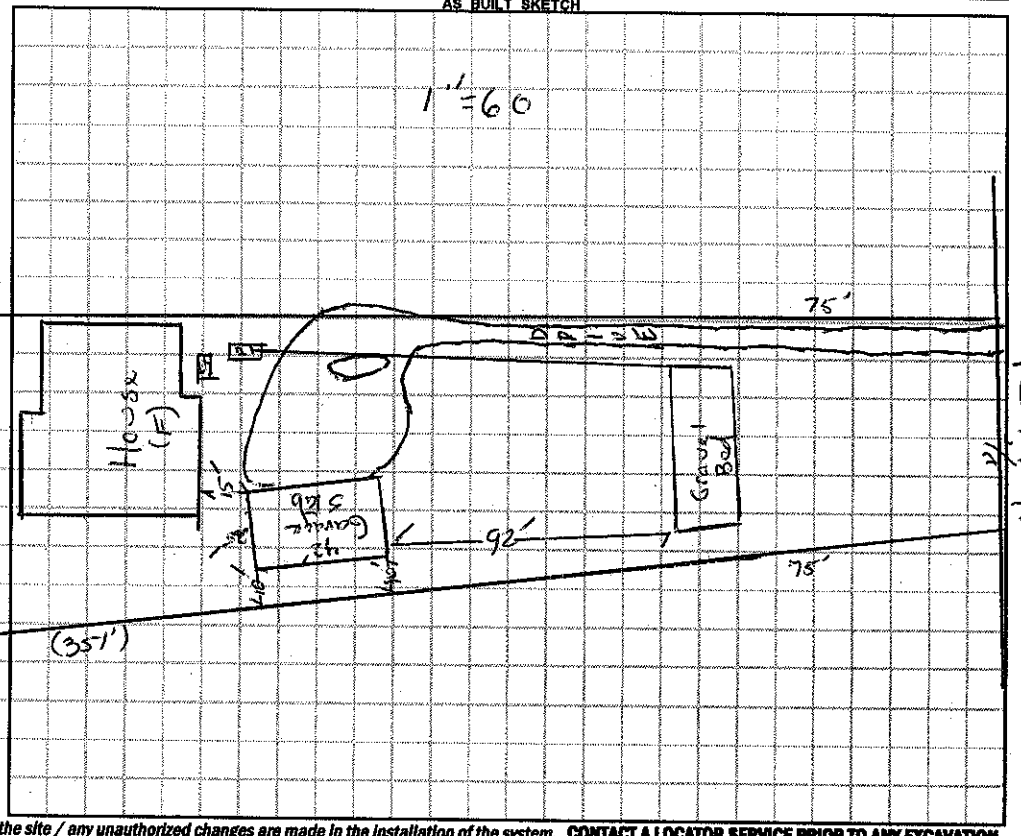

Permit can be suspended or revoked if any false information is supplied toward securing the permit / any unauthorized changes are made to the site / any unauthorized changes are made in the installation of the system. **CONTACT A LOCATOR SERVICE PRIOR TO ANY EXCAVATION**

☐ **IMPROVEMENT PERMIT** *with plat valid without expiration.* ☐ **IMPROVEMENT PERMIT** *with site plan valid for 60 mos.* ☐ **AUTHORIZATION TO CONSTRUCT** *valid for period equal to IMPROVEMENT PERMIT--not to exceed 60 mo.*

Owner / Applicant Signature: Andrew Hoyt Date: Installed by:

IMPROVEMENT PERMIT by: Date: OPERATION PERMIT by: Date:

AUTHORIZATION TO CONSTRUCT by: Date: Existing System Inspected by: Date: 09/13/14

Health Dept. Copy - WHITE Applicant (Final Approval) - YELLOW Applicant (Conditional Approval) - PINK