# IREDELL COUNTY HEALTH DEPARTMENT

Authorization to Construct — James Hudler 876-2427

STATESVILLE 704-878-5305 MOORESVILLE 704-664-5281

## IMPROVEMENT PERMIT / ~~CERTIFICATE OF COMPLETION~~ / OPERATION PERMIT / EXISTING SYSTEM INSPECTION

PROPERTY DESCRIPTION NO. 20054 DATE 4/12/96 TAX MAP NO. 2C 1B21 4624 89 2429 Watershed: ☑ Yes ☐ No

OWNER OR CONTRACTOR Jerald Clark PHONE: Business _____ Home 541-7070

ADDRESS 975 Warwick Circle, Charlotte

LOCATION Brawley School Rd - TL Yacht Rd - TR Yacht Harbor - TR Knoll Ct - At end on left

SUBDIVISION Yacht Harbor BLOCK / SECTION B LOT 21 LOT AREA .68 ac SITE CLASS. RS DESIGN FLOW 360 L.T.A.R. 1.3 gpd/ft²

Septic Tank: 1000 Gallons; STB 794 Date 1-13-97

Pump Tank: 1000 Gallons; PT 27-1000 Date 2-5-97

Pump Make: Liberty Model LE 71 A2 Serial No. 7504

Nitrification Field: No Fields 1 Square Feet 1200 Linear Feet 385

No Lines 6 Trench Width 36" Max Trench Bottom Depth 36" Gravel Depth 0-9

☑ New System ☐ Repair System Type: I, II, III, IV, V, VI

System Description: Pump Conventional

Repair System Description: Pump Panel

Maintenance Agreement Required: ☐ Yes ☑ No

☐ Slab ☑ Crawl Space ☐ Basement w/plumbing ☐ Basement wo/plumbing

☑ House/Mod. Home No. Bedrooms 3

☐ Mobile Home No. Bathrooms 3

☐ Business No. Employees ____

☐ Other ____


Water Supply: ☑ Individual ☐ Community ☐ Public

Comments: SCH. 80 pipe must be placed under driveway.

14' ELEVATION - 100' 2" Supply LINE - 43GPM

Comments: * TANK LOCATIONS CHANGED TO SIDE OF HOUSE - MANIFOLD BOX SWITCHED TO OTHER SIDE OF LOT *

INITIAL SITE SKETCH

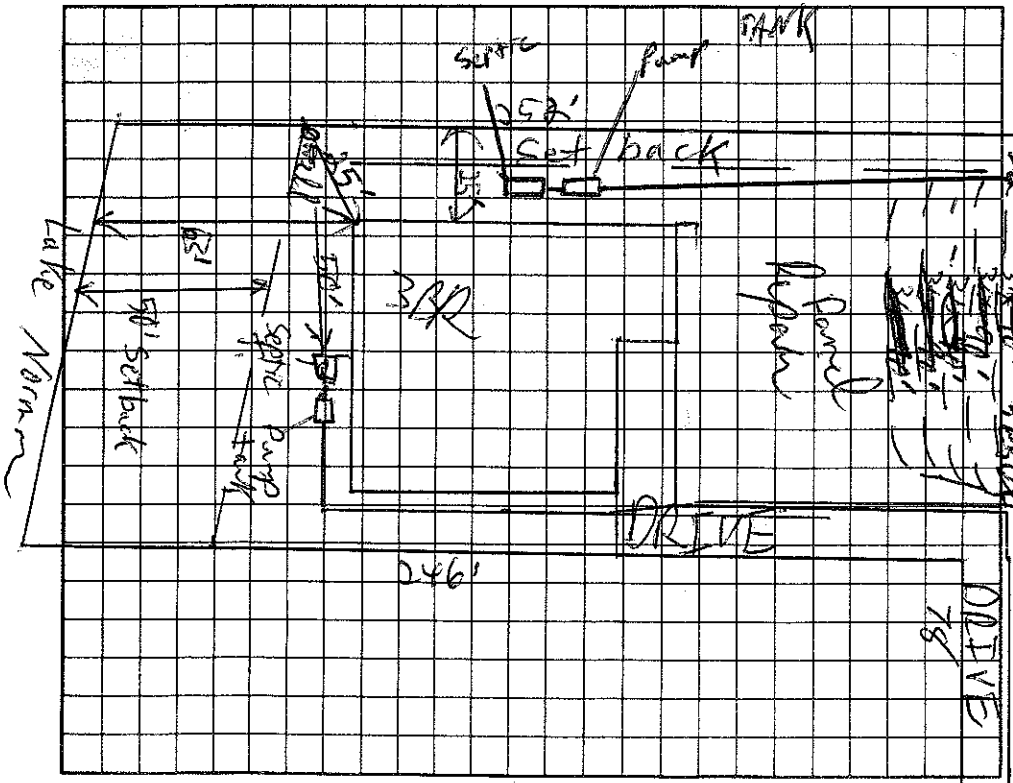


AS BUILT SKETCH

I understand that this permit can be suspended or revoked if any false information is supplied toward securing the permit/any unauthorized changes are made to the site/any unauthorized changes are made in the installation of the system.

Signed: Jerald Lee Clark

Installed by: James Hudler

Improvement Permit by: C. Brad Freeman EHST date 4/12/96

Existing System Inspection by: C. Brad Freeman EHST date 4/12/96

Certificate of Completion by: _____ date _____

Operation Permit by: C. Brad Freeman date 6/10

HEALTH DEPT. COPY: WHITE INSPECTION COPY (FINAL): GREEN OWNER COPY (FINAL): YELLOW INSPECTION COPY (INITIAL): PINK OWNER COPY (INITIAL): GOLD

Authorization to Construct is valid for 60 months from issue date.