IREDELL COUNTY HEALTH DEPARTMENT

STATESVILLE 704-878-5305 MOORESVILLE 704-664-5281

IMPROVEMENT PERMIT / CERTIFICATE OF COMPLETION / OPERATION PERMIT / EXISTING SYSTEM INSPECTION

PROPERTY DESCRIPTION NO. 2164 DATE July 21 '95 TAX MAP NO. 2C2B5 4624 89 2690 Watershed: ☑ Yes ☐ No

OWNER OR CONTRACTOR Blaine P. Segal / Randy White PHONE: Business _____ Home 663 3198 W54

ADDRESS 656 Catawba Ridge Mooresville NC

LOCATION Brawley School Rd TR Yacht Rd TR Sterling Oaks Lane TL in cul-D-Sac

SUBDIVISION Yacht Shores BLOCK / SECTION 1 LOT 5 LOT AREA 1.17ac SITE CLASS. B5 DESIGN FLOW 360gpd L.T.A.R. .03

Septic Tank: 1000 Gallons; STB 794 Date 5/30/96

Pump Tank: 1000 Gallons; PT 27 Date 6/12/96

Pump Make: Liberty Model LE51A Serial No. 1370

Nitrification Field: No Fields 1 Square Feet 900 Linear Feet 300

No Lines 5 Trench Width 36" Max Trench Bottom Depth 36" Gravel Depth NA

☑ New System ☐ Repair System Type: I, II, III, IV, V, VI

System Description: pumped/gravity w/ 1 heater

Repair System Description: pumped INF / conv.

Maintenance Agreement Required: ☐ Yes ☐ No

☐ House/Mod. Home No. Bedrooms 3

☐ Mobile Home No. Bathrooms 3

☐ Business No. Employees ____

☐ Other ____

☐ Slab ☑ Crawl Space ☐ Basement w/plumbing ☐ Basement wo/plumbing

Water Supply: ☑ Individual ☐ Community ☐ Public

Comments:


~ 1:50

Comments:

cul-D-Sac Sterling Oak Lane

INITIAL SITE SKETCH

AS BUILT SKETCH

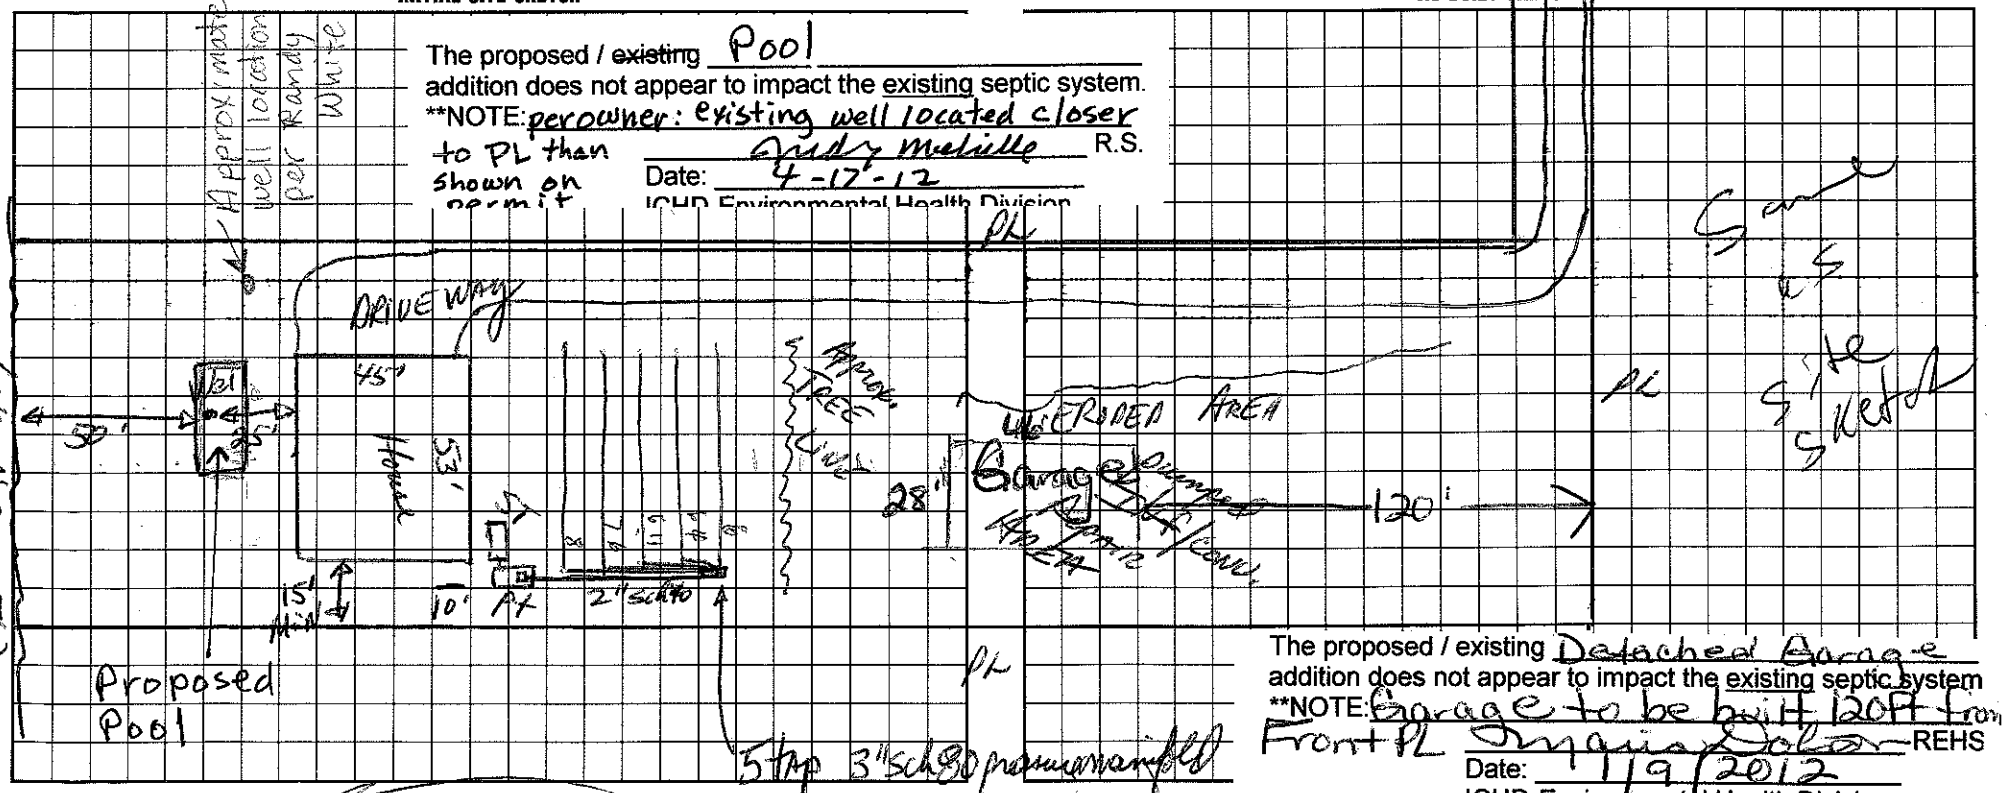

I understand that this permit can be suspended or revoked if any false information is supplied toward securing the permit/any unauthorized changes Improvement Permit is valid for 60 months from date of issuance.

Signed: _____

Improvement Permit by: _____ date 7-21-95

Existing System Inspection by: _____ date _____

Installed by: Tim Ammons

Certificate of Completion by: _____ date _____

Operation Permit by: _____ date 8/6/96

HEALTH DEPT. COPY: WHITE INSPECTION COPY (FINAL): GREEN OWNER COPY (FINAL): YELLOW INSPECTION COPY (INITIAL): PINK OWNER COPY (INITIAL): GOLD