IREDELL COUNTY HEALTH DEPARTMENT

...SVILLE 704-878-5305 MOORESVILLE 704-664-5281

IMPROVEMENT PERMIT / CERTIFICATE OF COMPLETION / OPERATION PERMIT / EXISTING SYSTEM INSPECTIO

PROPERTY DESCRIPTION NO. 21469 DATE 7/20/95 TAX MAP NO. 2C 2 B 6

OWNER OR CONTRACTOR Hopkins & Hopkins Const. PHONE: Business 875-0480 Home Watershed: ☒ Yes ☐ No

ADDRESS PO Box 682 Huntersville, NC. 28078

LOCATION Brawley Sch. TL on Yacht Rd. TR on Sterling Oak Rd to culdesac (5) off corner

SUBDIVISION Yacht Shores BLOCK / SECTION II LOT 6 LOT AREA 40,138 FT² SITE CLASS. DS DESIGN FLOW 360 L.T.A.R. .3

Septic Tank: 1000 Gallons; STB 794 Date 10/2/95

Pump Tank: 1000 Gallons; PT 27 Date 10/2/95

Pump Make: HYDROMATIC Model SP40 Serial No. 51814-0004

Nitrification Field: No Fields 1 Square Feet 1200 Linear Feet 200 ✱

No Lines 5 Trench Width 24" Max Trench Bottom Depth 36"

☒ New System ☐ Repair System Type: I, II, III, (IV) V, VI

System Description: Pressure - Panel

Repair System Description: Same

Maintenance Agreement Required: ☒ Yes ☐ No

Gravel Depth 6" SAND ☐ Slab ☒ Crawl Space ☐ Basement w/plumbing ☐ Basement wo/plumbing

☒ House/Mod. Home No. Bedrooms 3

☐ Mobile Home No. Bathrooms 2.5

☐ Business No. Employees


☐ Other

Water Supply: ☒ Individual ☐ Community ☐ Public


Comments: ✱ Pressure Panel

Comments:
1/23/96 Riser not watertight
Electrical conduit too small to get cords through to NEMA 4X box.

INITIAL SITE SKETCH

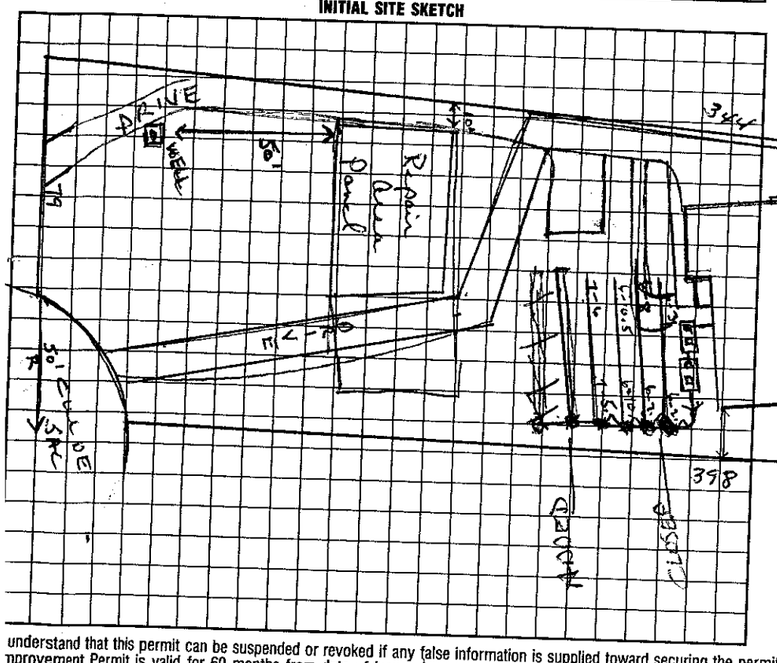

AS BUILT SKETCH

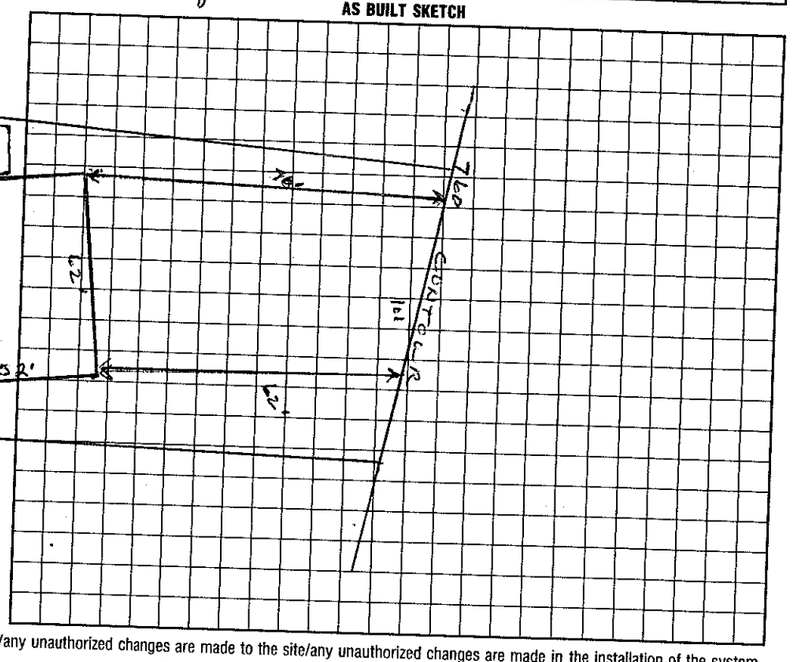

I understand that this permit can be suspended or revoked if any false information is supplied toward securing the permit/any unauthorized changes are made to the site/any unauthorized changes are made in the installation of the system. Improvement Permit is valid for 60 months from date of issuance.

Signed: _____

Improvement Permit by: Wesley Sparks R.S. date 7/20/95

Existing System Inspection by: _____ date _____

Installed by: Bob Mayhew

Certificate of Completion by: Wesley Sparks R.S. date 2/14/96

Operation Permit by: Wesley Sparks R.S. date 2/14/96

HEALTH DEPT. COPY: WHITE INSPECTION COPY (FINAL): GREEN OWNER COPY (FINAL): YELLOW INSPECTION COPY (INITIAL): PINK OWNER COPY (INITIAL): GOLD