10:30

IREDELL COUNTY HEALTH DEPARTMENT

STATESVILLE 704-878-5305 MOORESVILLE 704-664-5281

IMPROVEMENT PERMIT / AUTHORIZATION TO CONSTRUCT / OPERATION PERMIT / EXISTING SYSTEM INSPECTION

PERMIT# No-Repair PIN# 4624 89 2770 DATE 4/18/02

OWNER OR CONTRACTOR Lee + Jane Yates PHONE: Business Home

ADDRESS 125 Sterling Oak Ln. Mooresville, NC. 28117

LOCATION 1100 Tl Yacht Rd. TR Sterling Oak, L of center of culdesac

SUBDIVISION Yacht Shores BLOCK / SECTION 1 LOT 6 LOT AREA ~.9Ac SITE CLASS PS DESIGN FLOW 360 L.T.A.R. .3

Septic Tank: EXISTING Gallons; STB Date

Pump Tank: EXISTING Gallons; PT Date

Pump Make: Model Serial No.

Nitrification Field: No Fields 1 Square Feet 220 * Linear Feet 110

No Lines 2@55' Trench Width 2' Max Trench Bottom Depth 31 Gravel Depth No

☐ New System ☒ Repair System Type: I, II, III, (IV) V, VI

System Description:

Repair System Description: 16" PPBPS - LP Dist.

Maintenance Agreement Required: ☐ Yes ☐ No

☒ House/Mod. Home No. Bedrooms 3

☐ Mobile Home No. Bathrooms 2.5

☐ Business No. Employees

☐ Other


☐ Slab ☒ Crawl Space ☐ Basement w/plumbing ☐ Basement wo/plumbing

Water Supply: ☐ Individual ☐ Public ☐ Community


Comments:/Conditions: Cut 2 lowest lines off after installing 2 new lines above garage. Irrigation damaged trench sidewalls letting 2 trenches run together causing wet spot. Pressures will need to be reset -

Comments:/Conditions: * this may involve upsizing pump to satisfy increased TDH needs. New lines must be no less than 50' away from well on this site

(NOT TO ACCURATE INITIAL SITE SKETCH SCALE)

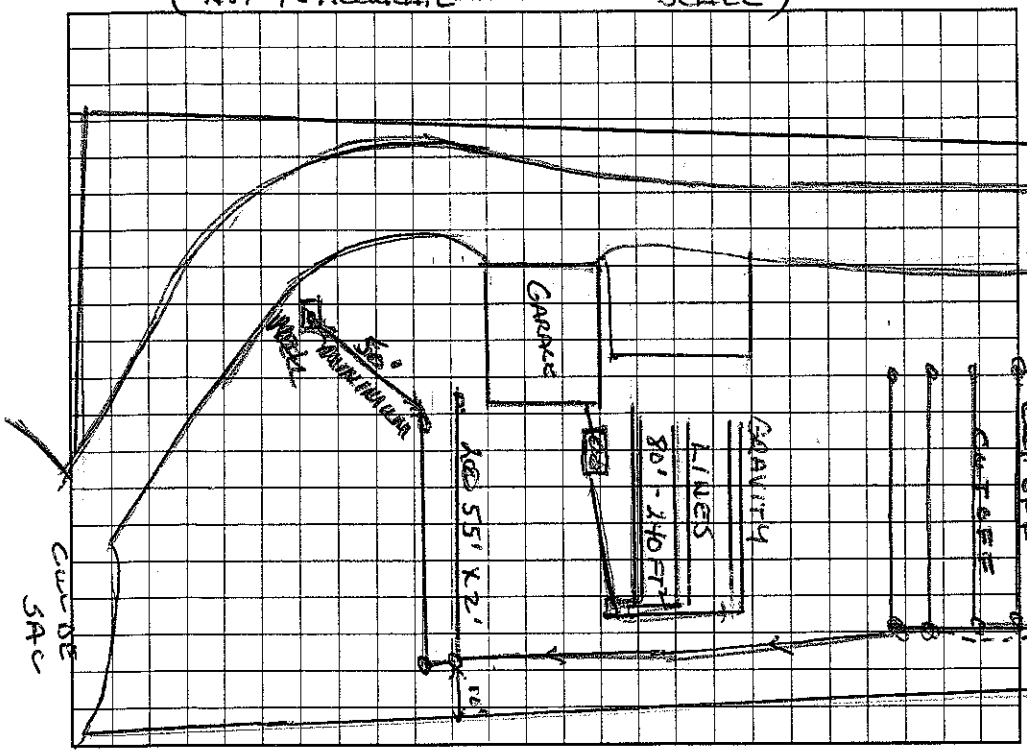

AS BUILT SKETCH

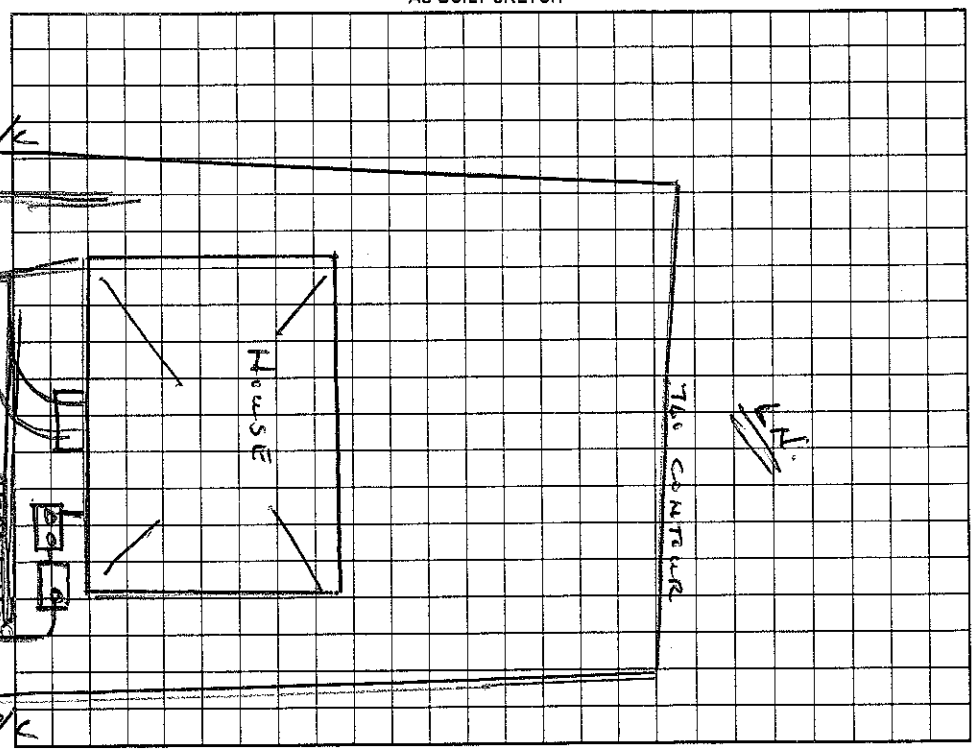

Permit can be suspended or revoked if any false information is supplied toward securing the permit/any unauthorized changes are made to the site/any unauthorized changes are made in the installation of the system. Improvement Permit with plat valid without expiration. Improvement Permit with site plan valid for sixty months. Authorization to Construct is valid for a period equal to that of Improvement Permit – not to exceed sixty months.

Signed: * Jane Yates date 4/23/02 Installed by: Larry Beam

Improvement Permit by: Wesley Sparks RS. date 4/18/02 Operation Permit by: [signature] RS date 5/24/02

Authorization to Construct by: Wesley Sparks RS. date 4/18/02 Existing System Inspection by: date

HEALTH DEPT. COPY: WHITE OWNER COPY (FINAL): YELLOW OWNER COPY (INITIAL): PINK