IREDELL COUNTY HEALTH DEPARTMENT

STATESVILLE 704-878-5305 MOORESVILLE 704-664-5281

IMPROVEMENT PERMIT / CERTIFICATE OF COMPLETION / OPERATION PERMIT / EXISTING SYSTEM INSPECTION

PROPERTY DESCRIPTION NO. 21469 DATE 7/20/95 TAX MAP NO. ~~2C~~ 2 B6 4624.89.2770 Watershed: ☒ Yes ☐ No

OWNER OR CONTRACTOR Hopkins & Hopkins Const. (Edmunson) PHONE: Business 875-0680 Home

ADDRESS PO Box 682 Huntersville NC. 28078

LOCATION Brawley Sub. TL on Yacht Rd. TR on Sterling Oak Rd. to cul de sac (L) of center

SUBDIVISION Yacht Shores BLOCK / SECTION 2 LOT 6 LOT AREA 46,138 Ft² SITE CLASS. DS DESIGN FLOW 360 L.T.A.R. .3

Septic Tank: 1000 Gallons; STB 794 Date 10/2/95

Pump Tank: 1000 Gallons; PT 27 Date 10/2/95

Pump Make: HYDROMATIC Model SP40 Serial No. 51814-000 Hw89

Nitrification Field: No Fields 1 Square Feet 1200 Linear Feet 200*

No Lines 5 Trench Width 24" Max Trench Bottom Depth 36" Gravel Depth 6" STONE

☒ New System ☐ Repair System Type: I, II, III, (IV) V, VI

System Description: Pressure - Panel

Repair System Description: Same

Maintenance Agreement Required: ☒ Yes ☐ No

☒ House/Mod. Home No. Bedrooms 3

☐ Mobile Home No. Bathrooms 2.5

☐ Business No. Employees

☐ Other


☐ Slab ☒ Crawl Space ☐ Basement w/plumbing ☐ Basement wo/plumbing

Water Supply: ☒ Individual ☐ Community ☐ Public


Comments: * Pressure Panel

Comments:
1/23/96 Riser not watertight
Electrical conduit too small to get cords through to NEMA 4X box.

INITIAL SITE SKETCH

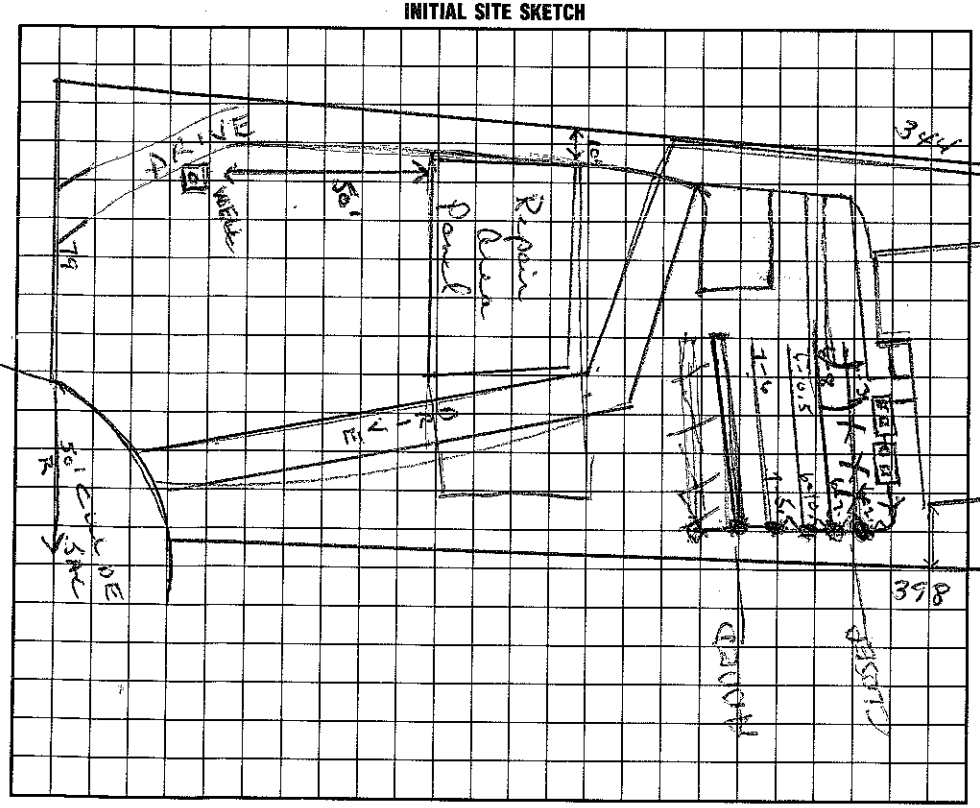

AS BUILT SKETCH

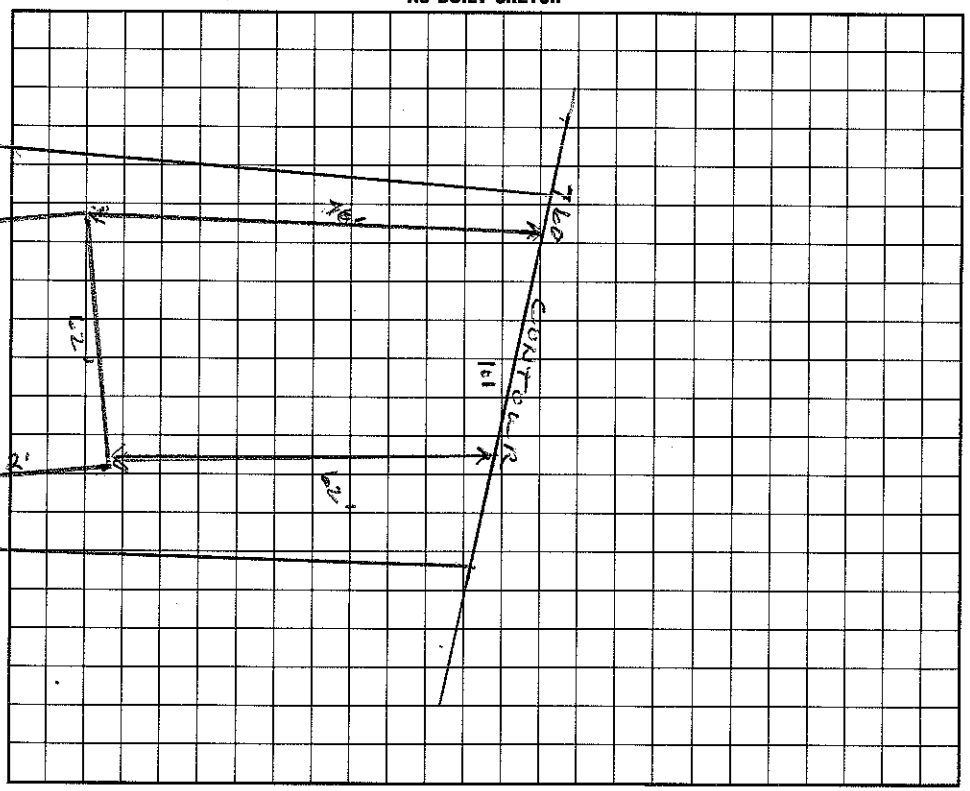

I understand that this permit can be suspended or revoked if any false information is supplied toward securing the permit/any unauthorized changes are made to the site/any unauthorized changes are made in the installation of the system. Improvement Permit is valid for 60 months from date of issuance.

Signed:

Improvement Permit by: Wesley Sparks RS. date 7/20/95

Existing System Inspection by: date

Installed by: Bob Mayhew

Certificate of Completion by: Wesley Sparks RS. date 2/14/96

Operation Permit by: Wesley Sparks RS date 2/14/96

HEALTH DEPT. COPY: WHITE INSPECTION COPY (FINAL): GREEN OWNER COPY (FINAL): YELLOW INSPECTION COPY (INITIAL): PINK OWNER COPY (INITIAL): GOLD