IREDELL COUNTY HEALTH DEPARTMENT

STATESVILLE 704-878-5305 MOORESVILLE 704-664-5281

IMPROVEMENT PERMIT / AUTHORIZATION TO CONSTRUCT / OPERATION PERMIT / EXISTING SYSTEM INSPECTION

PERMIT # 159928 PIN # 4624-89-2920 DATE 3-2-10

OWNER or APPLICANT GERALD + LOIS ZITO PHONE: Business 704-746-6054 Home: D.V. WISE INC

OWNER or APPLICANT ADDRESS PO BOX 4897 MOORESVILLE, NC 28117

LOCATION / DIRECTIONS BSR, TL YACHT, TR STERLING OAK

SUBDIVISION YACHT COVE BLOCK / SECTION LOT # 8 LOT AREA DESIGN FLOW 480 GPD L.T.A.R. .3

Septic Tank 1000 Gallons: STB 312 Date 7-16-10

Pump Tank 1000 Gallons: PT 27 Date 8-1-10

Pump Make GOULDS Model PE51M Serial # 1/2 HP

Nitrification Field No Fields 1 No Lines 4 Linear Feet 268

Trench Width 24"-36" Max. Trench Bottom Depth 36" Gravel Depth SAND ☐ GRAVITY ☒ PRESSURE

☒ New System ☐ Repair ☐ Expansion System Type I II III IV V VI

System Description: LP - PANEL BLOCK

Repair System Description: SAME

Maintenance Agreement Required ☒ YES ☐ NO

☒ Residence No. Bedrooms 4

☐ Business No. Persons

☐ Other No. Employees


☒ Crawl Space ☐ Basement w/o plumbing

Water Supply: ☒ Private ☐ Public ☐ Community

Comments / Conditions: 1) MEET ALL REQUIRED SETBACKS 2) SUPPLY LINE MUST BE 5' FROM PROP LINE & HOUSE AS WELL AS CVB 3) BE SURE OF 760' LOCATION BEFORE SETTING TANKS

Comments / Conditions

INITIAL SITE SKETCH

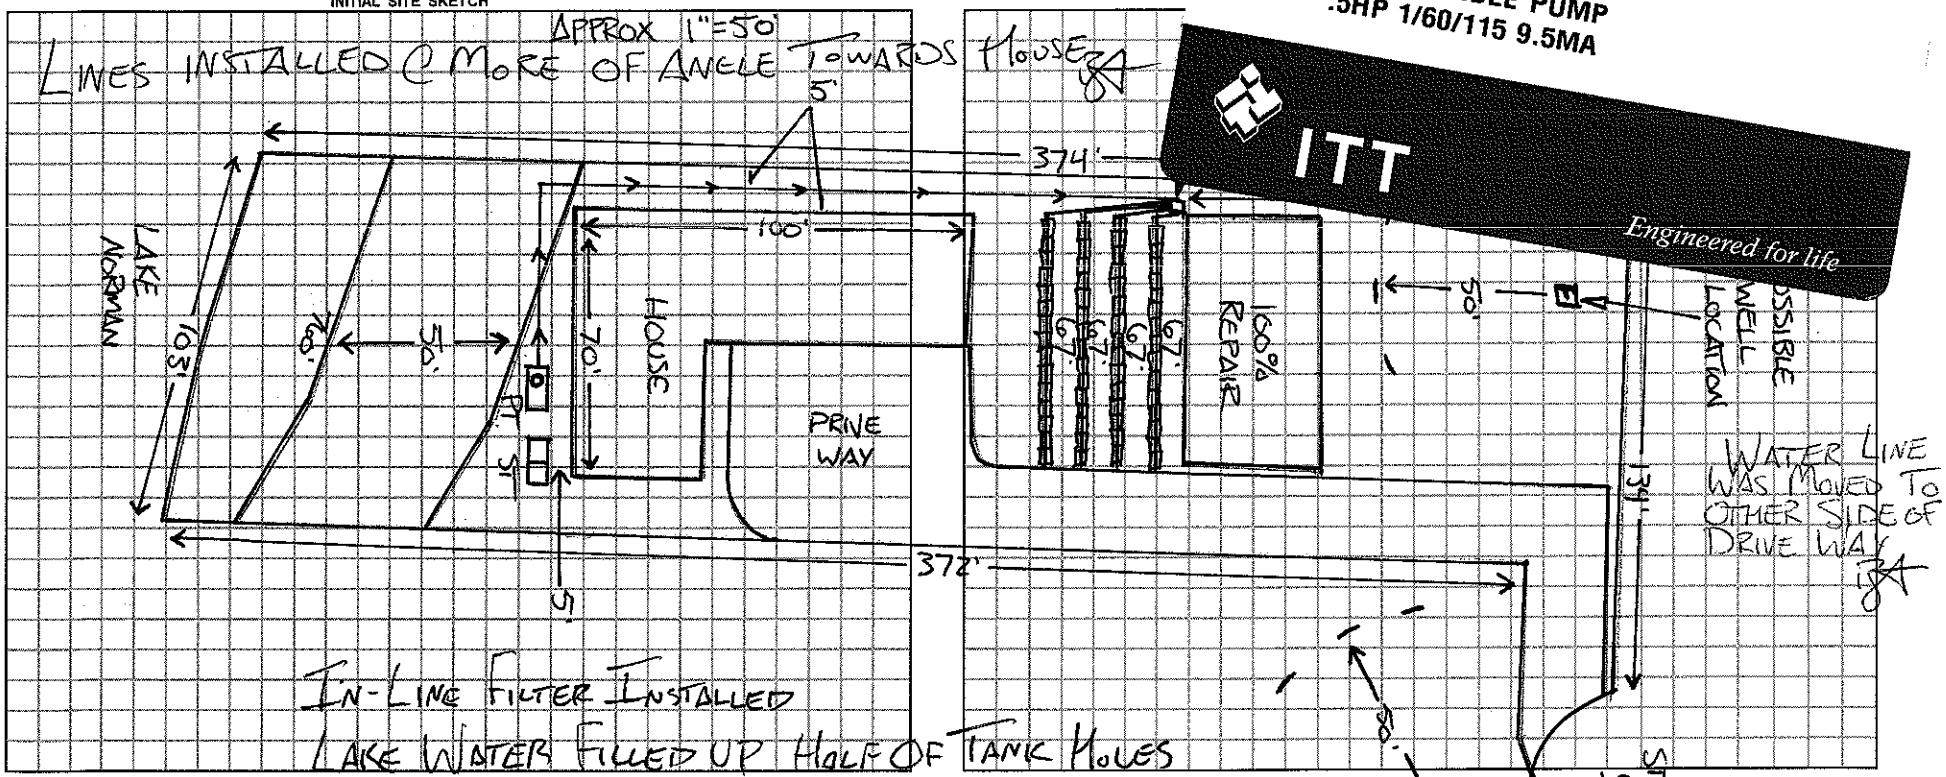

GOULDS PUMPS
PE51M
SUBMERSIBLE PUMP
.5HP 1/60/115 9.5MA
ITT
Engineered for life

Permit can be suspended or revoked if any false information is supplied toward securing the permit / any unauthorized changes are made to the site / any unauthorized changes are made in the installation of the system.

☐ *IMPROVEMENT PERMIT w / plat valid without expiration.* ☐ *IMPROVEMENT PERMIT w / site plan valid for 60 mos.* ☒ *AUTHORIZATION TO CONSTRUCT valid for period equal to IMPROVEMENT PERMIT-not to exceed 60 mo.*

Owner / Applicant Signature: [signature] Date 3/11/2010

Improvement Permit by: [signature] REHS Date 3-3-10

Authorization to Construct by: [signature] REHS Date 3-3-10

Installed by: RICHARD ABERNATHY

Operation Permit by: [signature] REHS Date: 1-27-11

Existing System Inspected by: Date:

YOU SHOULD CONTACT A LOCATOR SERVICE PRIOR TO ANY EXCAVATION.

WHITE COPY Environmental Health YELLOW COPY (Final) Owner / Applicant PINK COPY (Initial) Owner / Applicant

Gary Barnes 704-201-5506

IREDELL COUNTY HEALTH DEPARTMENT

STA[illegible] 704-878-5305 MOORESVILLE 704-664-5281

IMPROVEMENT PERMIT / AUTHORIZATION TO CONSTRUCT / OPERATION PERMIT / EXISTING SYSTEM INSPECTION

PERMIT# 10263720 PIN# 4624 89 2840 DATE 9/12/01

OWNER OR CONTRACTOR James A. McLeod PHONE: Business Home 216-248-1117

ADDRESS 21133 Chamberlain Blvd. Solon, OH 44139

LOCATION Sterling Oak Rd. Mooresville, NC. 28117

SUBDIVISION Yadkin Shores BLOCK / SECTION 1 LOT 7 LOT AREA ~1.80 AC SITE CLASS. PS DESIGN FLOW 360 L.T.A.R. .82

Septic Tank: 1000 Gallons; STB Date

Pump Tank: 1000 Gallons; PT Date

Pump Make: Model Serial No.

Nitrification Field: No Fields 1 Square Feet 600± Linear Feet 300±

No Lines 4@75' Trench Width 2' Max Trench Bottom Depth 32" Gravel Depth SAND.

☒ New System ☐ Repair System Type: I, II, III, IV

System Description: 16" PPBPS (IV)

Repair System Description: SAME

Maintenance Agreement Required: ☐ Yes ☒ No

☒ House/Mod. Home No. Bedrooms 3

☐ Mobile Home No. Bathrooms 3

☐ Business No. Employees

☐ Other


☐ Slab ☒ Crawl Space ☐ Basement w/plumbing ☐ Basement wo/plumbing

Water Supply: ☒ Individual ☐ Public ☐ Community


Comments/Conditions: TYPE IV By AWS

Comments/Conditions:

1" = 40' INITIAL SITE SKETCH

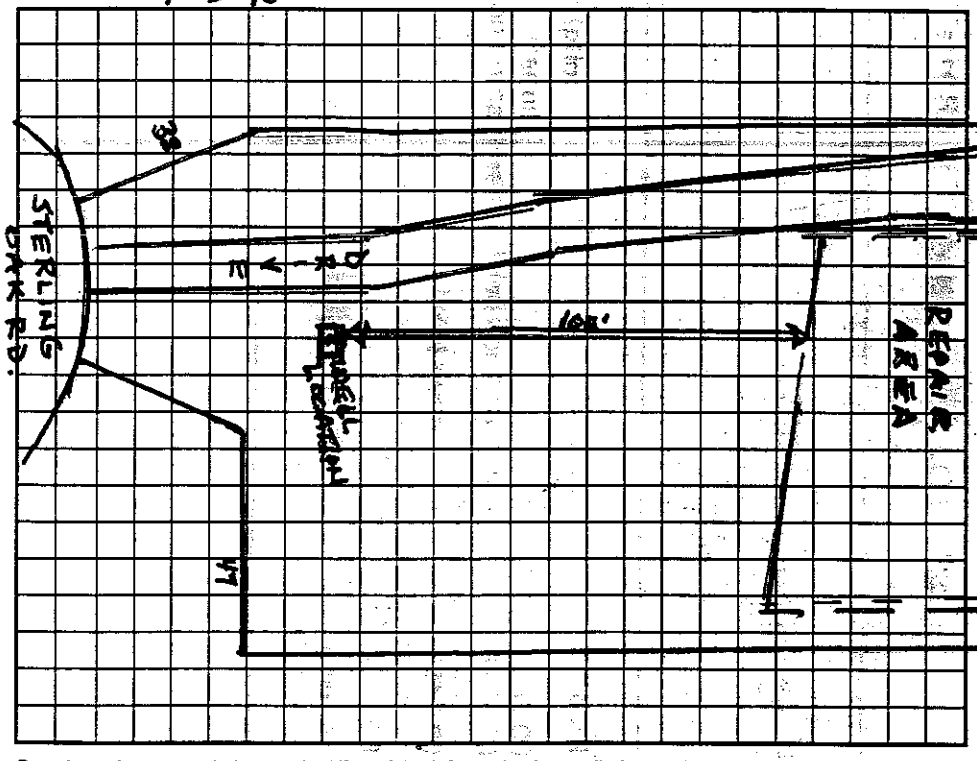

AS BUILT SKETCH

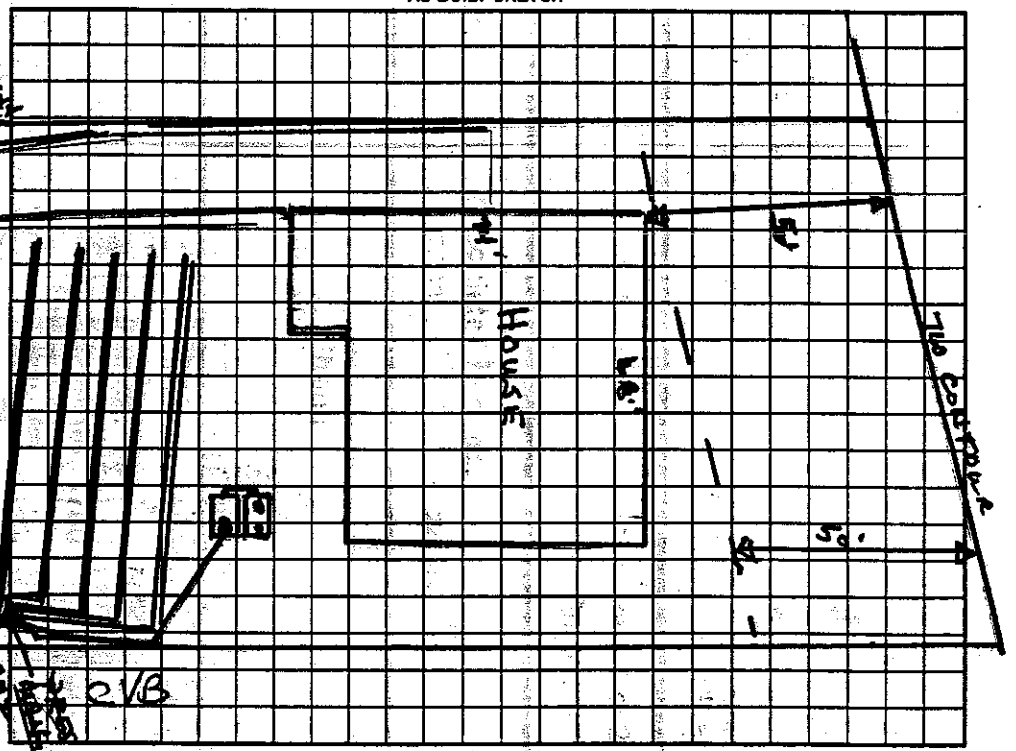

Permit can be suspended or revoked if any false information is supplied toward securing the permit/any unauthorized changes are made to the site/any unauthorized changes are made in the installation of the system. Improvement Permit with plat valid without expiration. Improvement Permit with site plan valid for sixty months. Authorization to Construct is valid for a period equal to that of Improvement Permit – not to exceed sixty months.

Signed: James A. Barnes date 9/13/01 Installed by: Tim Simmons.

Improvement Permit by: Wesley Sparks RS. date 9/12/01 Operation Permit by: [signature] RS date 6/4/02

Authorization to Construct by: Wesley Sparks RS. date 9/12/01 Existing System Inspection by: date

HEALTH DEPT. COPY: WHITE OWNER COPY (FINAL): YELLOW OWNER COPY (INITIAL): PINK

IREDELL COUNTY HEALTH DEPARTMENT

STATESVILLE 704-878-5305 MOORESVILLE 704-664-5281

IMPROVEMENT PERMIT / AUTHORIZATION TO CONSTRUCT / OPERATION PERMIT / EXISTING SYSTEM INSPECTION

PERMIT# 21051 PIN# Pt of 2c A3 4625 80 3028 DATE 7/22/98

OWNER OR CONTRACTOR Allen R. Johnston PHONE: Business 364-0421 Home

ADDRESS 6720 Cascayne Rd. Charlotte, NC. 28211

LOCATION Brawley School Rd. TL Yacht Rd. TR BAYBREEZE CT. on (L) 4th culde sac

SUBDIVISION Yacht Shores BLOCK / SECTION TT LOT 11 LOT AREA ~1.17 Ac SITE CLASS PS DESIGN FLOW 480 L.T.A.R. .35

Septic Tank: 1000 Gallons; STB 1012 Date 4-31-00
Pump Tank: 1000 Gallons; PT 1 Date 2-29-00
Pump Make: Myers Model ME 40 Serial No.
Nitrification Field: No Fields 1 Square Feet 1440 Linear Feet 480
No Lines 6 Trench Width 36" Max Trench Bottom Depth 36" Gravel Depth 12"

[X] New System [ ] Repair System Type: I, II, (III), IV, V, VI
System Description: Pres Man to Conventional
Repair System Description: Same
Maintenance Agreement Required: [ ] Yes [X] No


[X] House/Mod. Home No. Bedrooms 4
[ ] Mobile Home No. Bathrooms 3.5
[ ] Business No. Employees
[ ] Other
[ ] Slab [X] Crawl Space [ ] Basement w/plumbing [ ] Basement wo/plumbing

Water Supply: [X] Individual [ ] Public [ ] Community


Comments:/Conditions:

Comments:/Conditions: Tanks, lines & pressure tested 8/1/2000
* Need All Screws on Network Box, Need to chalk where wires come into box. MD

INITIAL SITE SKETCH

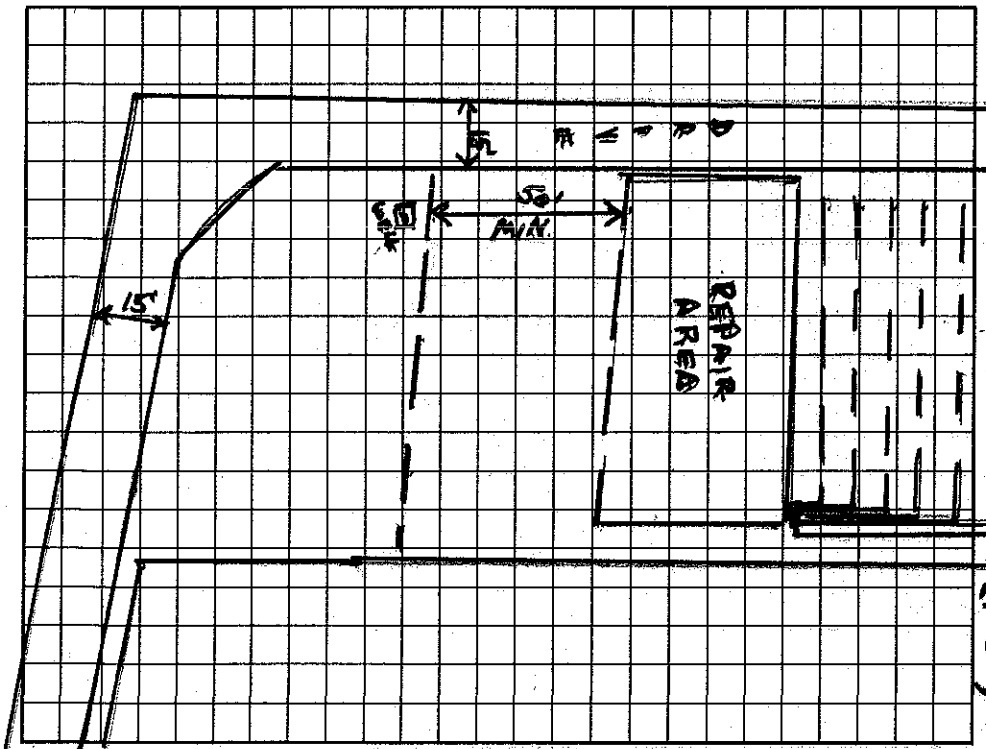

AS BUILT SKETCH

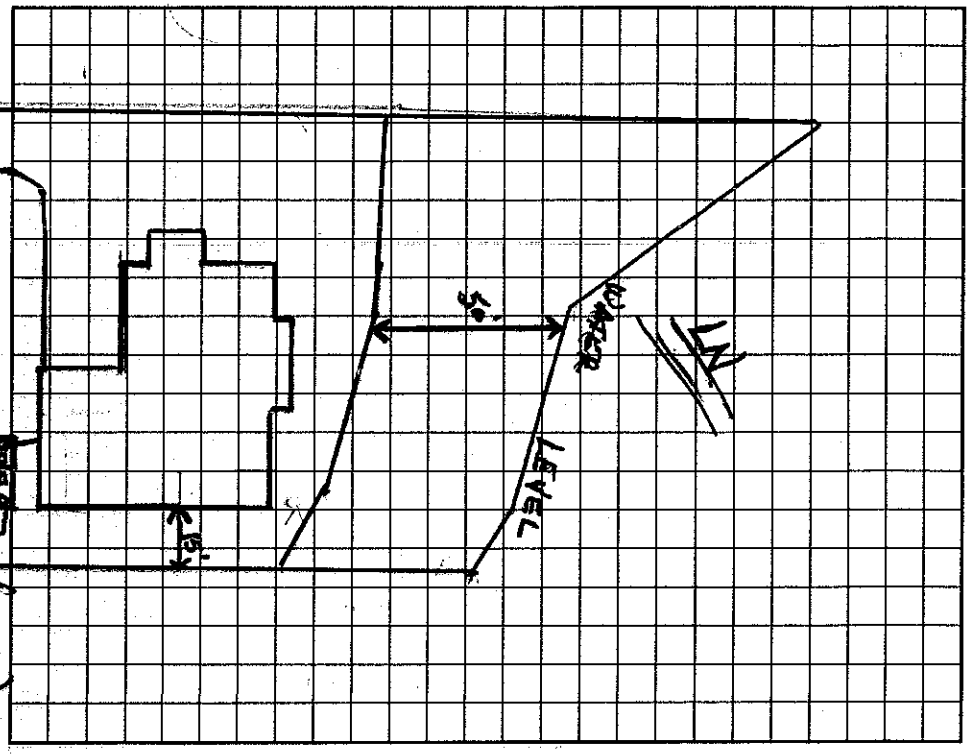

I understand that this permit can be suspended or revoked if any false information is supplied toward securing the permit/any unauthorized changes are made to the site/any unauthorized changes are made in the installation of the system. Improvement Permit with plat valid without expiration. Improvement Permit with site plan valid for sixty months. Authorization to Construct is valid for a period equal to that of Improvement Permit – not to exceed sixty months.

Signed: * Clay Cooper date 7/31/98
Improvement Permit by: Wesley Sparks R.S. date 7/27/98
Authorization to Construct by: Wesley Sparks R.S. date 7/27/98

Installed by: Richard Abernathy
Operation Permit by: Maria H. Thompson date 11/17/2000
Existing System Inspection by: date

HEALTH DEPT. COPY: WHITE INSPECTION COPY (FINAL): GREEN OWNER COPY (FINAL): YELLOW INSPECTION COPY (INITIAL): PINK OWNER COPY (INITIAL): GOLD

IREDELL COUNTY HEALTH DEPARTMENT

STATESVILLE 704-878-5305 MOORESVILLE 704-664-5281

IMPROVEMENT PERMIT / CERTIFICATE OF COMPLETION / OPERATION PERMIT / EXISTING SYSTEM INSPECTION

PROPERTY DESCRIPTION NO. 21776 DATE July 21, '95 TAX MAP NO. 2C2B8 Watershed: ☑ Yes ☐ No

OWNER OR CONTRACTOR Gerald & Lois Zito PHONE: Business _____ Home _____ WS4

ADDRESS % Lake Norman Realty 522 River Hwy Mooresville

LOCATION Langley Sch Rd. to Yacht Rd to Sterling Oak Ln. on Right in cul-de-sac

SUBDIVISION Yacht Shores BLOCK / SECTION 1 LOT 8 LOT AREA 21124.375' SITE CLASS B DESIGN FLOW 480 gpd L.T.A.R. .05

Septic Tank: 1000 Gallons; STB _____ Date _____

Pump Tank: _____ Gallons; PT _____ Date _____

Pump Make: _____ Model _____ Serial No. _____

Nitrification Field: No Fields 2 Square Feet _____ Linear Feet 270

No Lines 4+4 Trench Width 24" Max Trench Bottom Depth 36"

☑ New System ☐ Repair System Type: I, II, III, IV, V, VI

System Description: Gravity Pipes

Repair System Description: Conv.

Maintenance Agreement Required: ☐ Yes ☑ No

☑ House/Mod. Home No. Bedrooms 4

☐ Mobile Home No. Bathrooms 4

☐ Business No. Employees _____

☐ Other _____


Gravel Depth N/A ☐ Slab ☑ Crawl Space ☐ Basement w/plumbing ☐ Basement wo/plumbing

Water Supply: ☐ Individual ☑ Community ☐ Public


Comments:

Comments:

INITIAL SITE SKETCH

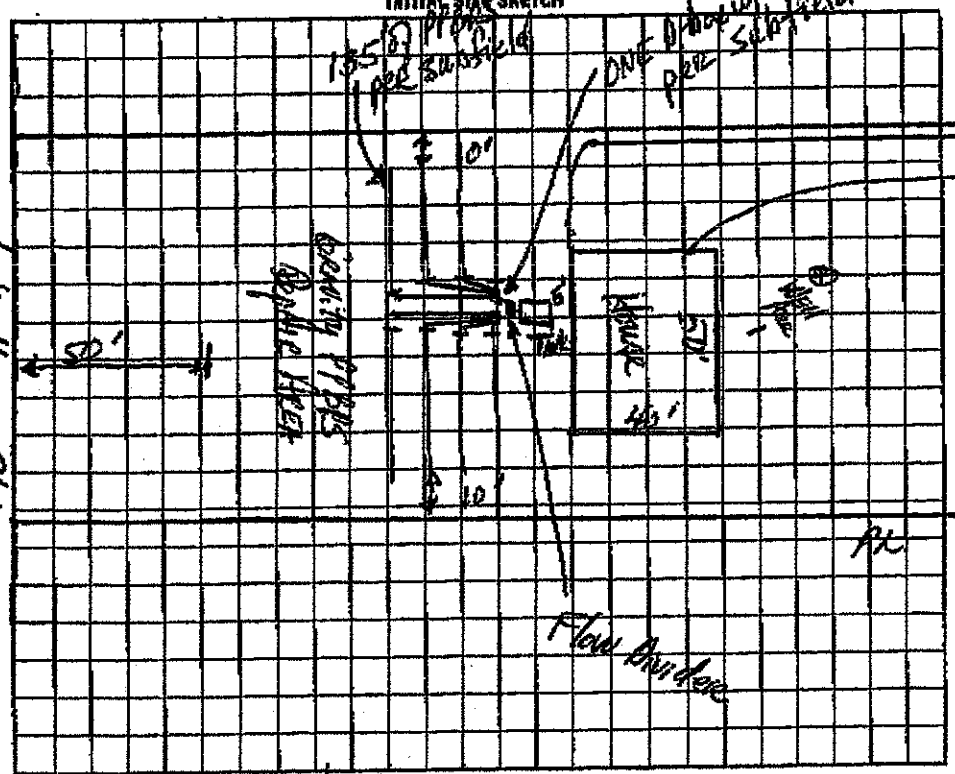

AS BUILT SKETCH

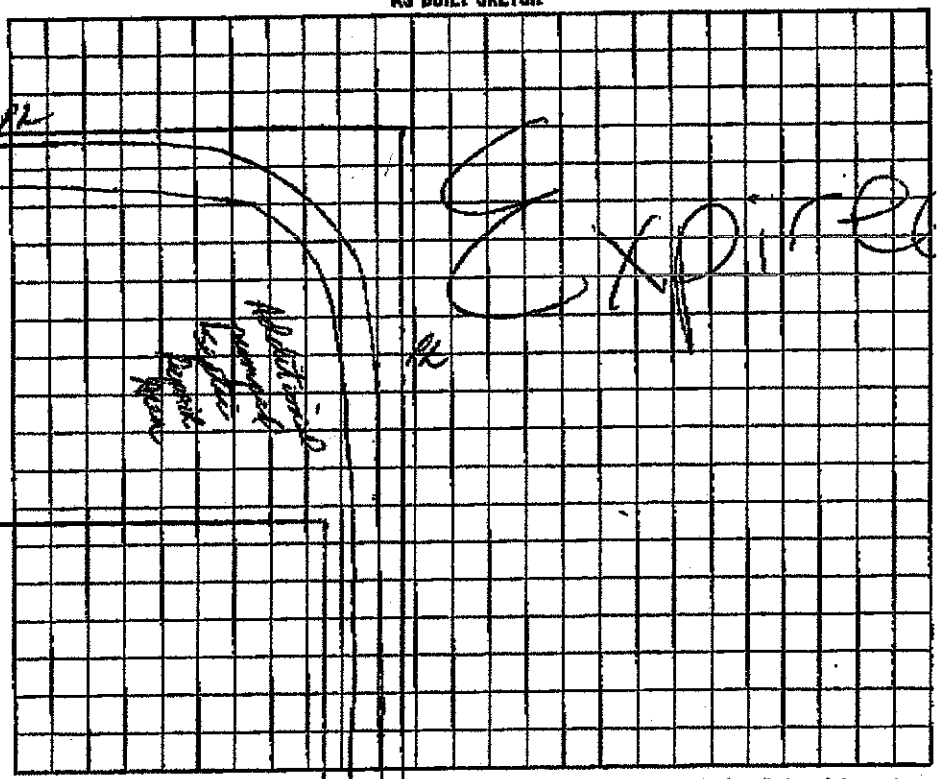

I understand that this permit can be suspended or revoked if any false information is supplied toward securing the permit/any unauthorized changes are made to the site/any unauthorized changes are made in the installation of the system. Improvement Permit is valid for 60 months from date of issuance.

Signed: X

Improvement Permit by: [signature] date 7-21-95

Existing System Inspection by: _____ date _____

Installed by: _____

Certificate of Completion by: _____ date _____

Operation Permit by: _____ date _____

HEALTH DEPT. COPY: WHITE INSPECTION COPY (FINAL): GREEN OWNER COPY (FINAL): YELLOW INSPECTION COPY (INITIAL): PINK OWNER COPY (INITIAL): GOLD